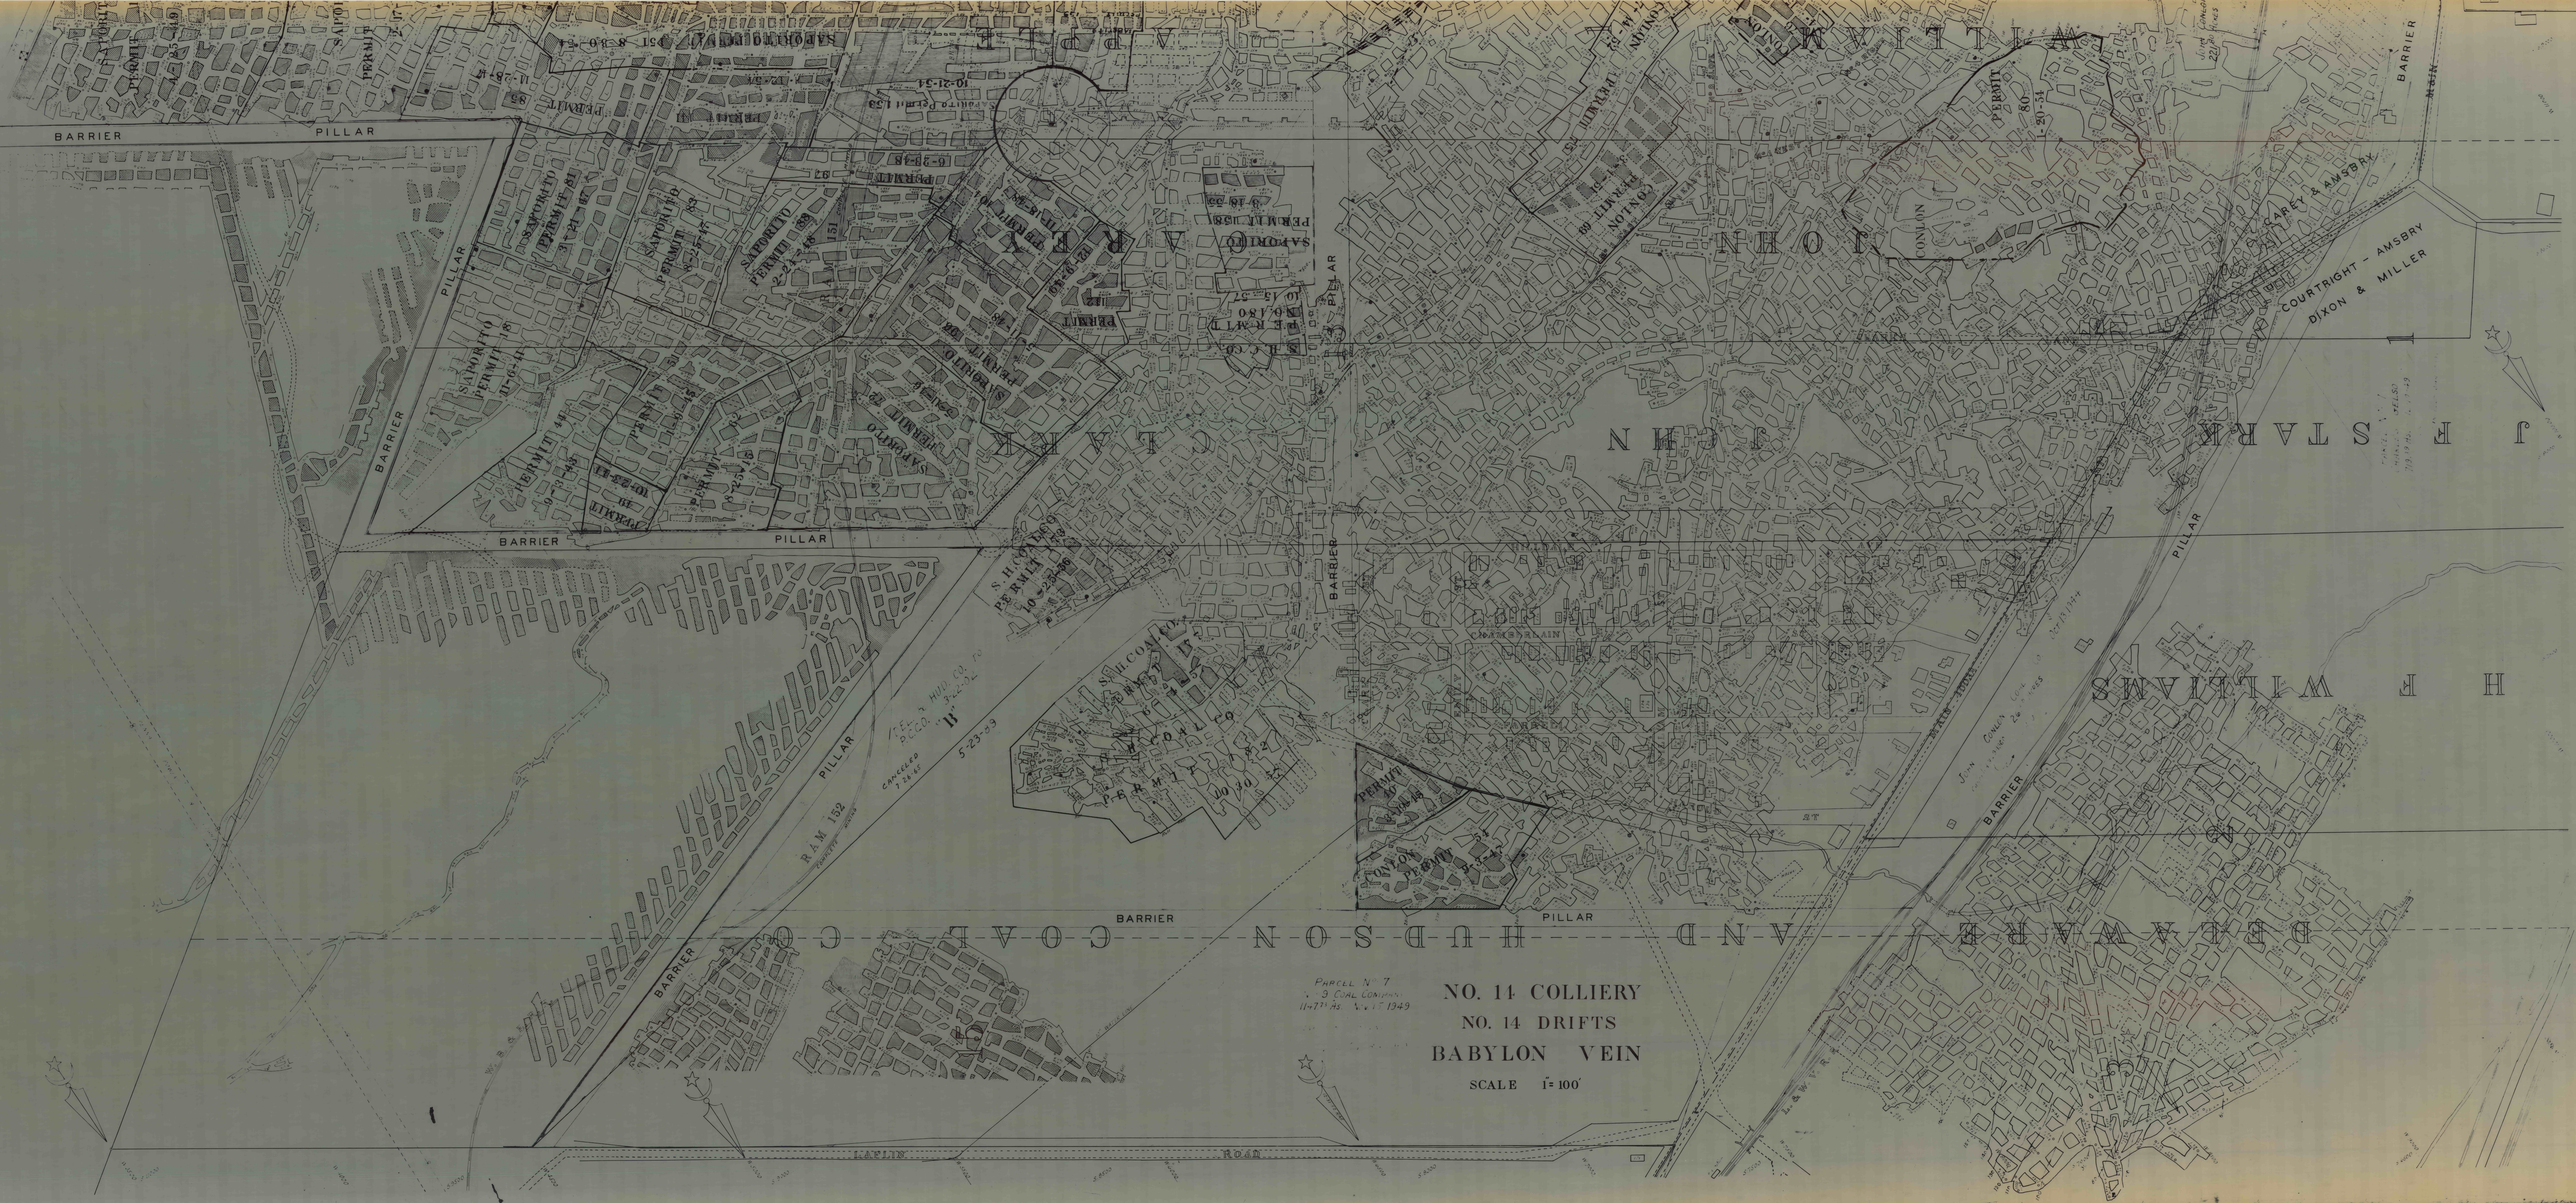
NO. 14 COLLIERY
NO. 14 DRIFTS
BABYLON VEIN
SCALE 1" = 100'
BARRIER
PILLAR
COURTRIGHT - AMSBRY
DIXON & MILLER
LARKEY & AMSBRY
J. F. STARR
H. F. WILLIAMS
BELLAWARE AND HUDSON COAL CO.
LAPLE
CLARK
JOHN
WILLIAM
R.A.M. 152
LAPLE ROAD
PARCEL No. 7
9 COAL COMPANY
11-7-48 to 1-1-1949