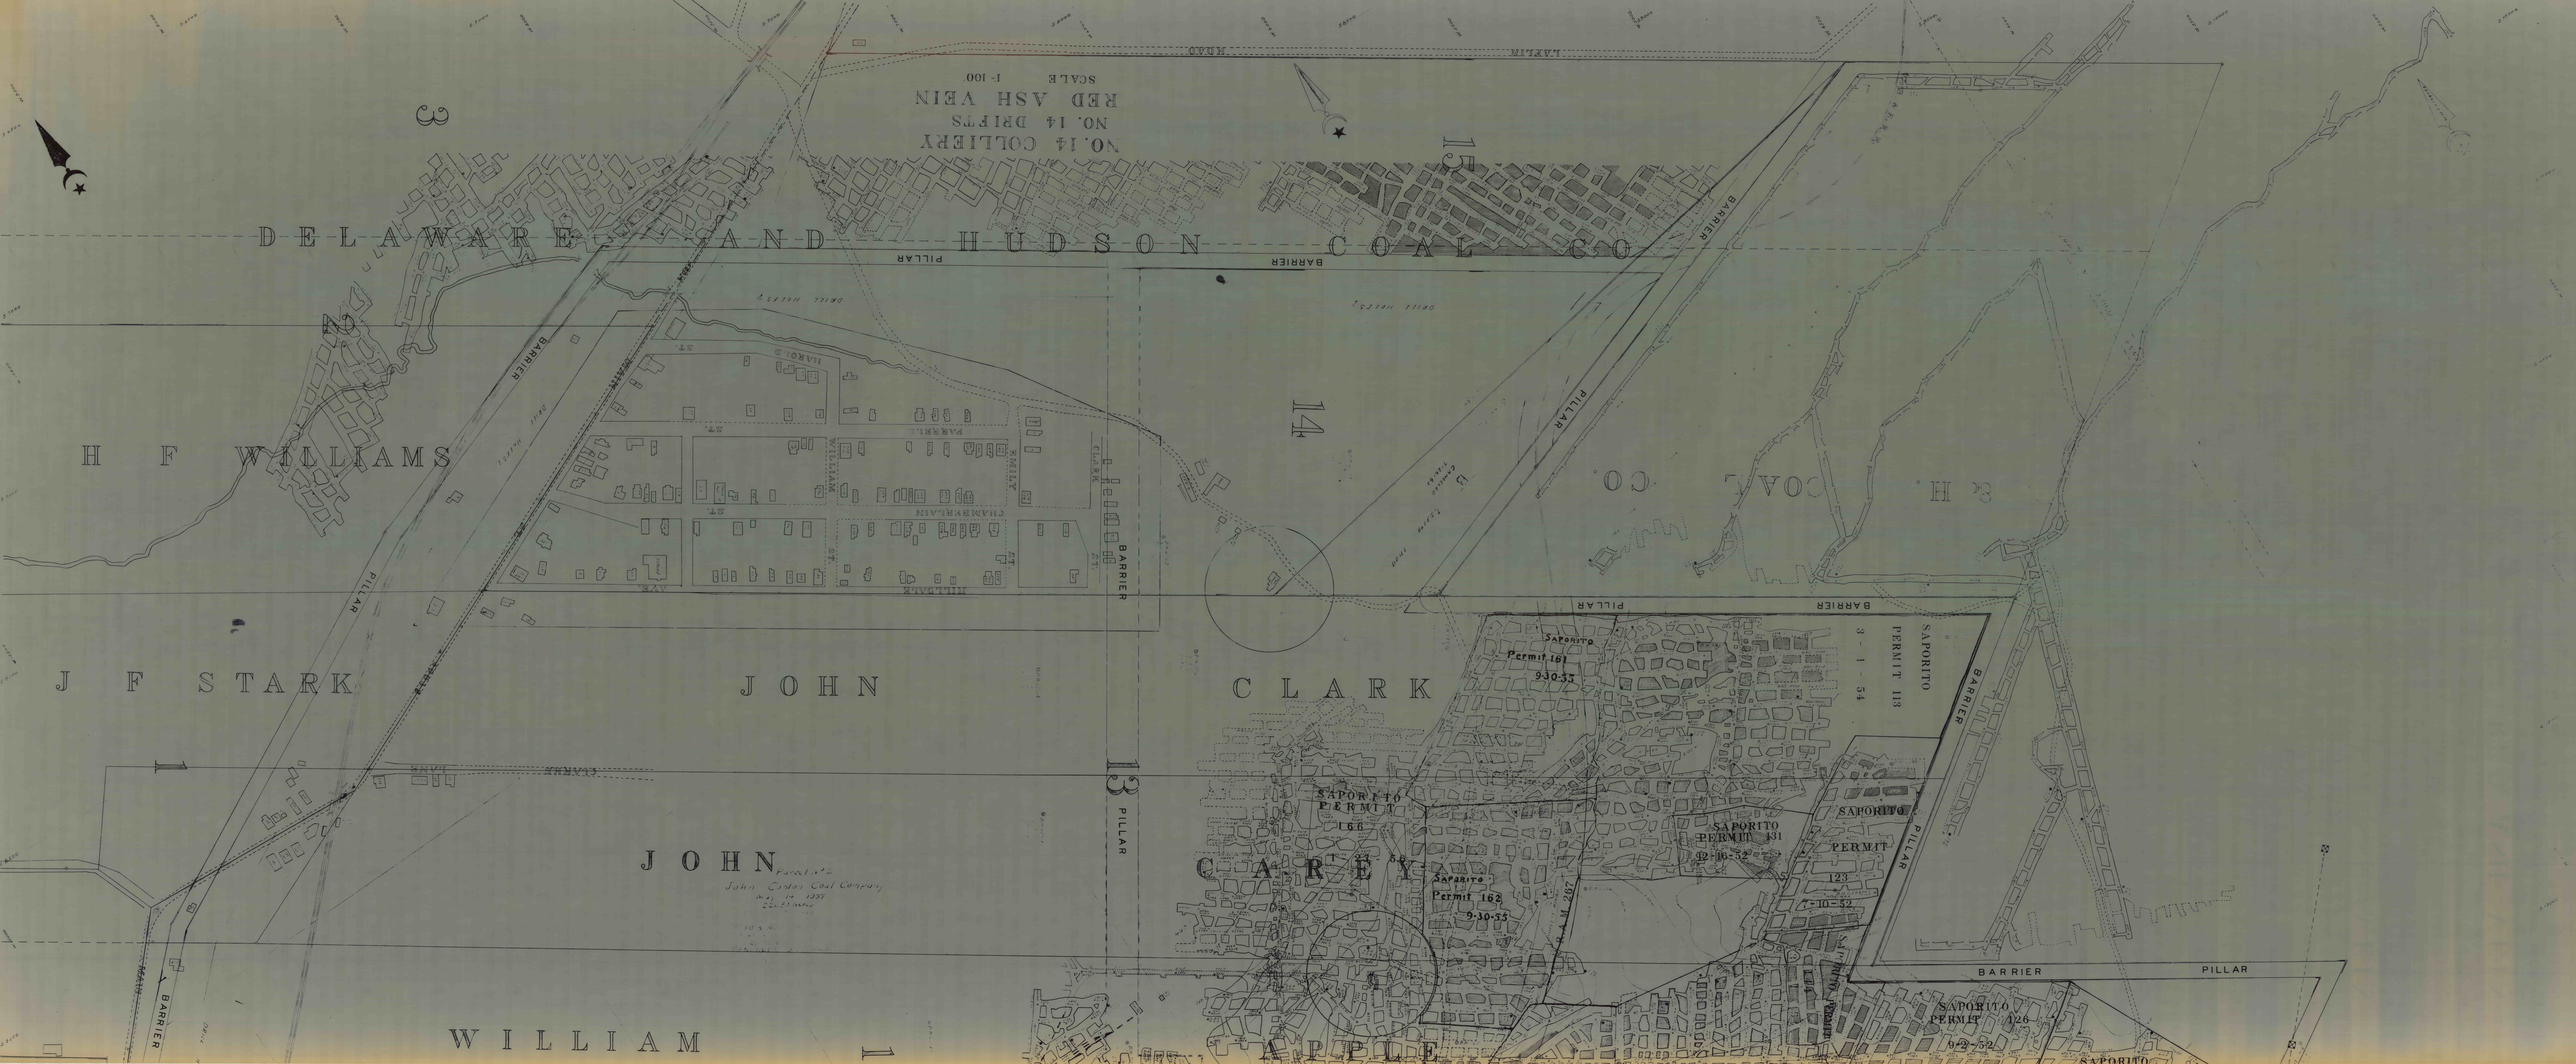
DELAWARE AND HUDSON COAL CO
H F WILLIAMS
J F STARK
JOHN
CLARK
JOHN
CAREY
WILLIAM
APPLE
BARRIER
PILLAR
CHAMBERLAIN ST
WILLIAMS ST
CLARK ST
SAPORITO PERMIT 161 9-30-55
SAPORITO PERMIT 162 9-30-55
SAPORITO PERMIT 166
SAPORITO PERMIT 131 12-16-52
SAPORITO PERMIT 123 7-10-52
SAPORITO PERMIT 113 8-1-54
SAPORITO PERMIT 126 9-2-52
13
14
15