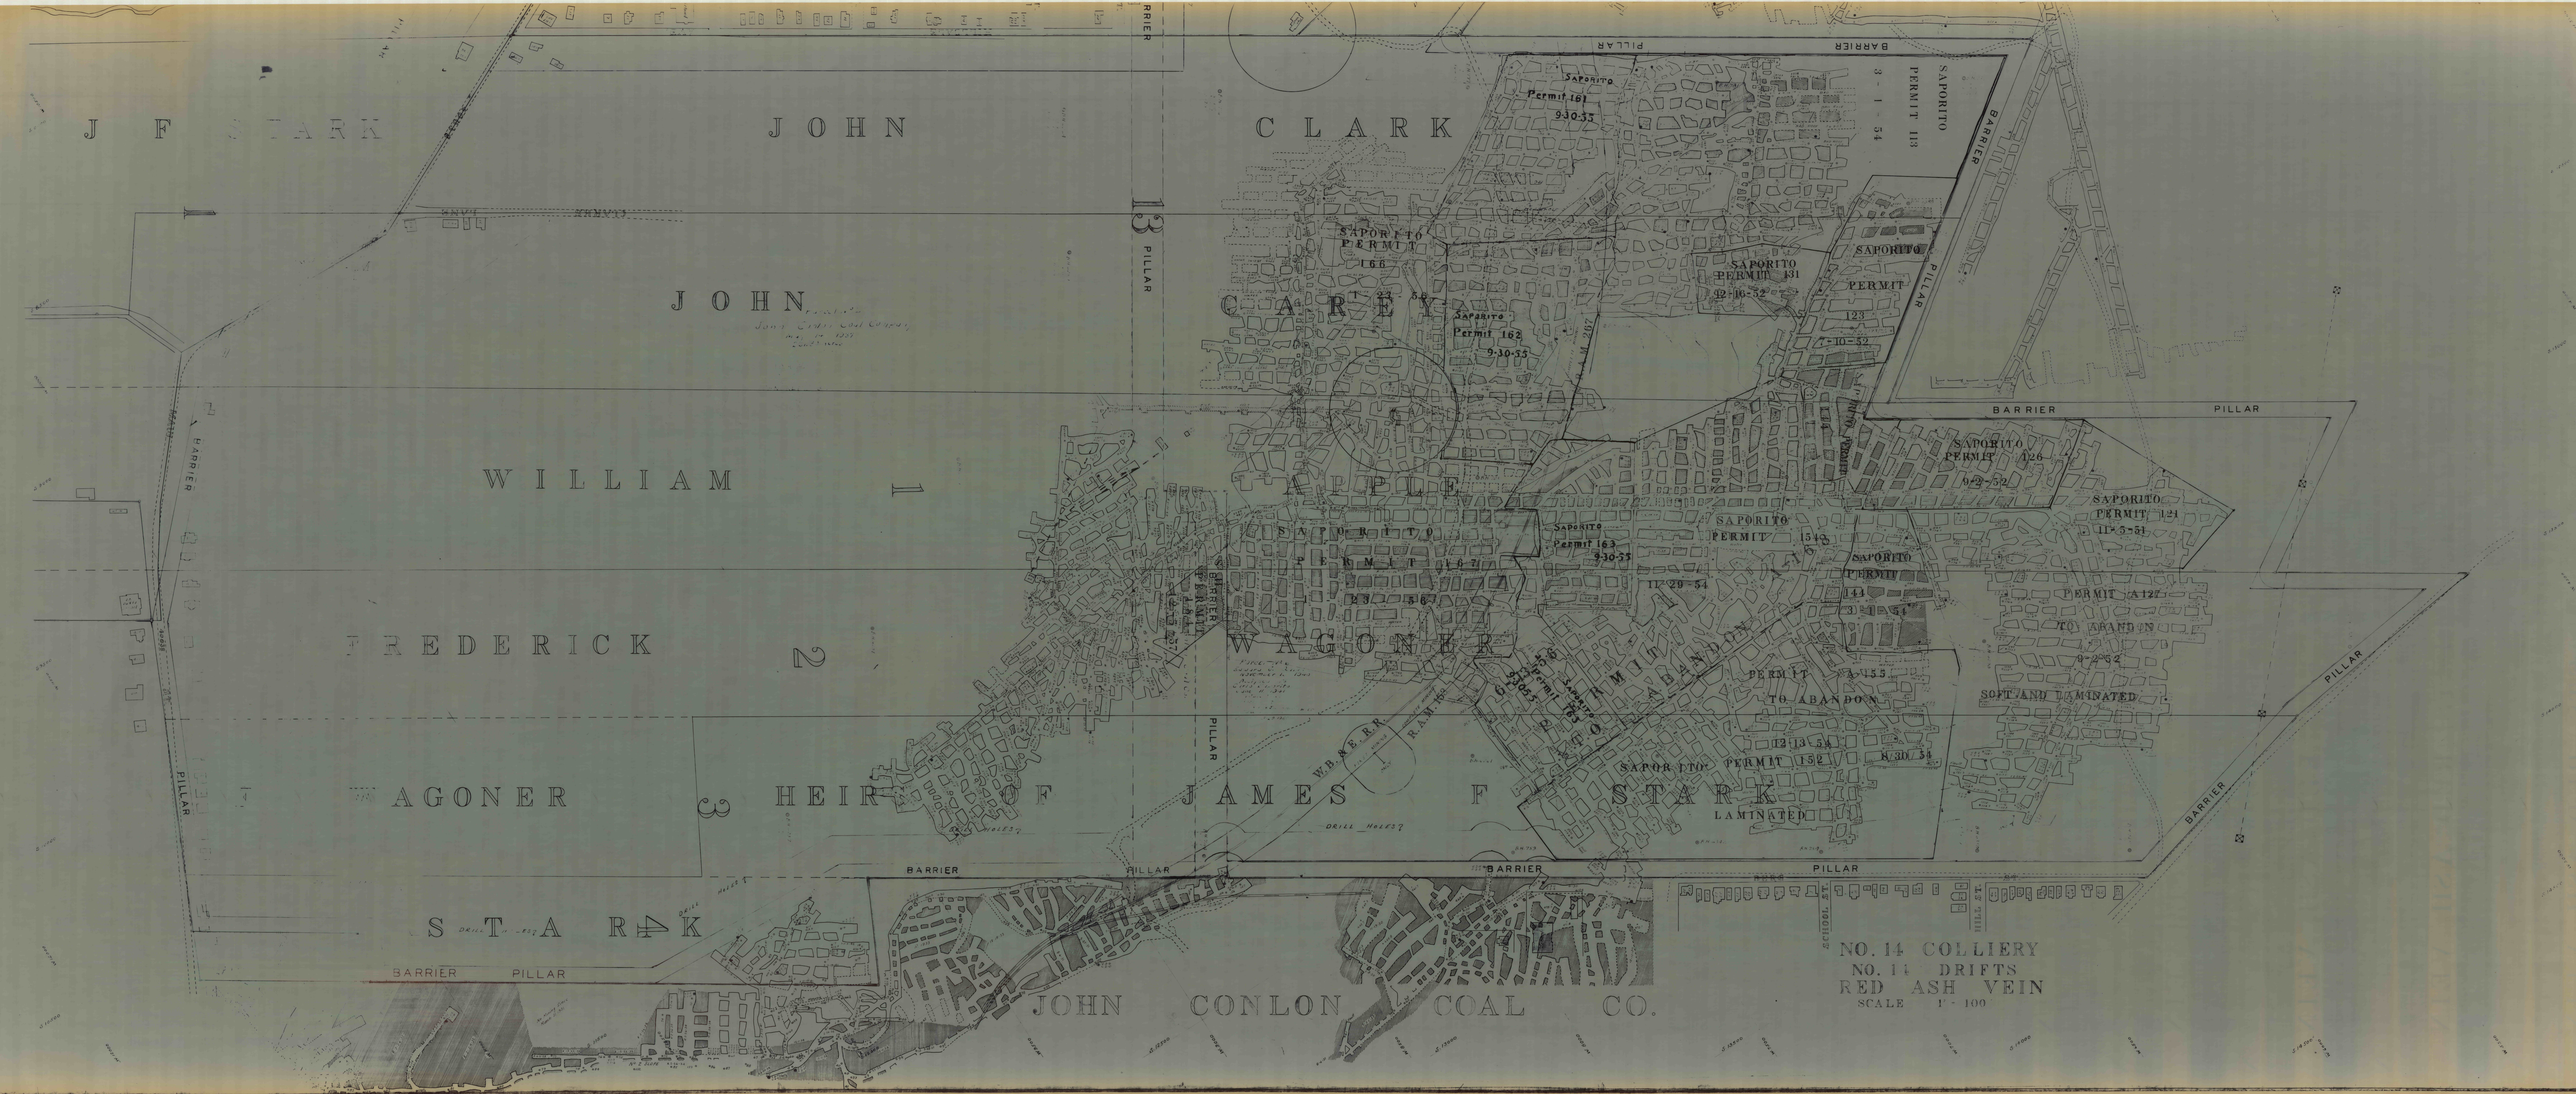
J F STARK
JOHN CLARK
JOHN CARR
WILLIAM APPLE
FREDERICK WAGONER
WAGONER HEIR OF JAMES F STARK
STARK
JOHN CONLON COAL CO.
BARRIER
PILLAR
SAPORITO PERMIT 113 3-1-54
SAPORITO Permit 161 9-30-55
SAPORITO PERMIT 166
SAPORITO Permit 162 9-30-55
SAPORITO PERMIT 131 9-10-52
SAPORITO PERMIT 123 7-10-52
SAPORITO PERMIT 167
SAPORITO Permit 163 9-30-55
SAPORITO PERMIT 154 11-29-54
SAPORITO PERMIT 141 3-1-54
SAPORITO PERMIT A26 9-2-52
SAPORITO PERMIT 121 11-5-51
PERMIT A127 TO ABANDON 9-2-52
SOFT AND LAMINATED
PERMIT A135 TO ABANDON
SAPORITO PERMIT 152 12-13-54
8-30-54
LAMINATED
W.B. & E. R.R.
DRILL HOLES
NO. 14 COLLIERY
NO. 14 DRIFTS
RED ASH VEIN
SCALE 1" = 100'