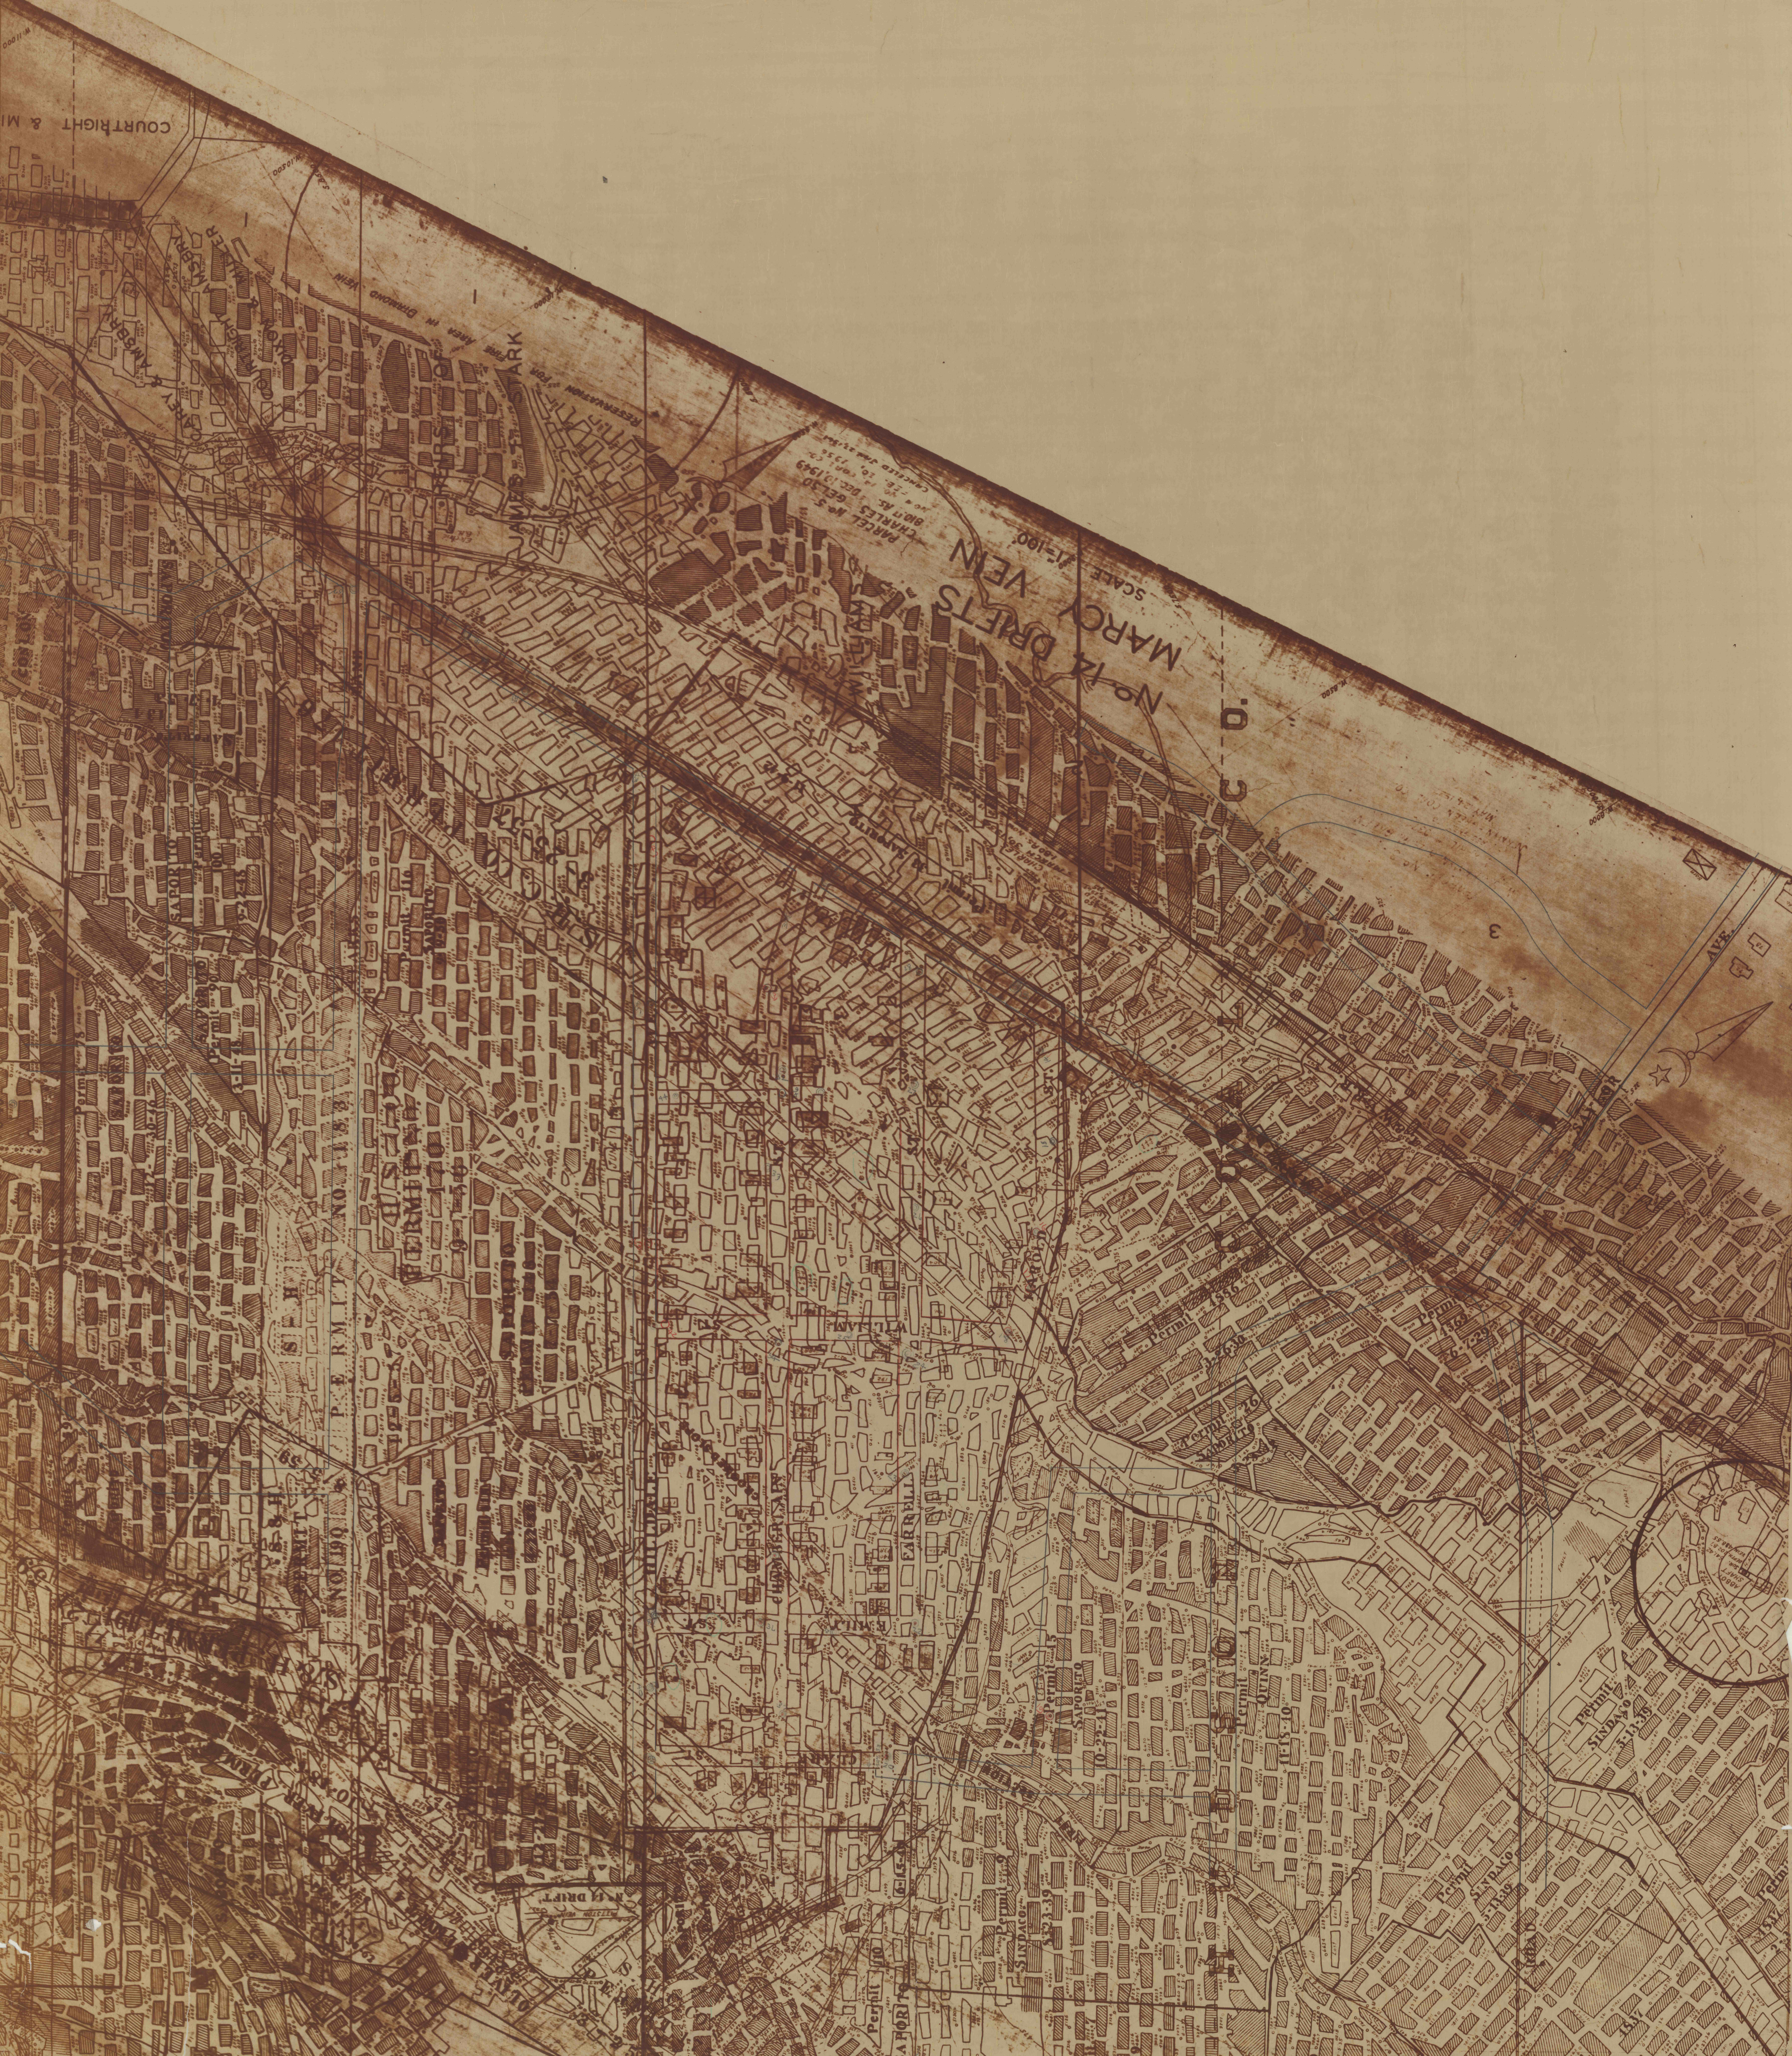

No 14 DRIFTS
MARCY VEIN
SCALE 1"=100'
PERMIT NO 183
PERMIT NO 190
Permit 4886
Permit 4369 6-7-29
Permit 3-26-30
HILLDALE
CHAMBERLAIN
FARRELL
WILLIAM
CLARK
ABBOTT SHAFT
Permit SAPORITO 10-22-41
Permit QUINN 11-18-40
Permit SINDACO 5-13-39
Permit SINDACO 8-23-39
No 14 DRIFT