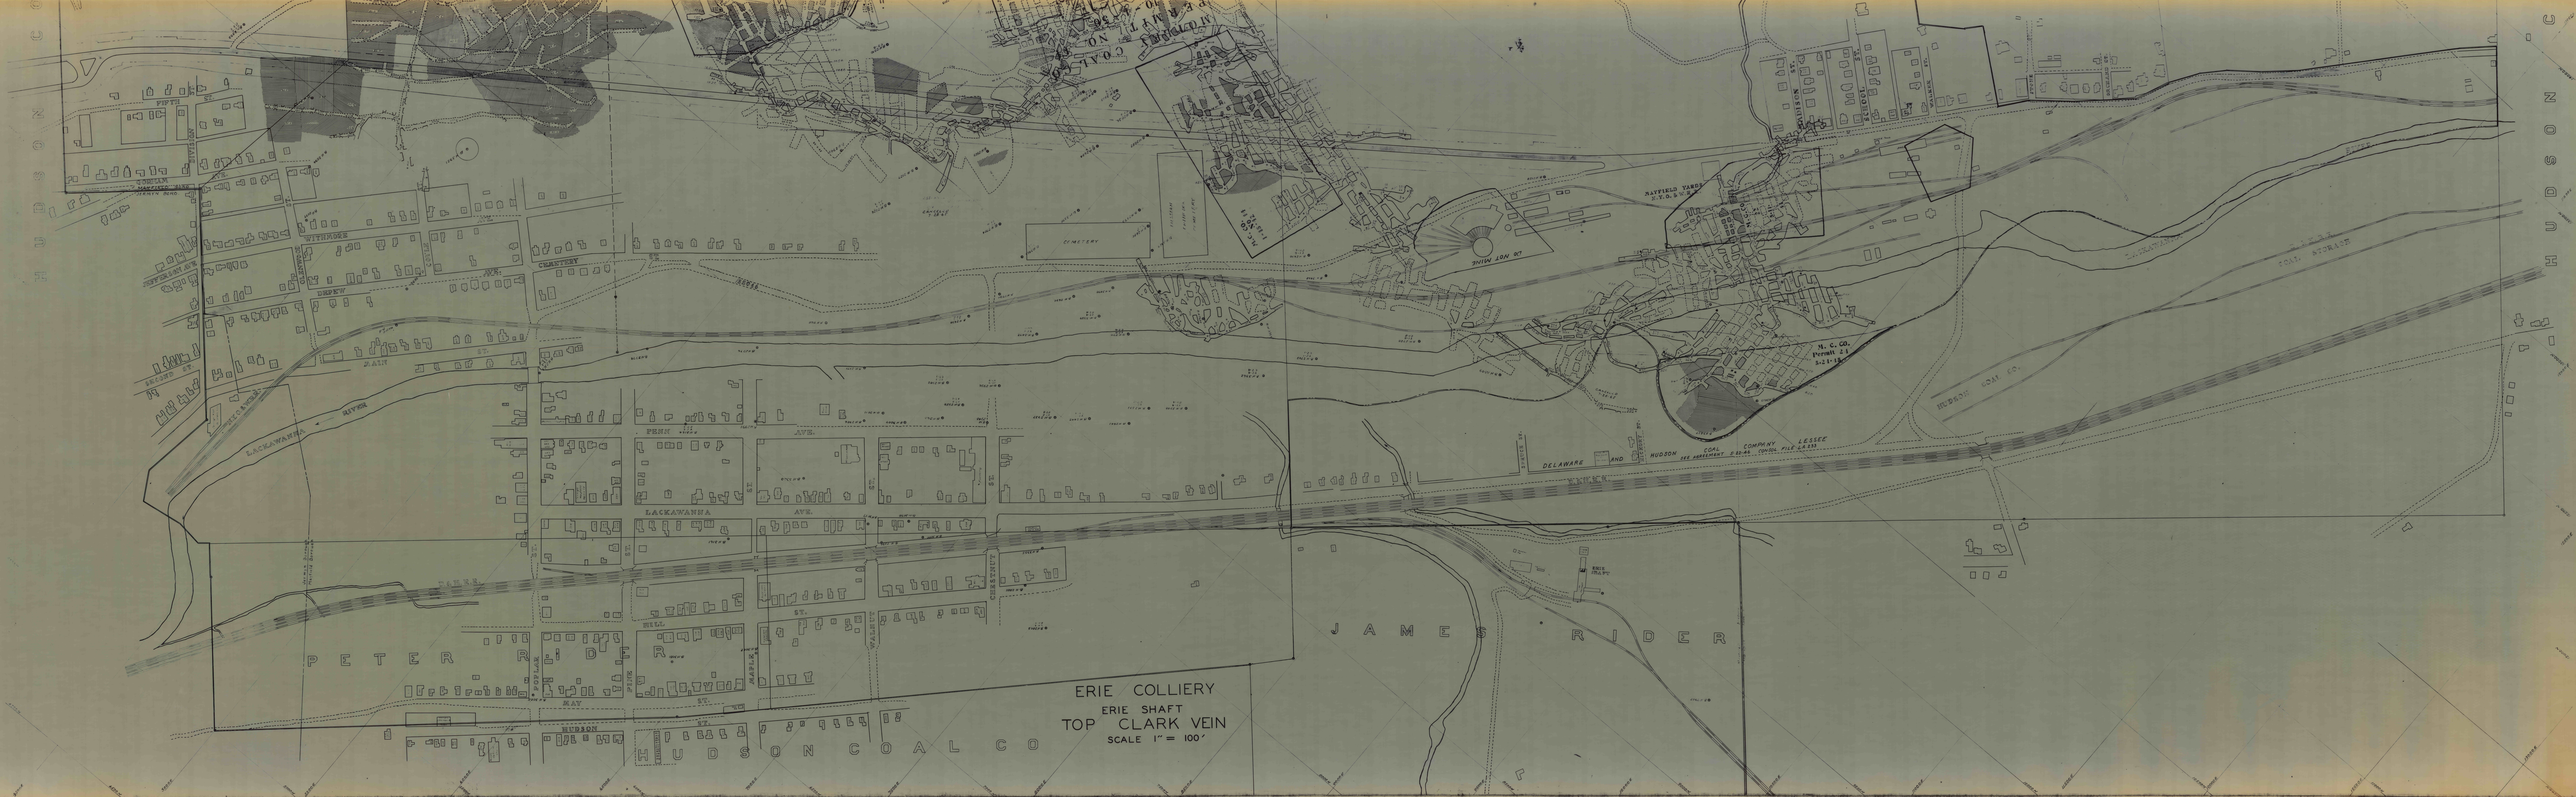
ERIE COLLIERY
ERIE SHAFT
TOP CLARK VEIN
SCALE 1" = 100'
PETER RIDER
JAMES RIDER
HUDSON COAL CO
DELAWARE AND HUDSON COAL COMPANY LESSEE
LACKAWANNA RIVER
MAIN ST.
PENN AVE.
LACKAWANNA AVE.
MAY ST.
HUDSON
CEMETERY
RAYFIELD YARDS
N. C. CO. Permit 21
SCRANTON COAL STORAGE