


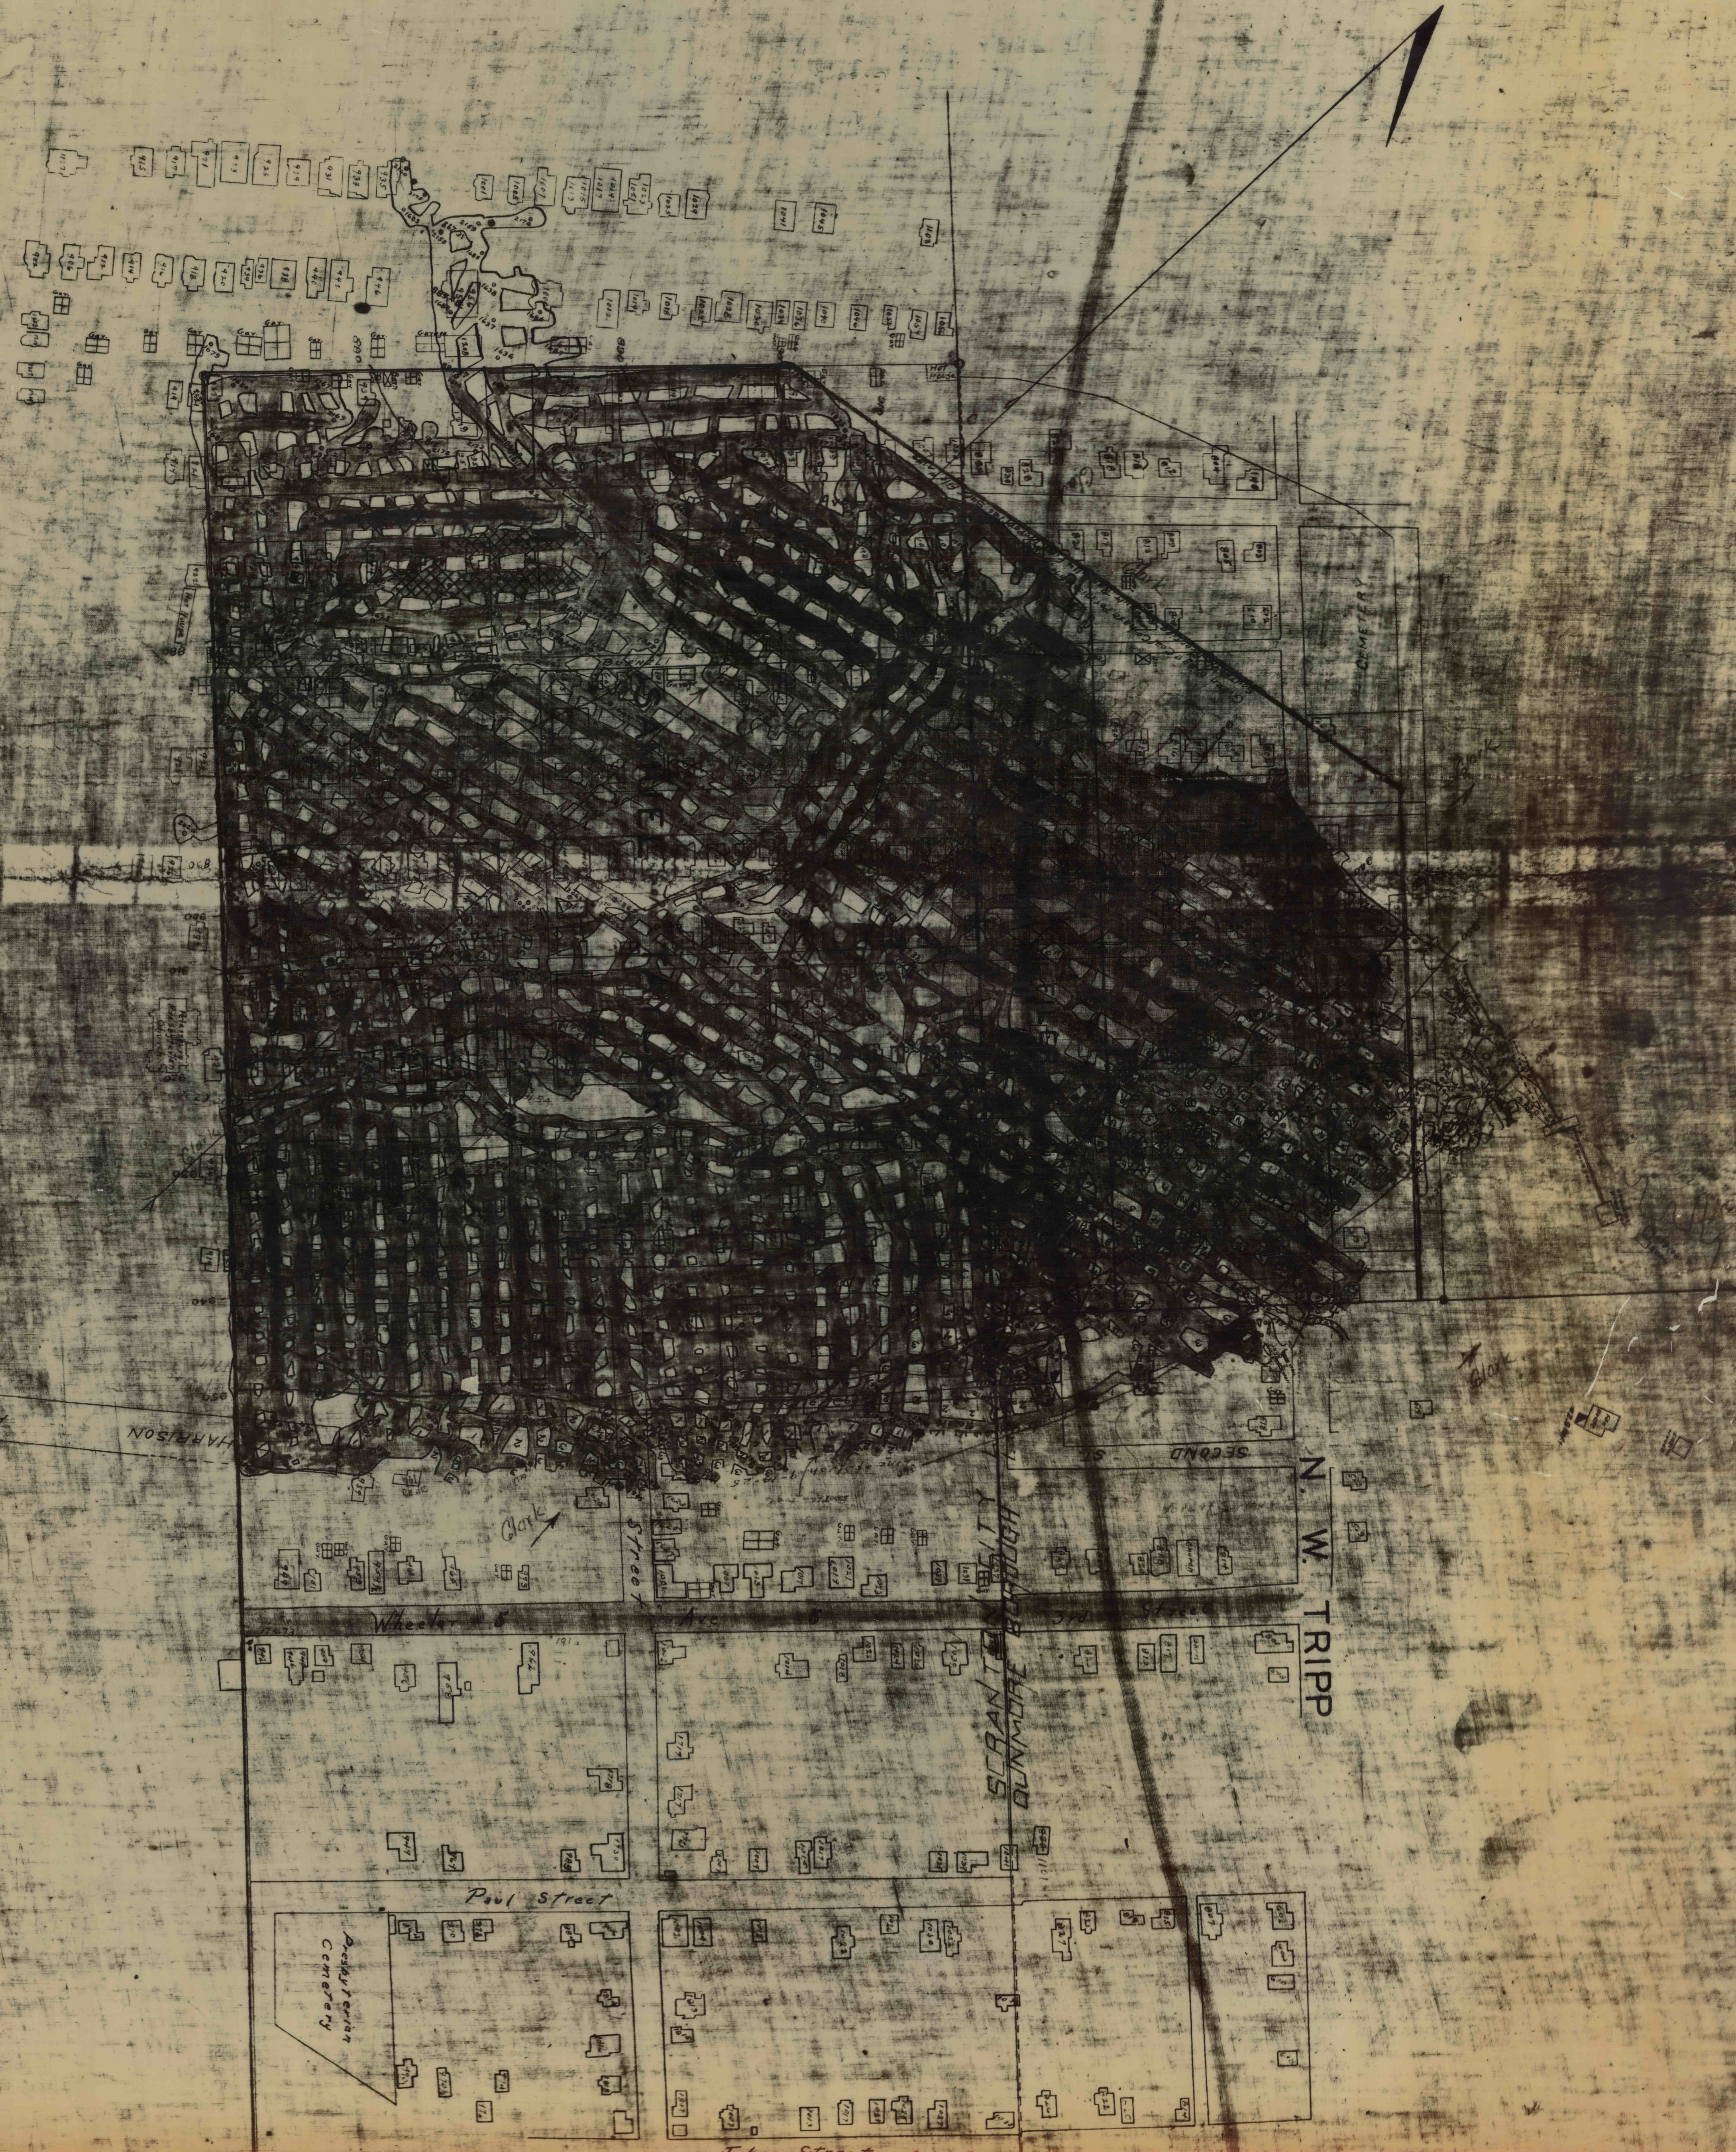

N. W. TRIPP

SECOND STREET

HARRISON

Wheeler

Paul Street

Cemetery

SCRANTON