


NO 5 ON
NO 2 ON
NO 1 ON
NO 3 ON
NO 4 ON
NO 6 ON
NO 7 ON
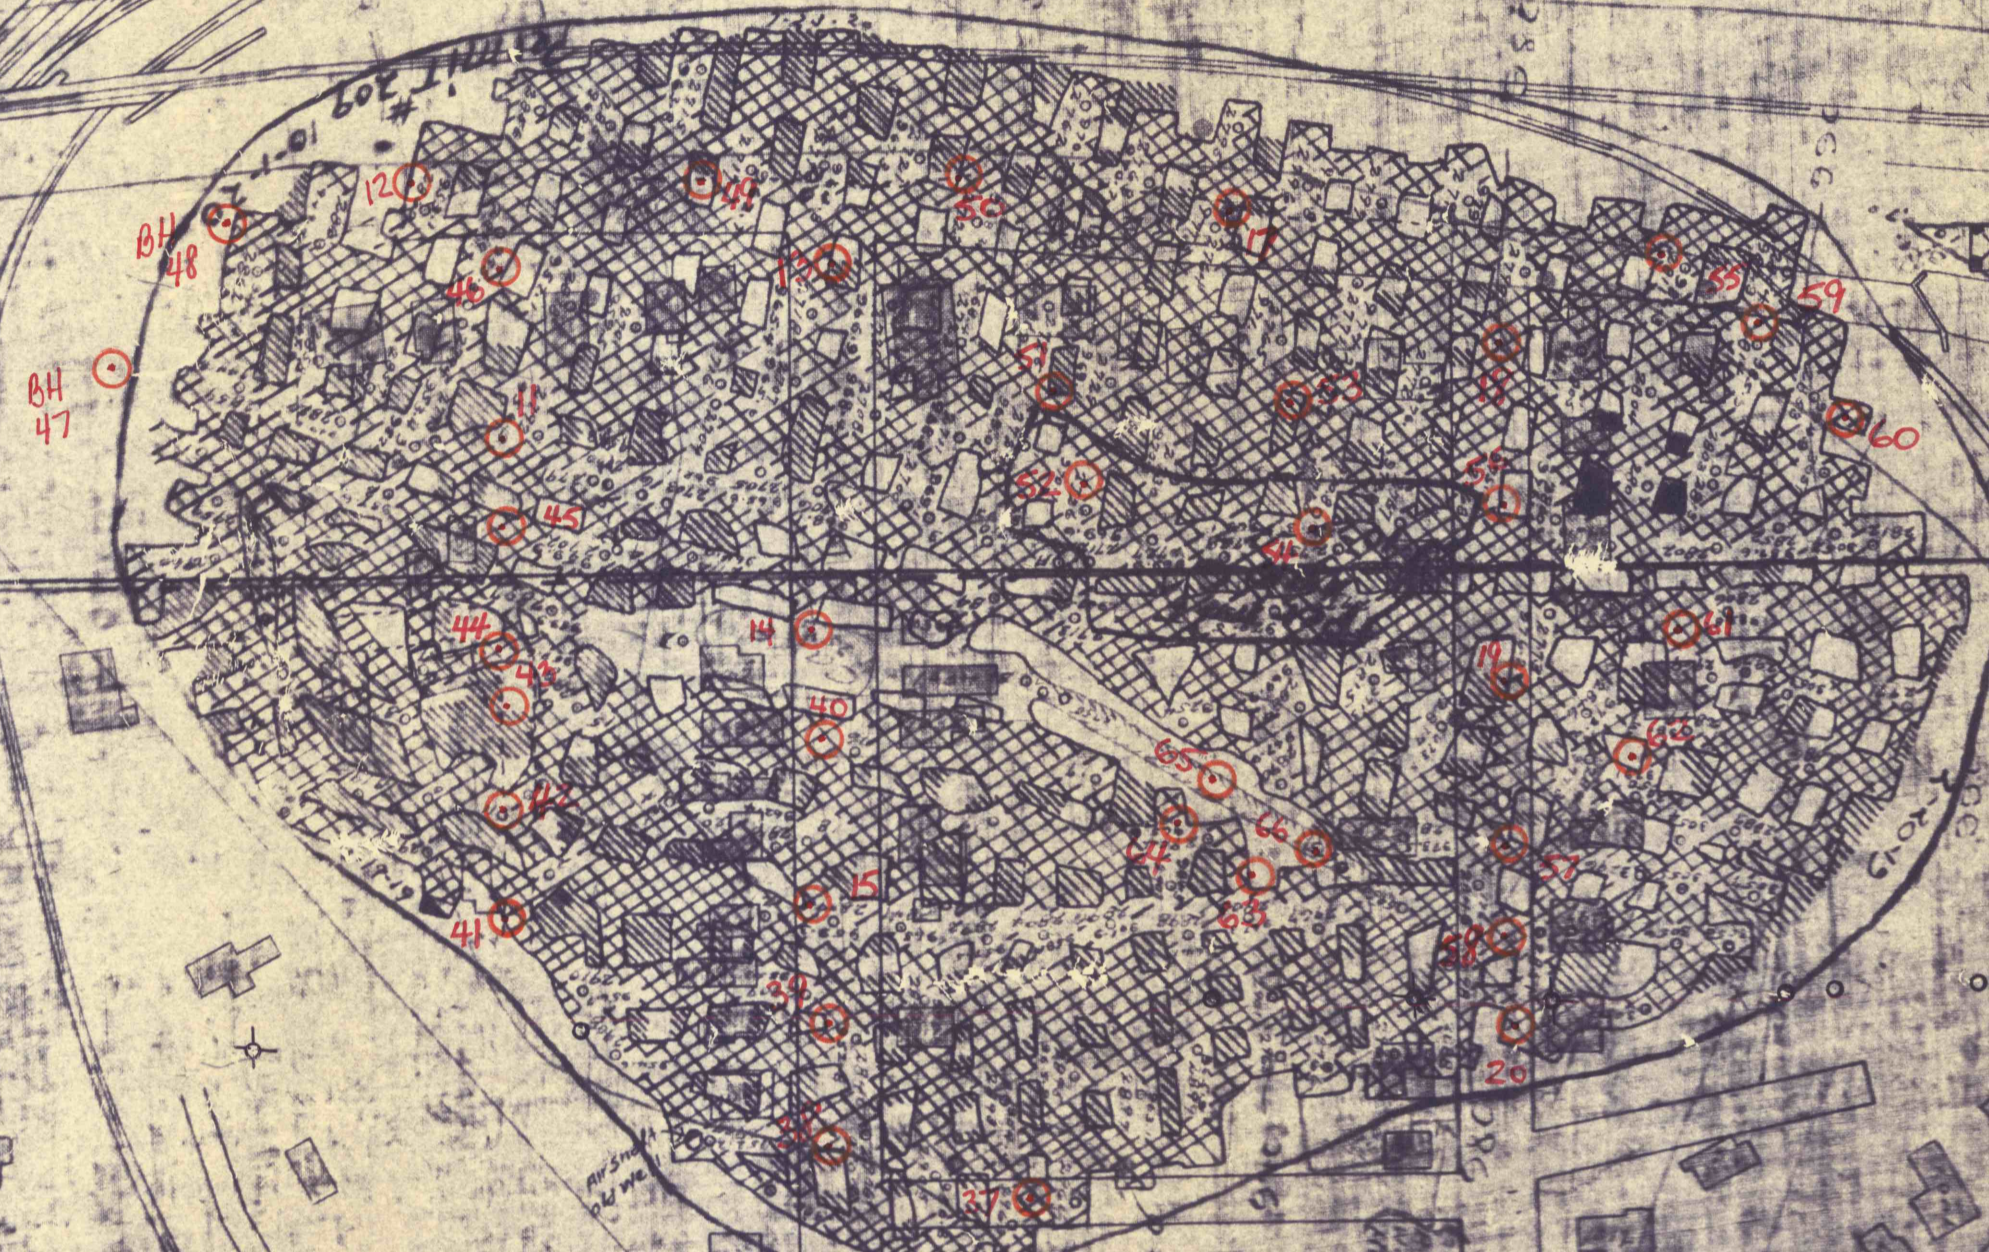

DUNMORE #2

