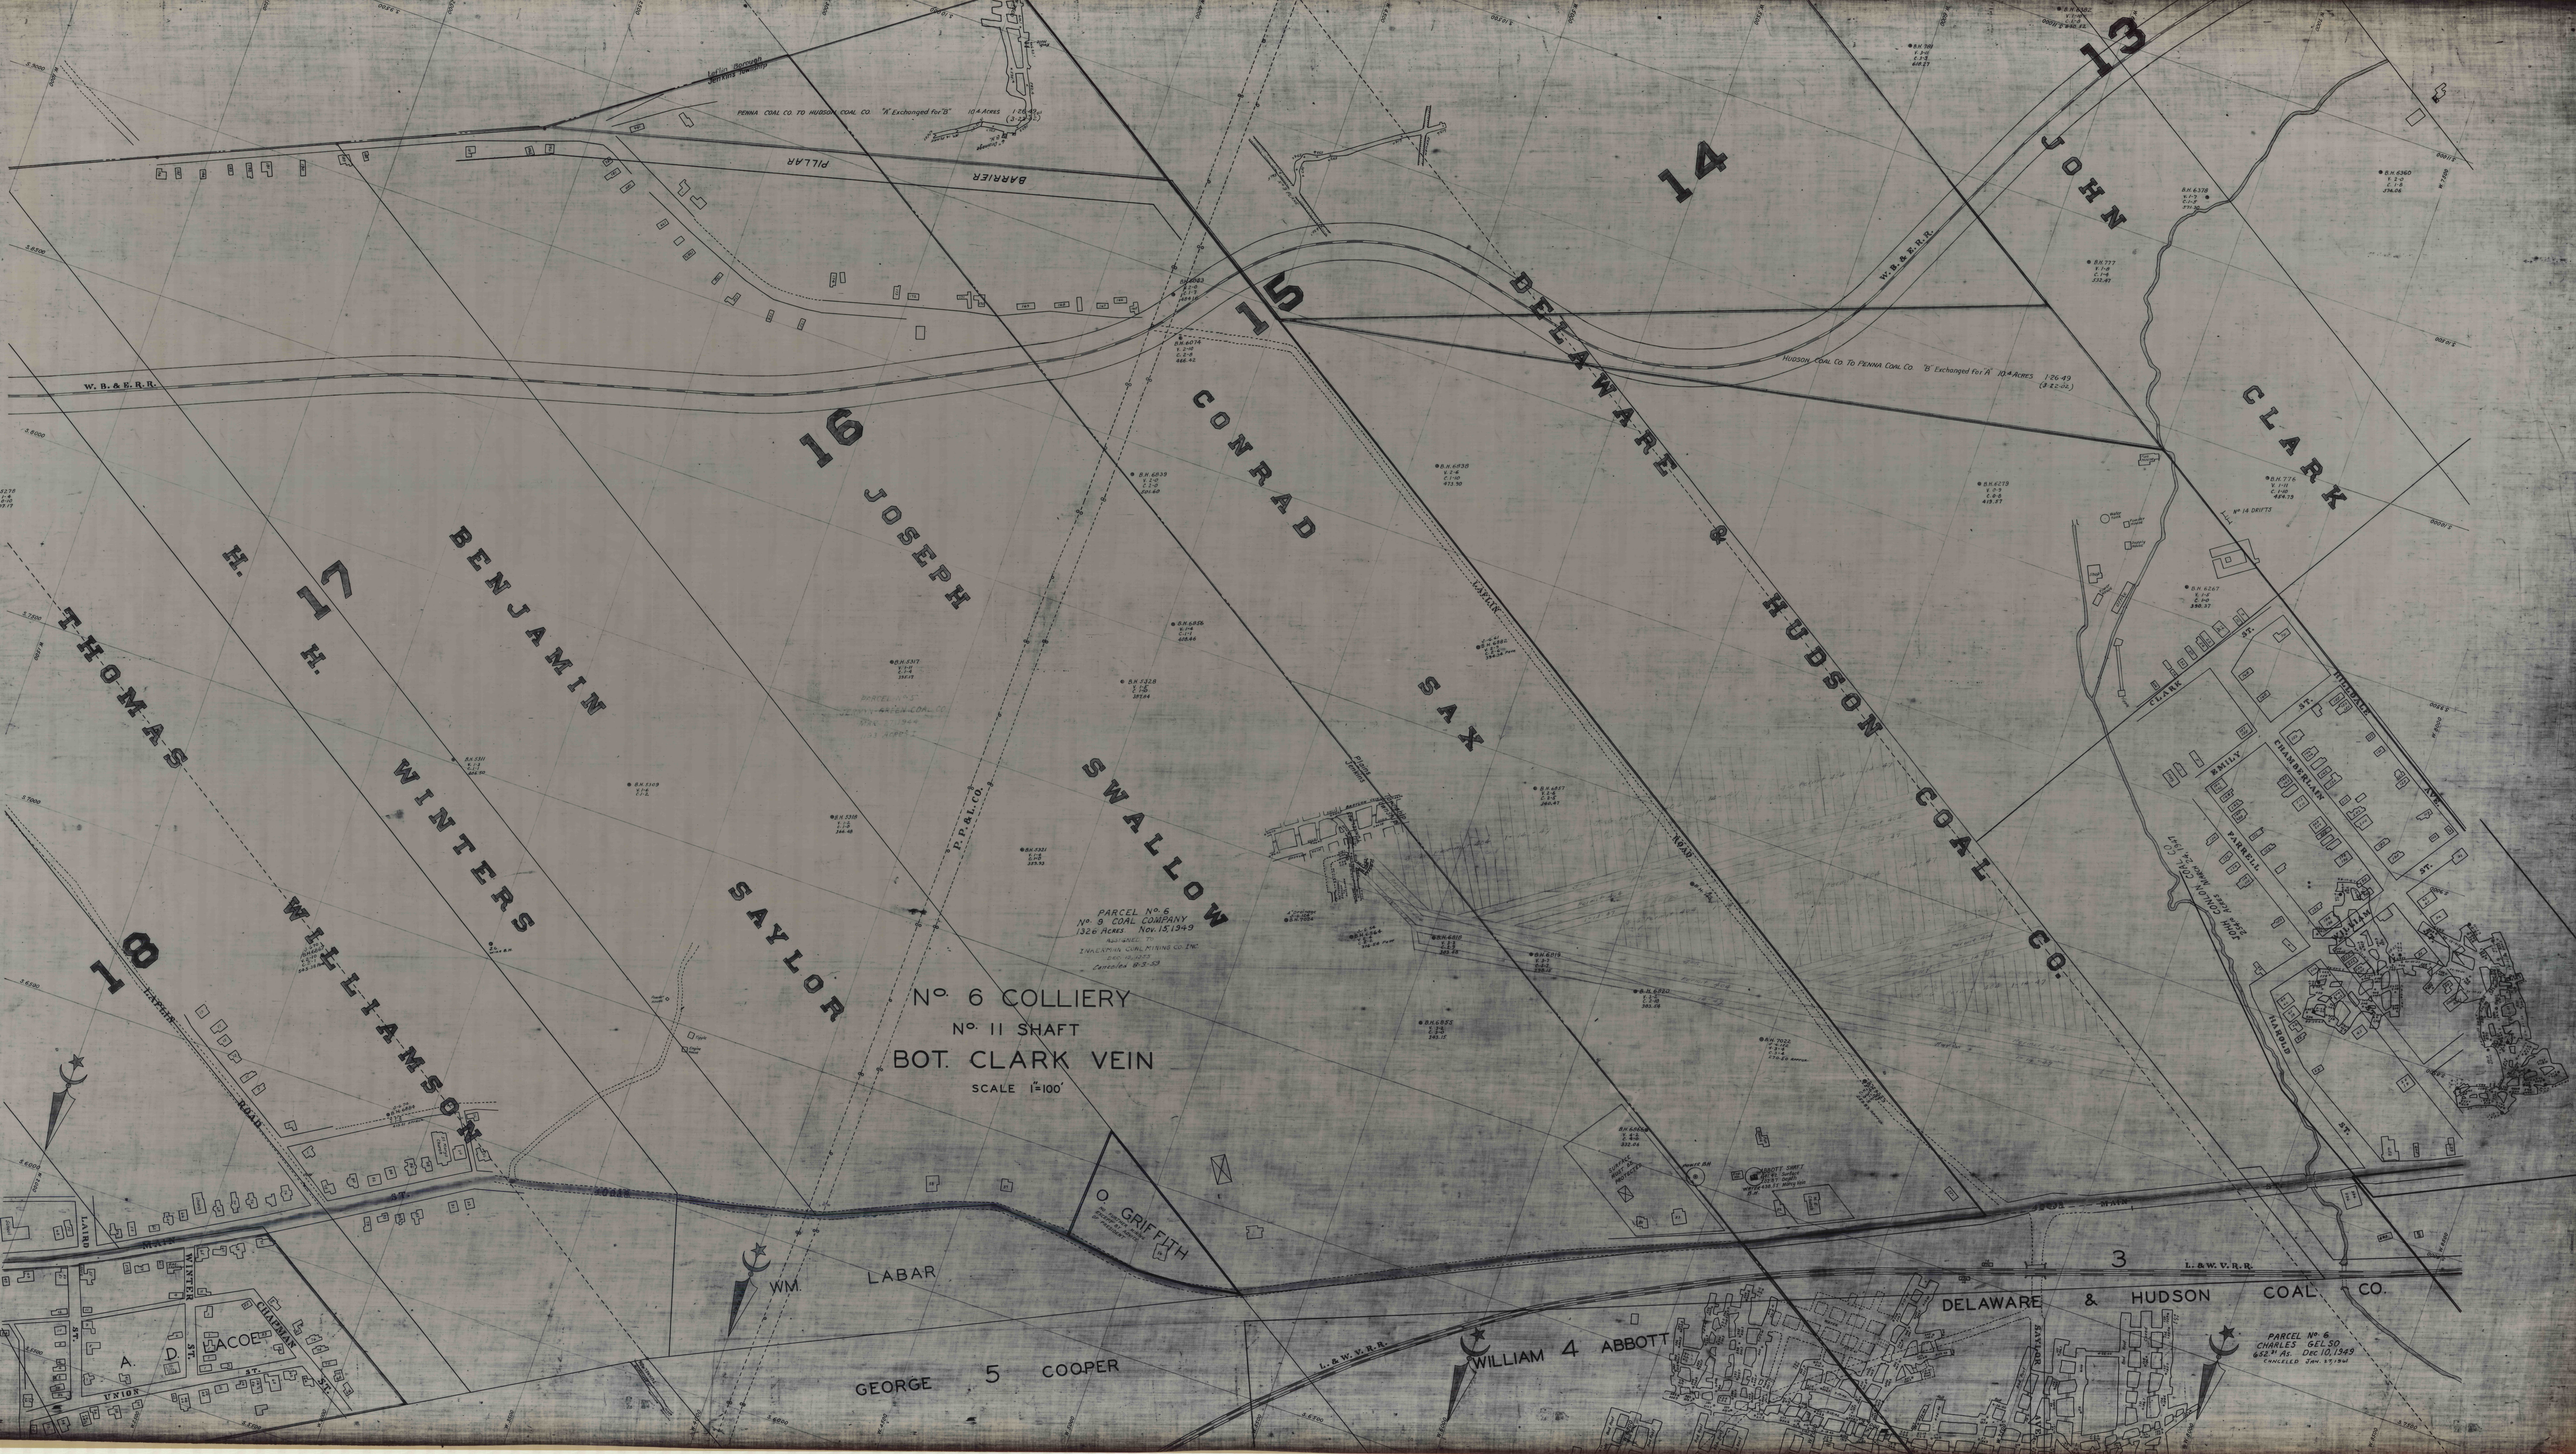
No. 6 COLLIERY
No. 11 SHAFT
BOT. CLARK VEIN
SCALE 1"=100'
PARCEL No. 6
No. 9 COAL COMPANY
132.6 ACRES Nov. 15, 1949
PENNA COAL CO. TO HUDSON COAL CO. "A" Exchanged for "B" 10.4 ACRES
HUDSON COAL CO. TO PENNA COAL CO. "B" Exchanged for "A" 10.4 ACRES 1-26-49
W. B. & E. R. R.
L. & W. V. R. R.
DELAWARE & HUDSON COAL CO.
JOHN CLARK
CONRAD SAX
JOSEPH SWALLOW
BENJAMIN SAYLOR
H. H. WINTERS
THOMAS WILLIAMSON
WM. LABAR
GRIFFITH
GEORGE COOPER
WILLIAM ABBOTT
A. D. JACOBS
PARCEL No. 6
CHARLES SELSO
6.62 AC. DEC. 10, 1949
CANCELED JAN. 15, 1954