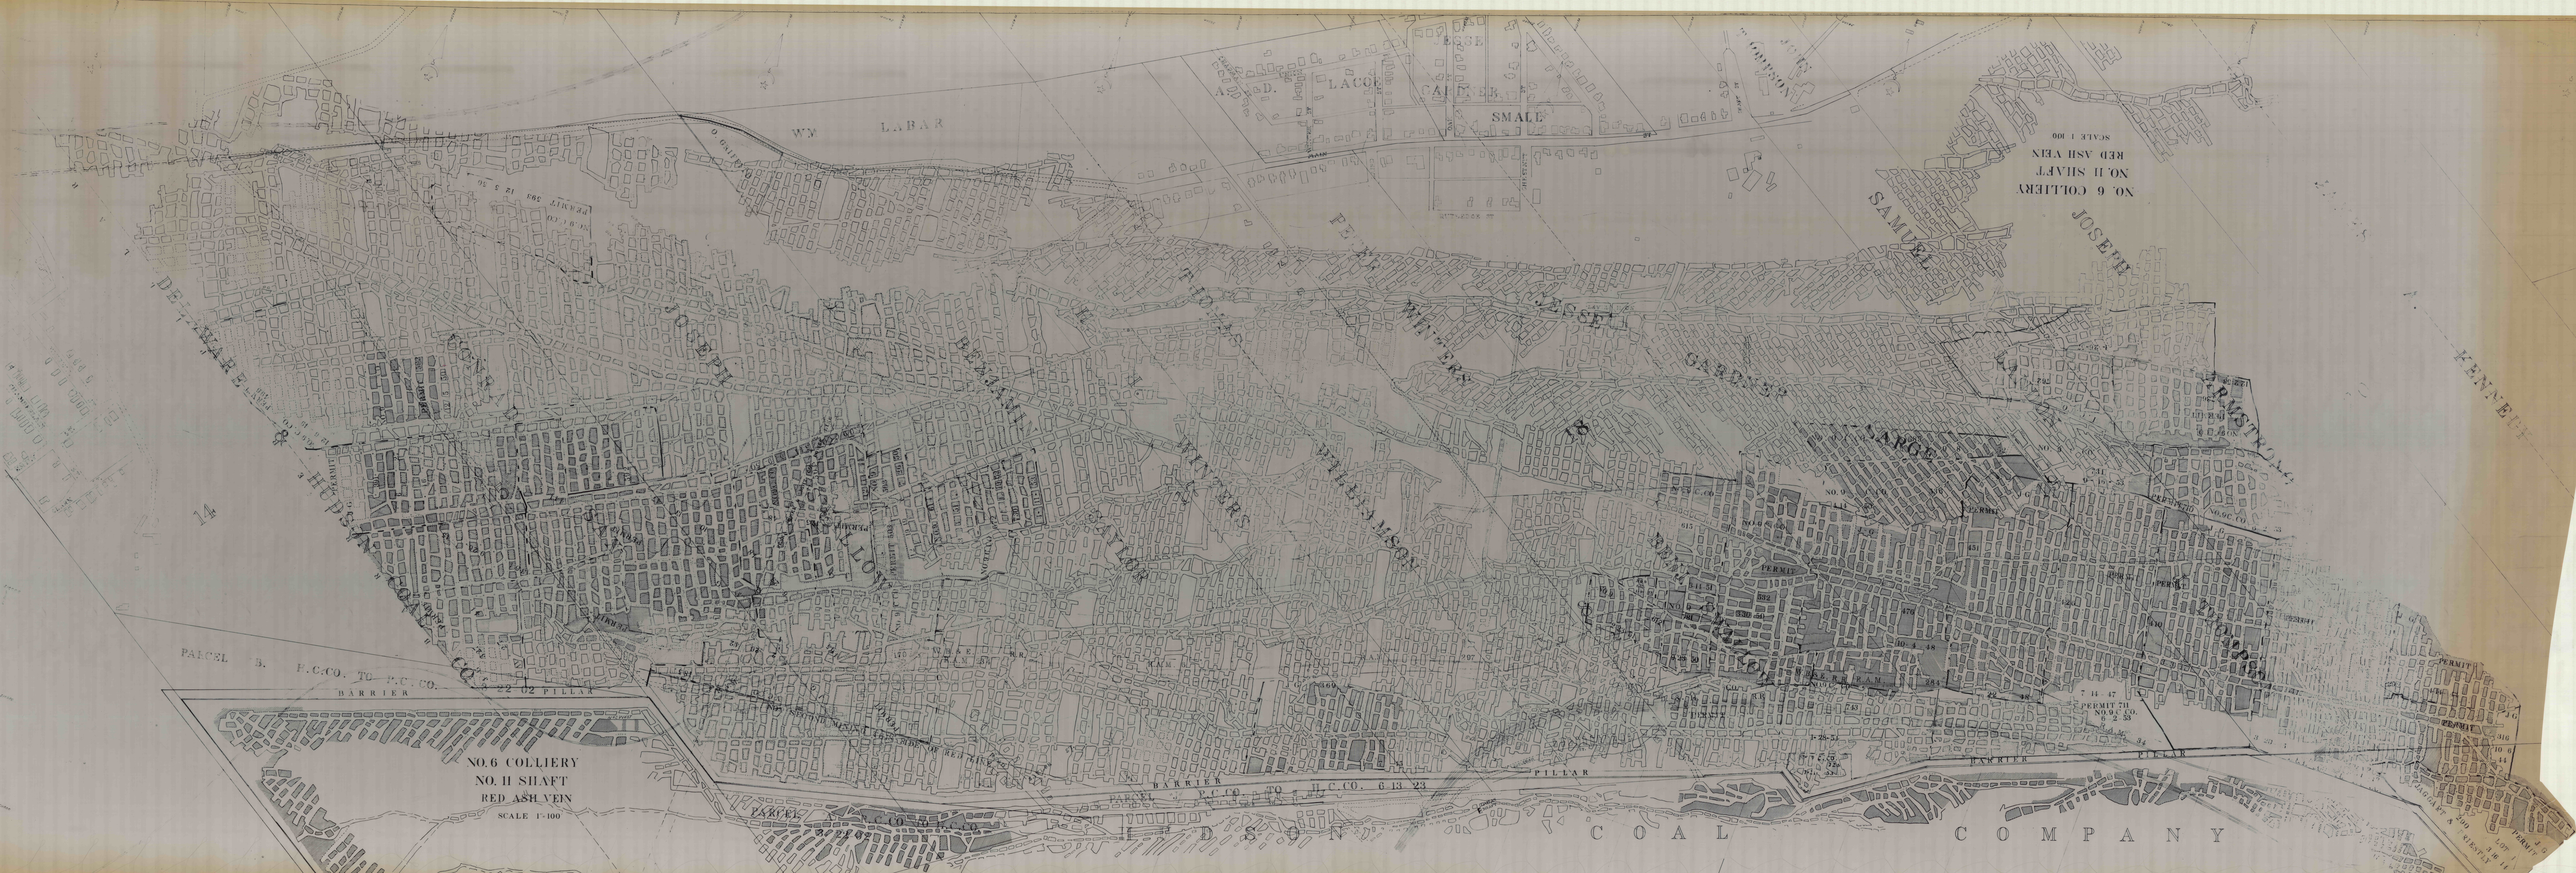
NO. 6 COLLIERY
NO. 11 SHAFT
RED ASH VEIN
SCALE 1"=100
NO. 6 COLLIERY
NO. 11 SHAFT
RED ASH VEIN
SCALE 1"=100
WM LABAR
SMALL
LACOE
JESSE
GARDNER
SAMUEL
JOSEPH
KENNEDY
ARMSTRONG
WILLIAMSON
WINTERS
BEZIAMIN
JOSEPH
DELAWARE
HUDSON COAL CO.
PARCEL B. P.C.CO. TO P.C.CO.
BARRIER
PILLAR
PARCEL A. P.C.CO. TO H.C.CO. 6 13 23
HUDSON COAL COMPANY
14