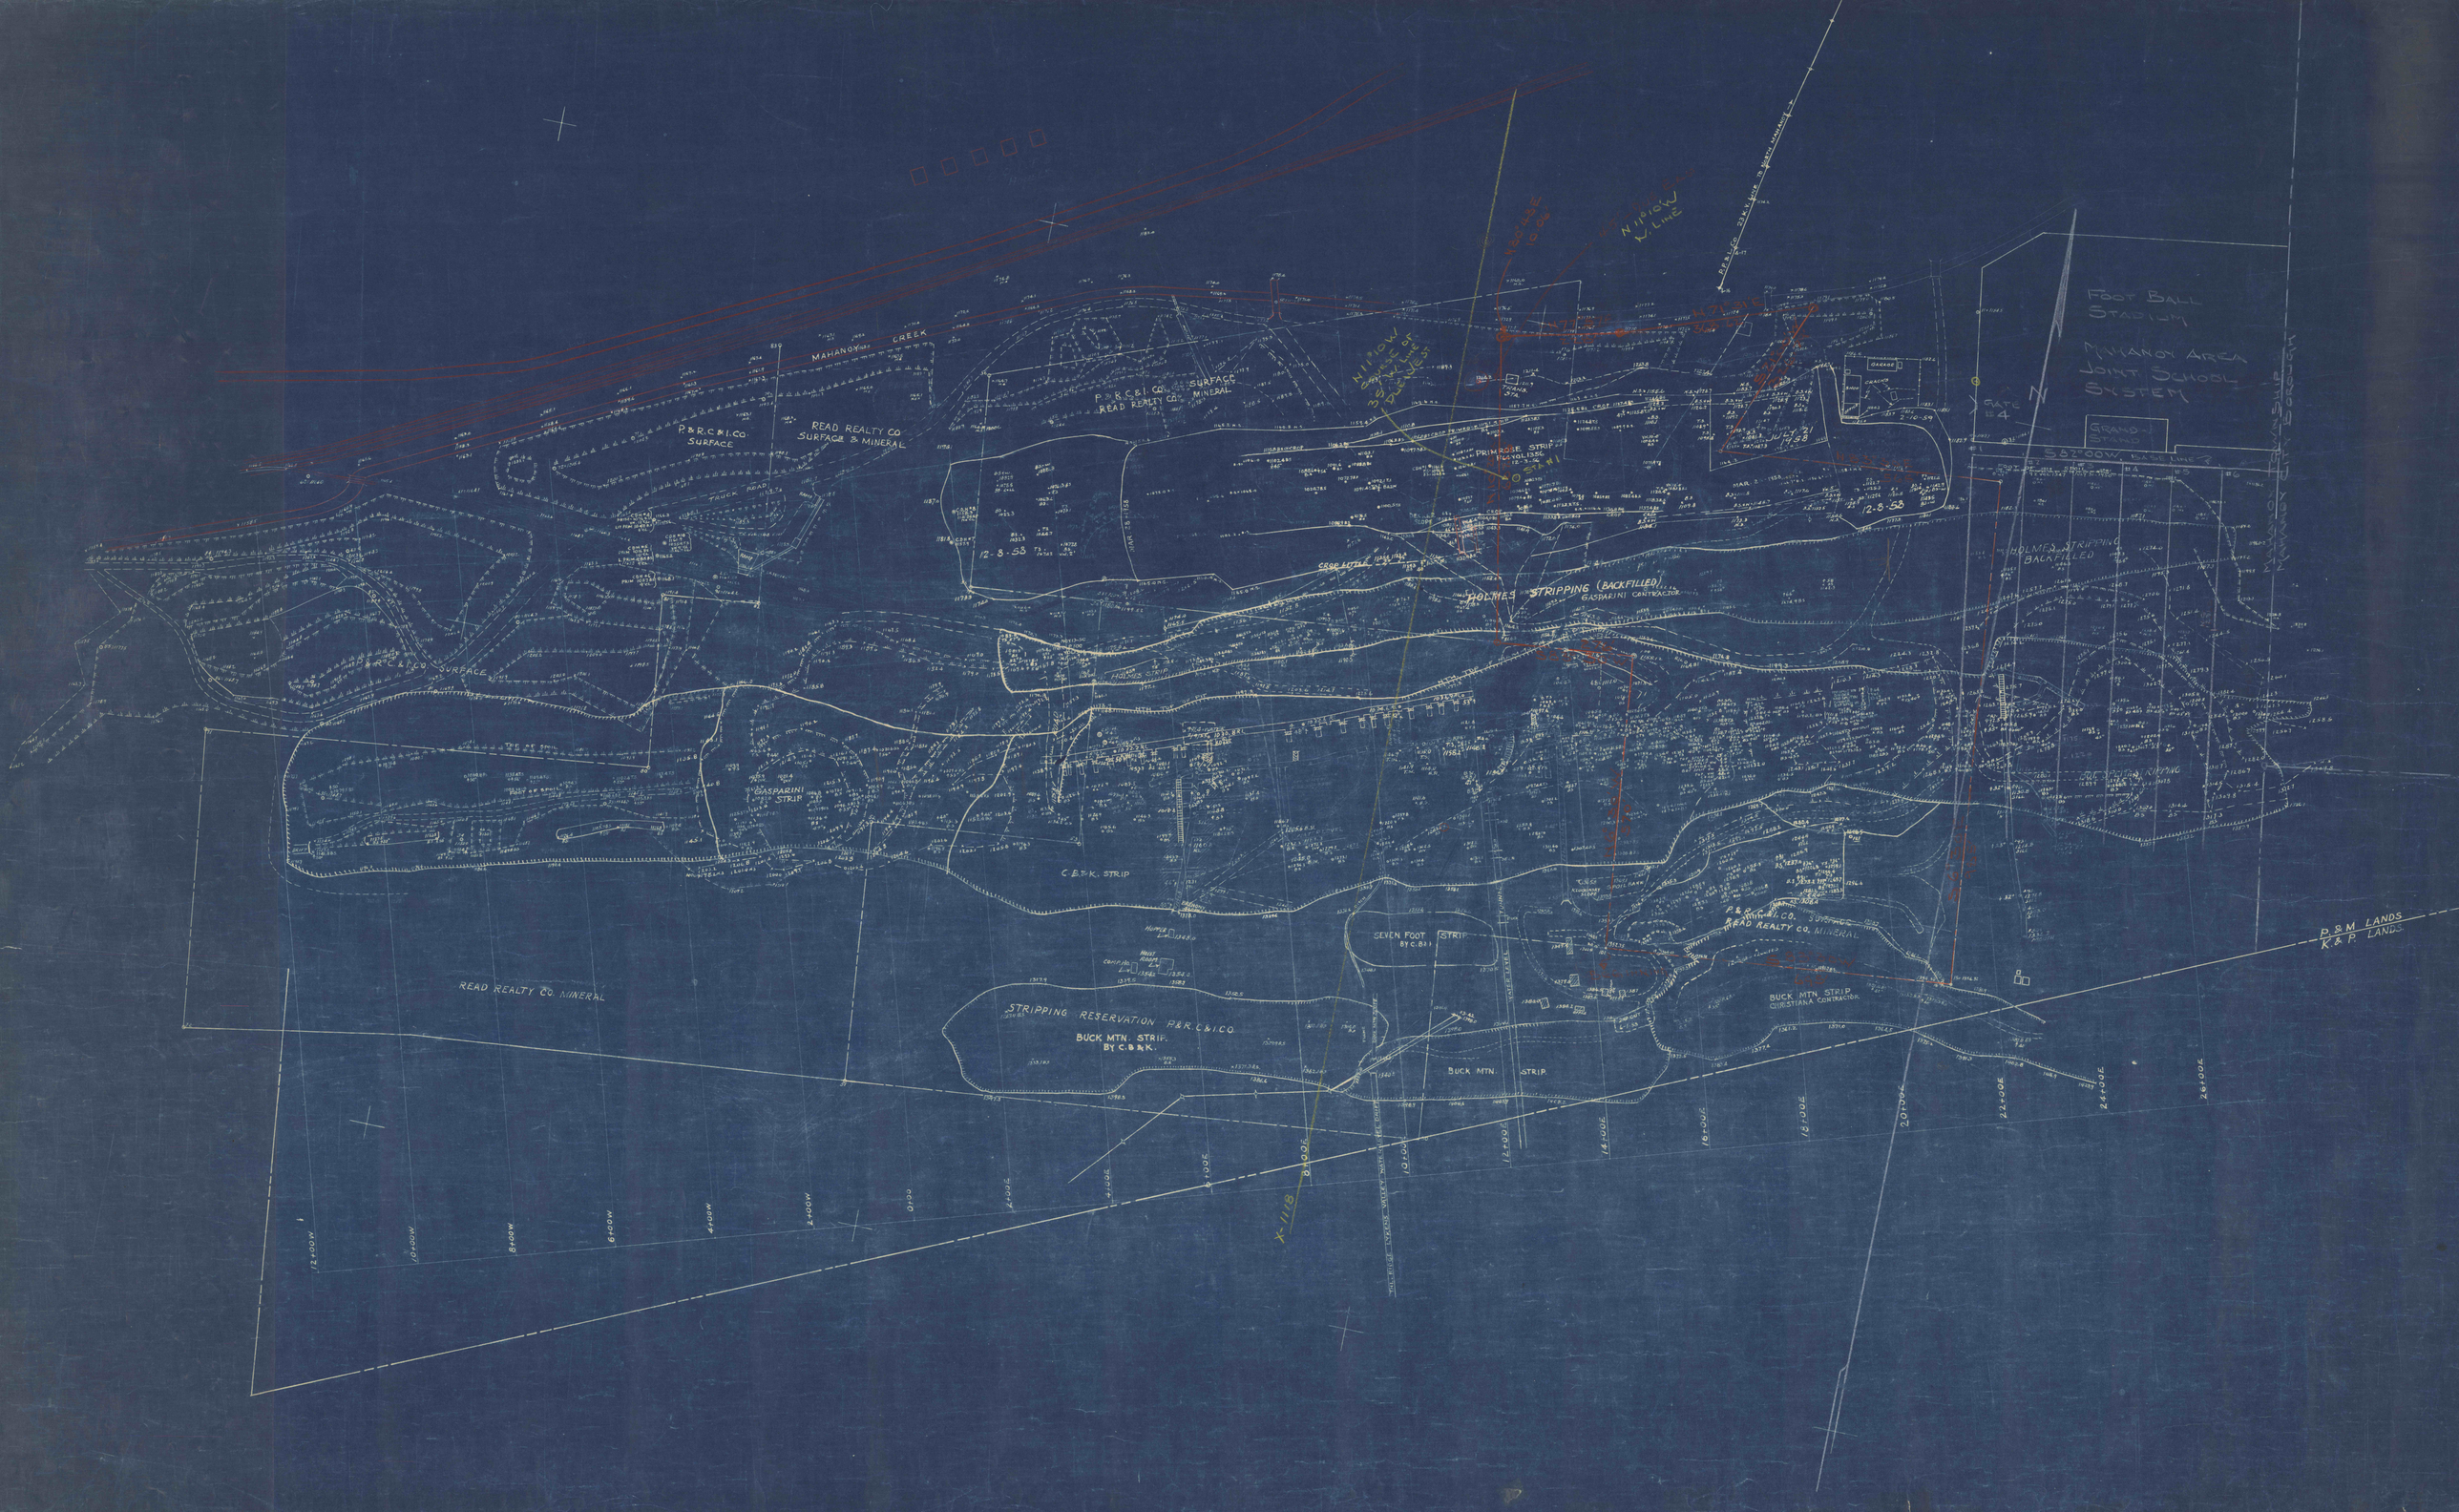

MAHANOY CREEK
P.&R.C.&I.CO. SURFACE
READ REALTY CO SURFACE & MINERAL
P.&R.C.&I.CO. SURFACE
READ REALTY CO. MINERAL
PRIMROSE STRIP
HOLMES STRIPPING (BACKFILLED)
GASPARINI CONTRACTOR
HOLMES STRIPPING BACKFILLED
FOOT BALL STADIUM
MAHANOY AREA JOINT SCHOOL SYSTEM
GRAND STAND
GATE #4
GASPARINI STRIP
C.B.&K. STRIP
SEVEN FOOT STRIP
BY C.B.&K.
READ REALTY CO. MINERAL
STRIPPING RESERVATION P.&R.C.&I.CO.
BUCK MTN. STRIP.
BY C.B.&K.
BUCK MTN. STRIP.
BUCK MTN. STRIP
CHRISTIANA CONTRACTOR
P.&M. LANDS
K.&P. LANDS
12-8-58
12-8-58
12+00W
10+00W
8+00W
6+00W
4+00W
2+00W
0+00
2+00E
4+00E
6+00E
8+00E
10+00E
12+00E
14+00E
16+00E
18+00E
20+00E
22+00E
24+00E
26+00E