

MAHANDY AREA JOINT SCHOOL SYSTEM STADIUM

D STREET PUBLIC SCHOOL

SOUTH LINE MAHANDY CITY MAHANDY TOWNSHIP

SPOIL DISPOSAL AREA

PRIMROSE STRIP PIT BEING BACKFILLED

HOLMES STRIP PIT BACKFILLED


PROPOSED PARKING AREA

BOTTOM OF BENCH

TOP OF BENCH

+1270± POSSIBLE RECREATIONAL AREA

P. P. & L. CO. POWER WATERLINE

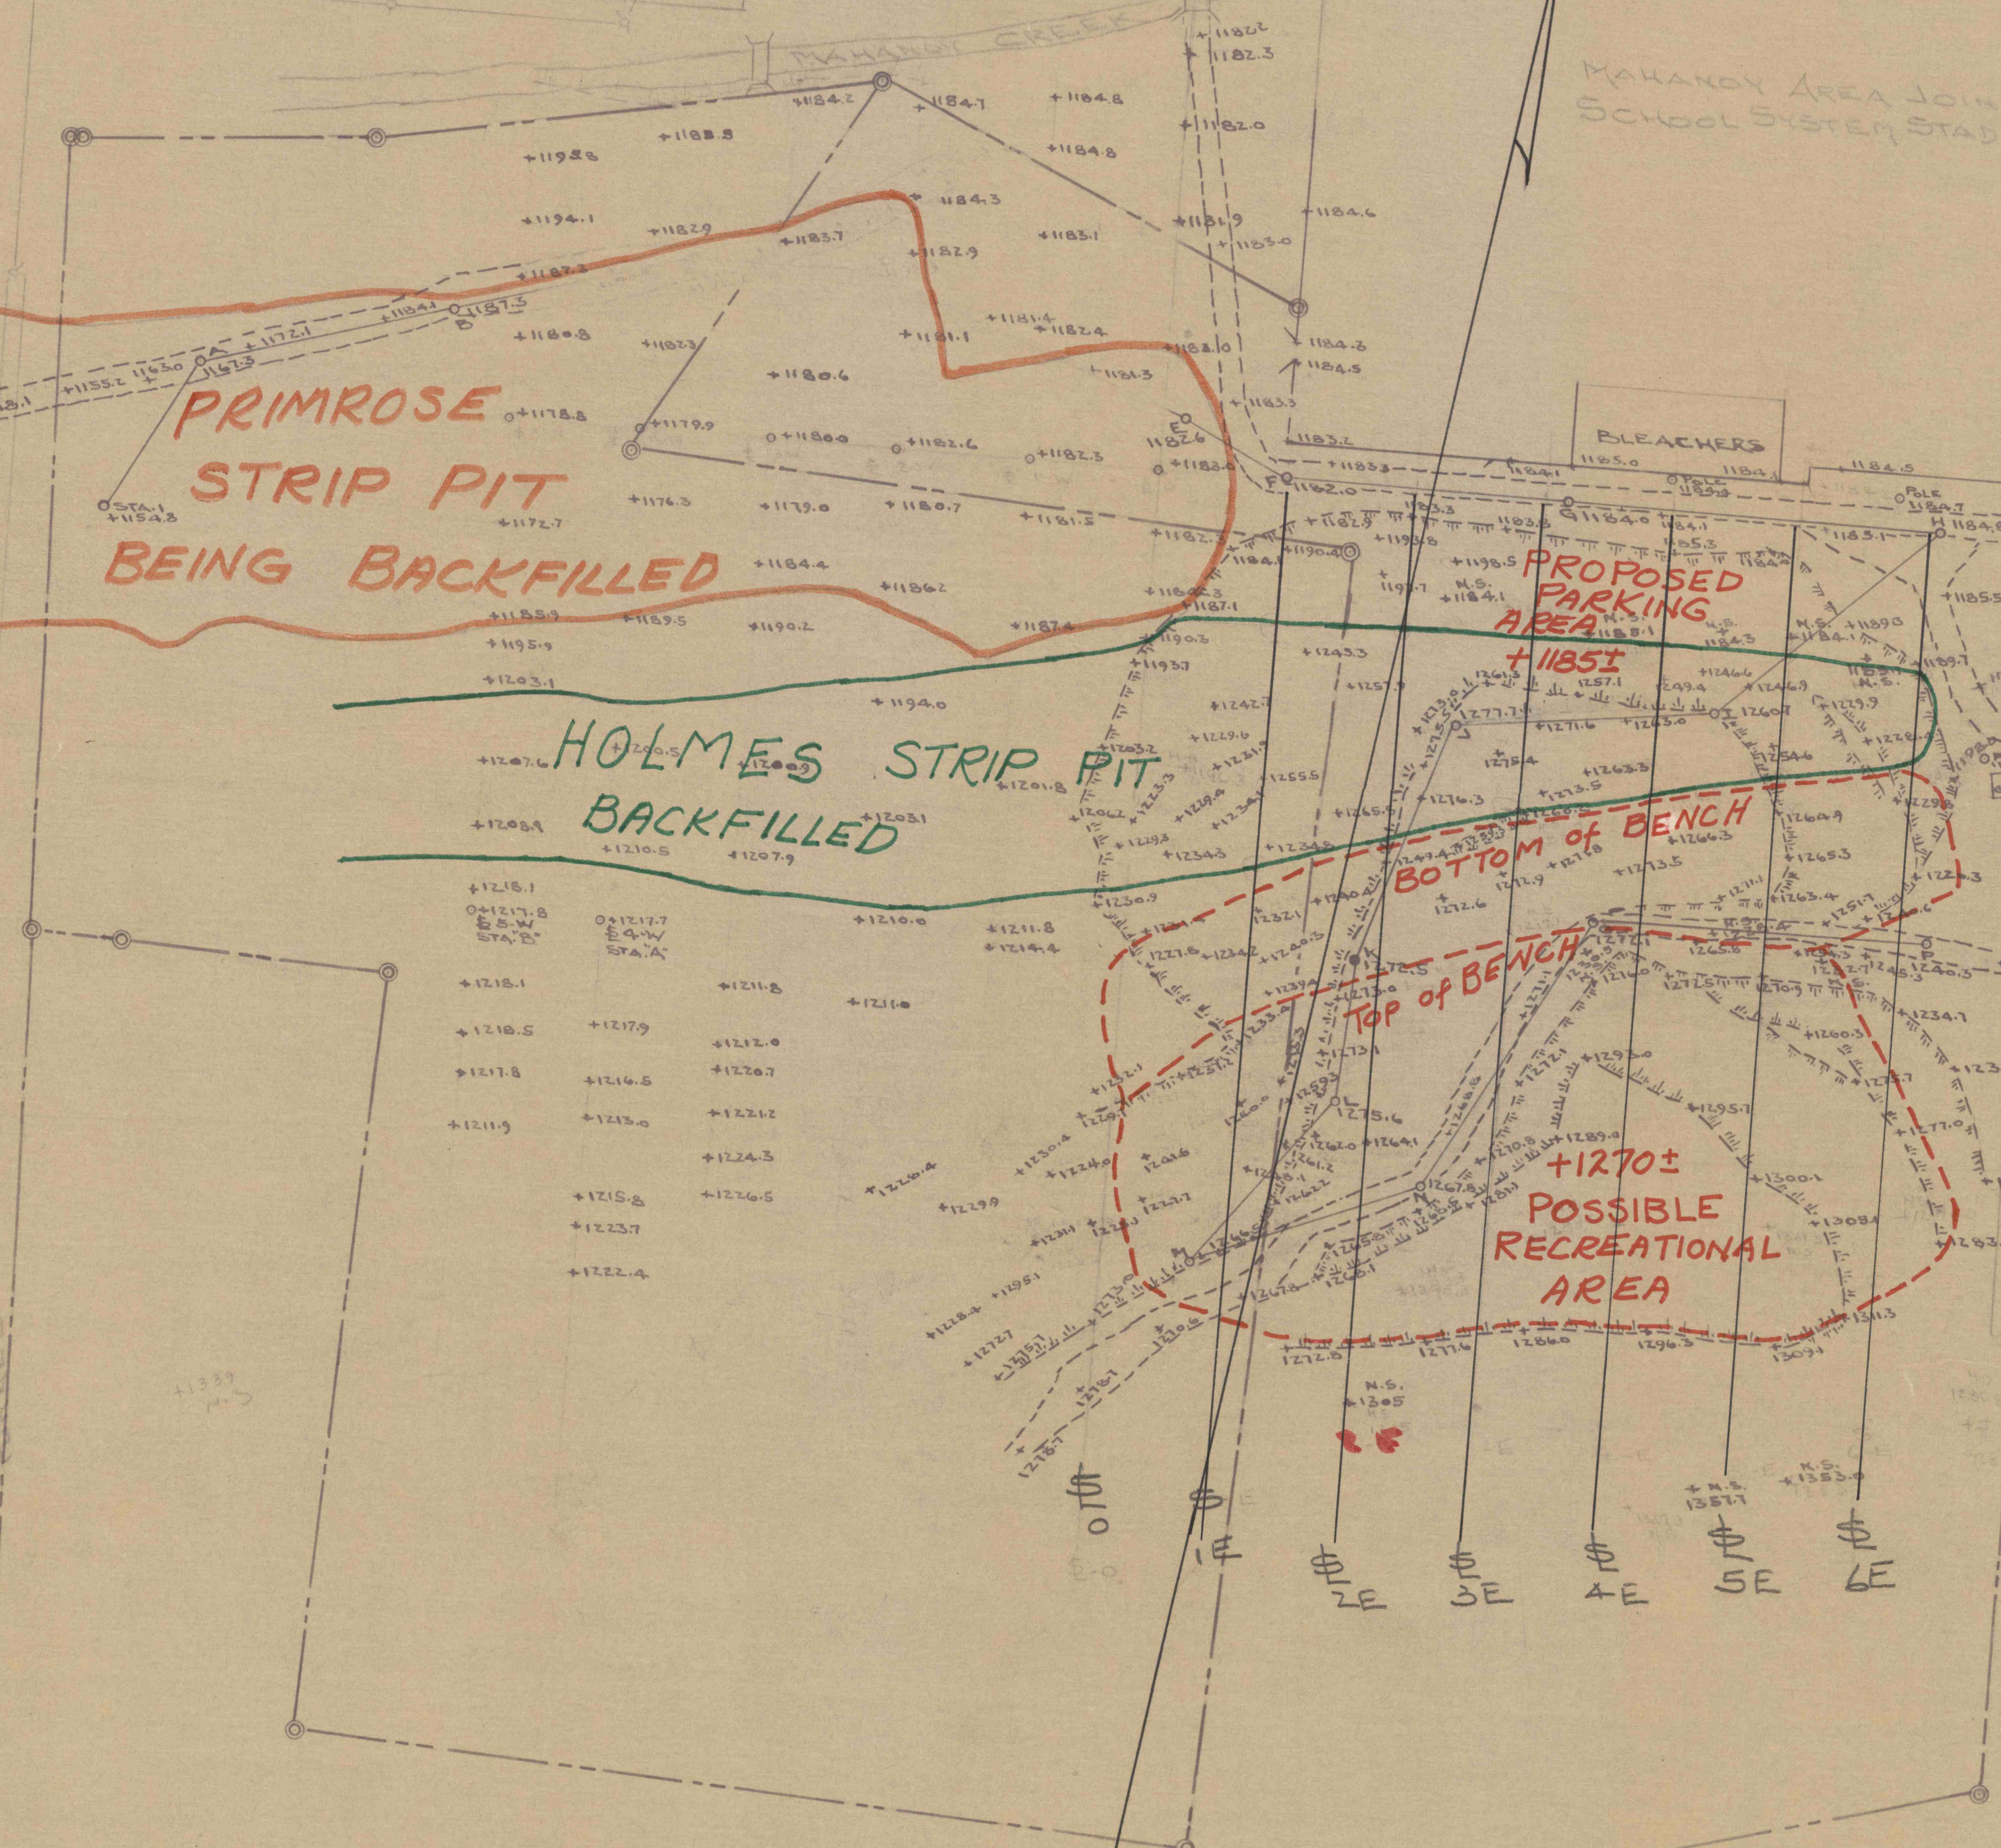

0101
 IF
 LE SE AE SE LE