


0+00
 0+25
 0+50
 0+75
 1+00
 1+25
 1+50
 1+75
 2+00
 2+25
 2+50
 2+75
 3+00
 3+25
 3+50
 3+75
 4+00
 4+25
 4+50
 4+75
 5+00
 5+25
 5+50
 5+75
 6+00
 6+25
 6+50

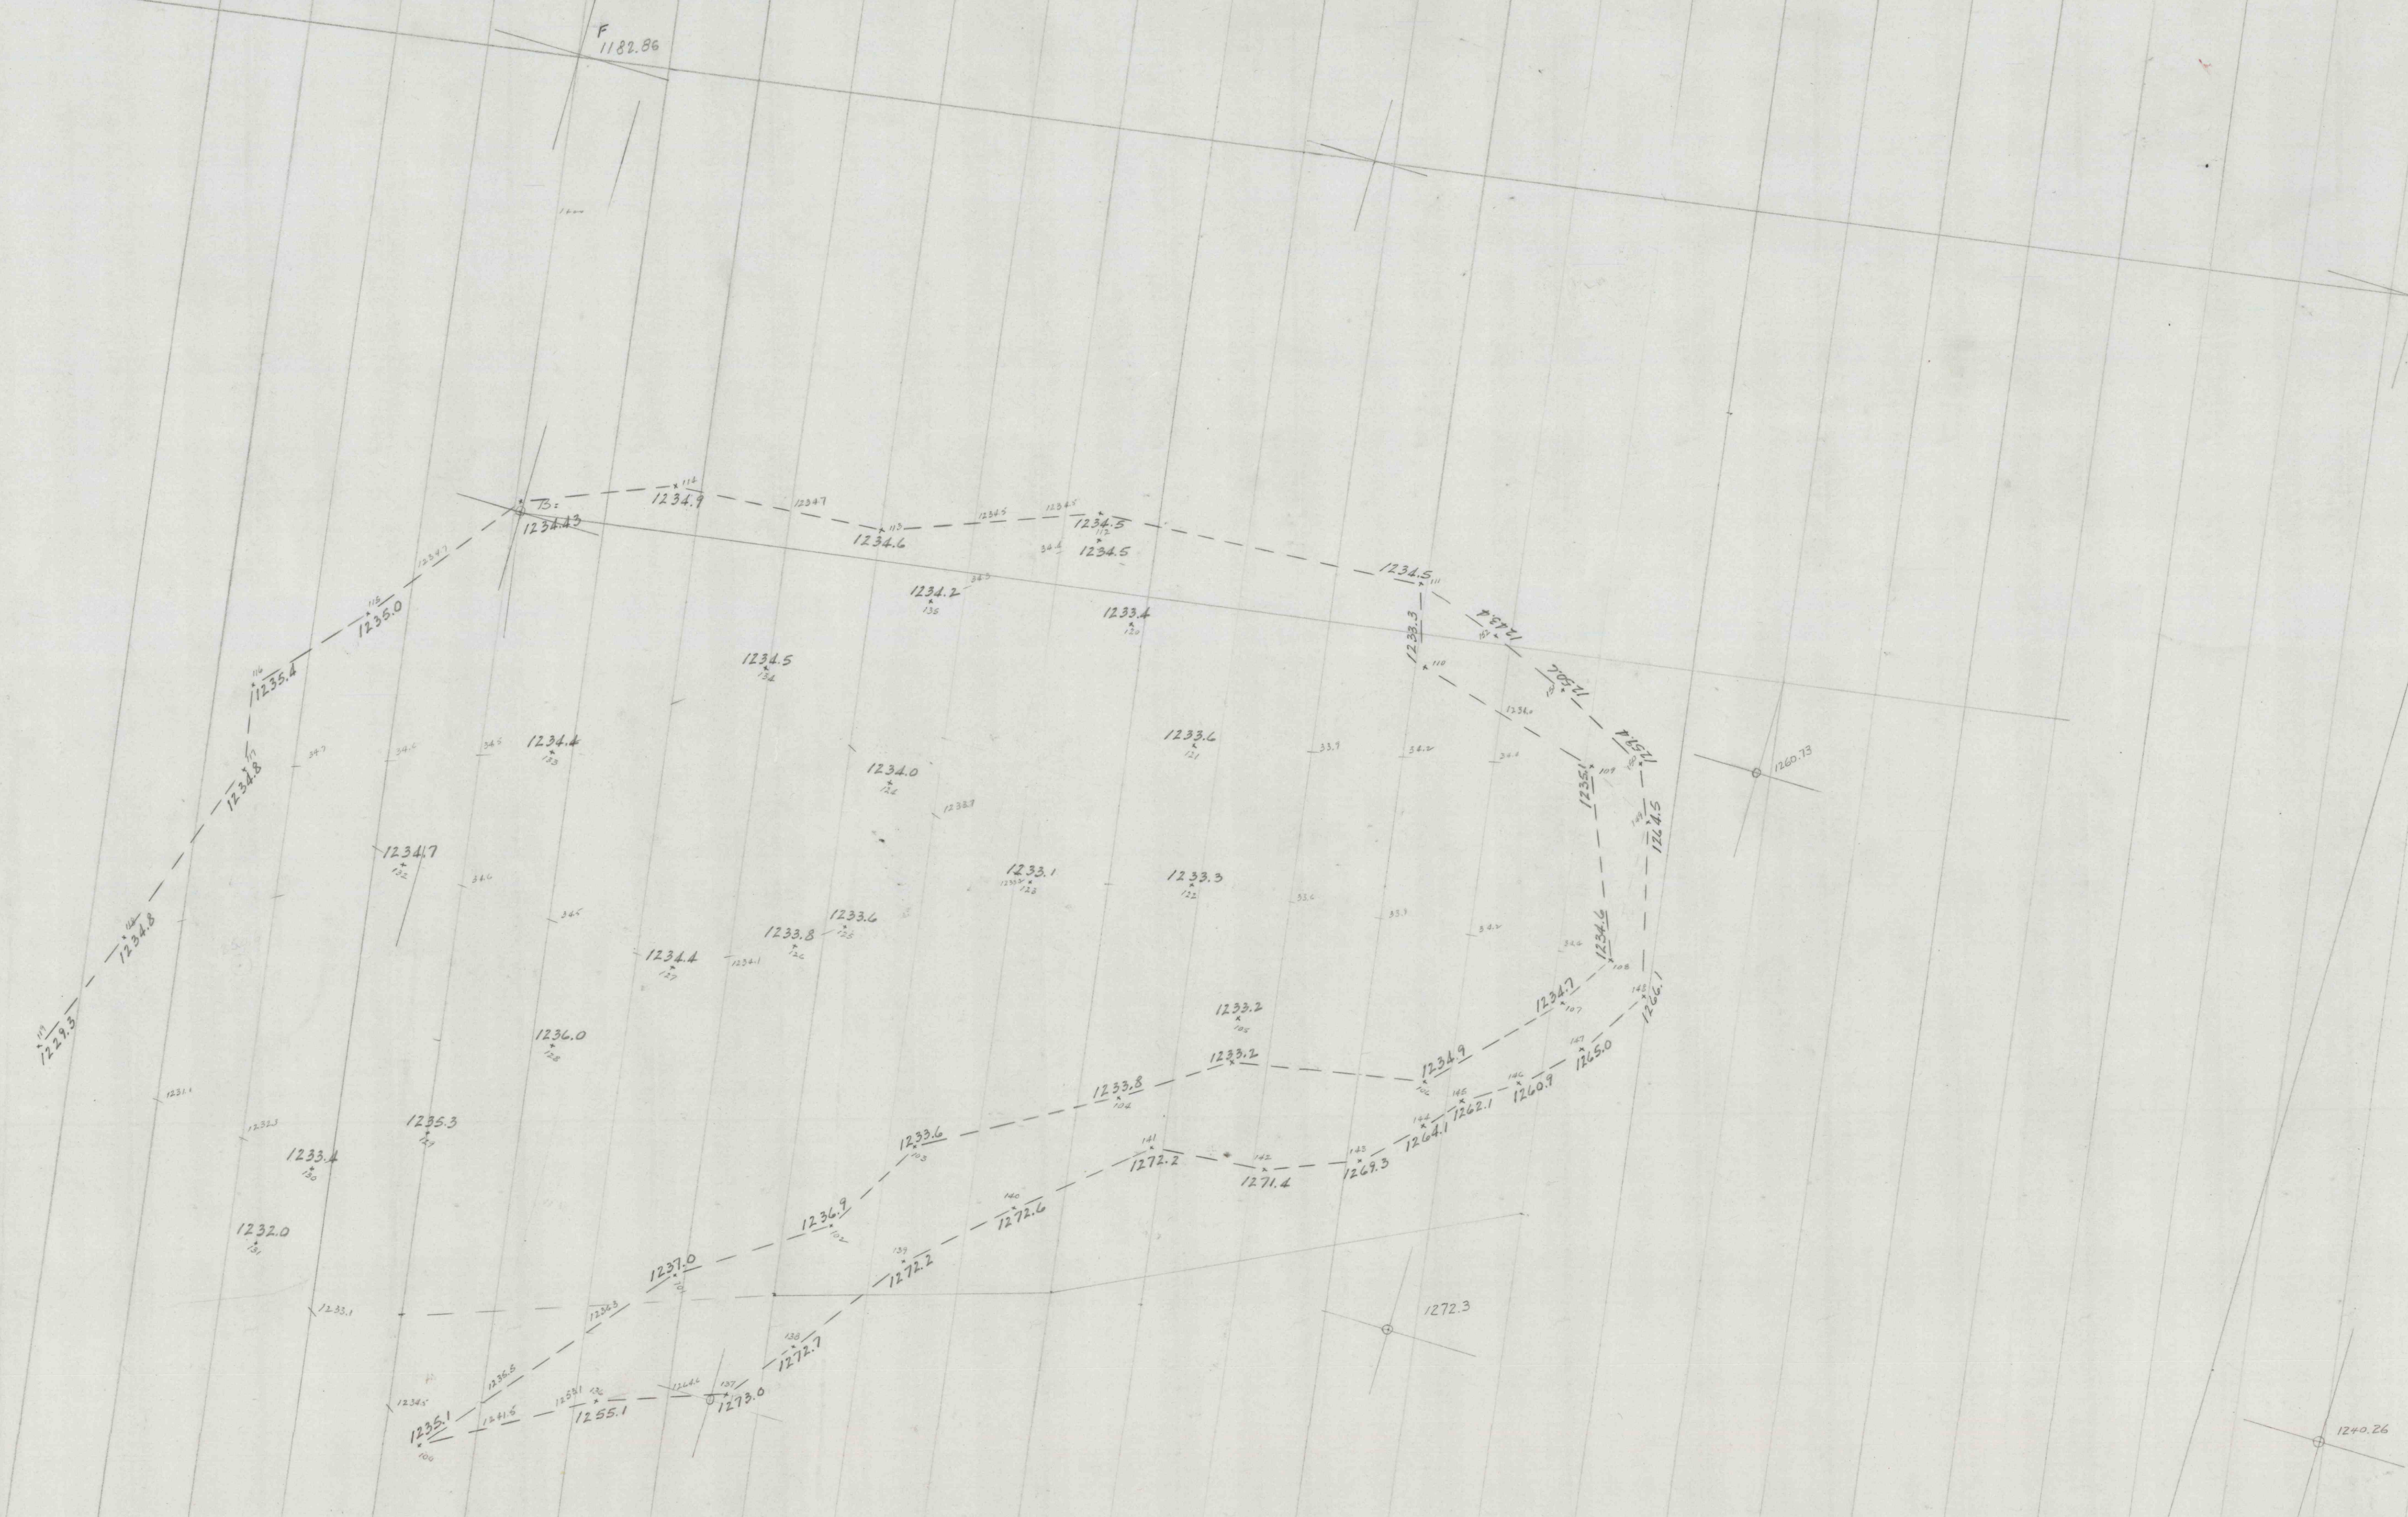

MAHANGY CITY SPILL BANK REMOVAL
 PROJECT AS-33
 SURVEY AUG 15, 1966 INCLUSIVE