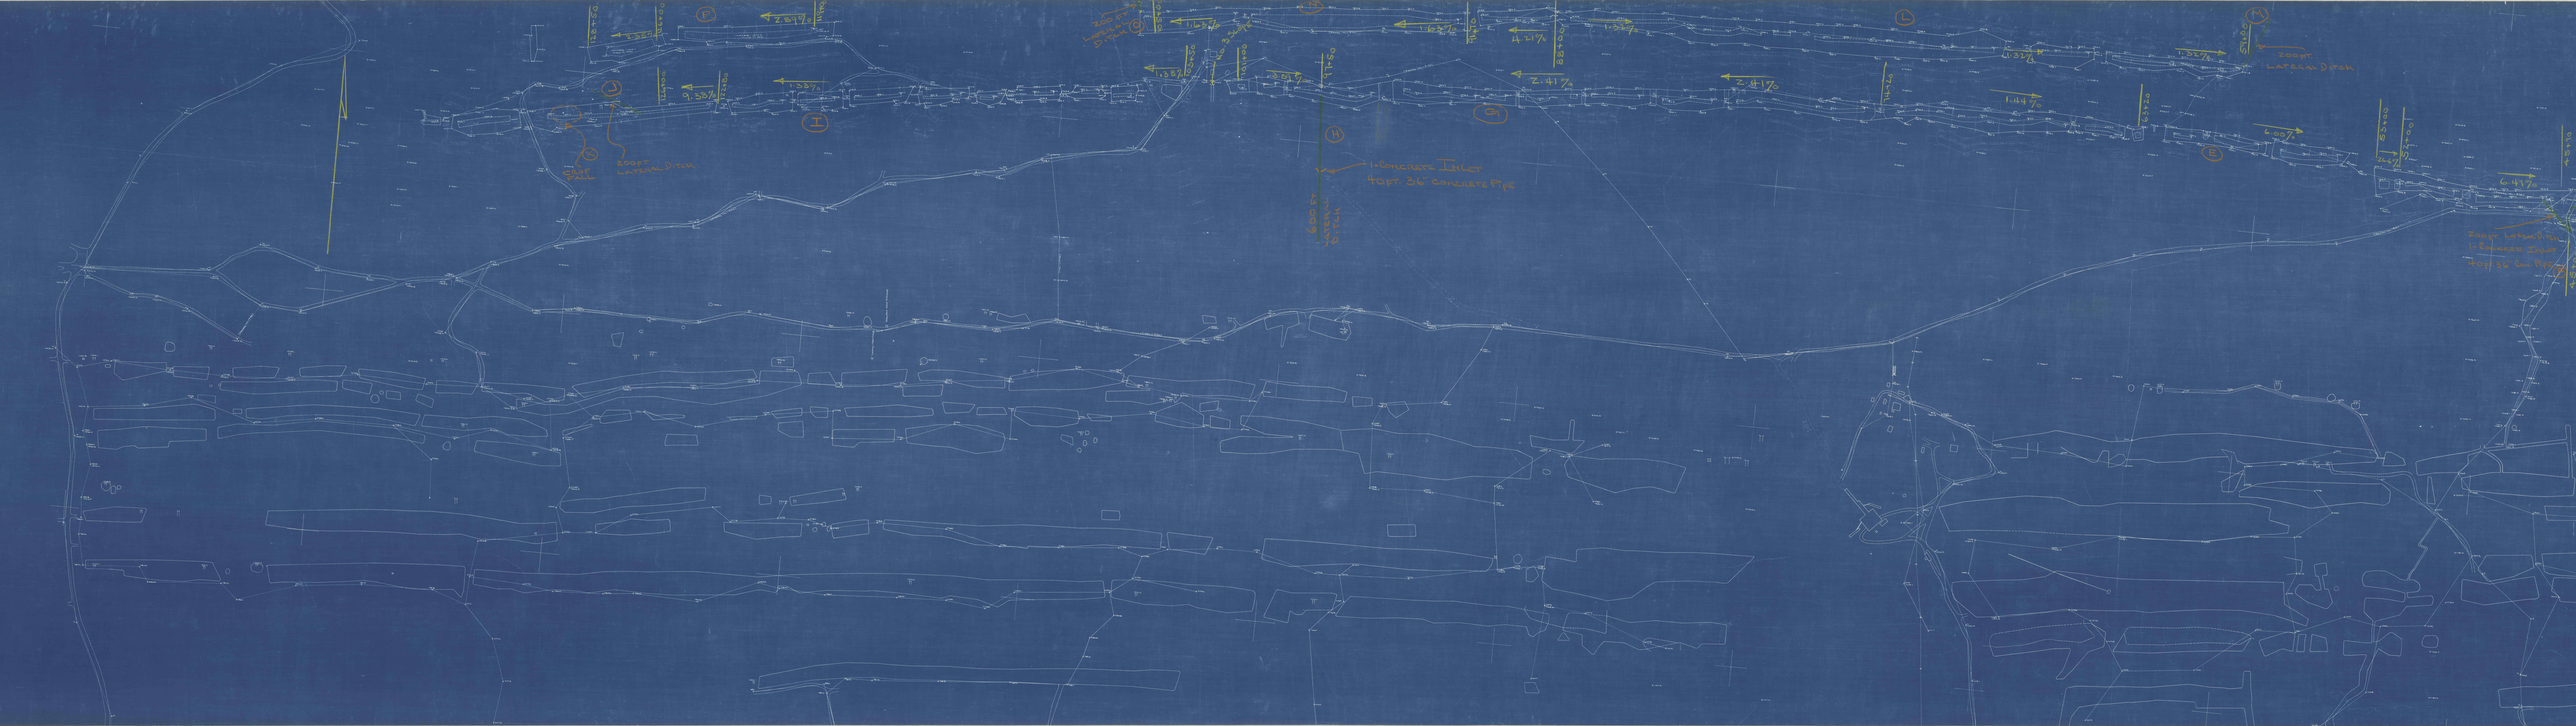
P
2.01%
1.32%
J
0.33%
1.32%
K
SHORT PIPE
200 FT LATERAL DITCH
I
200 FT LATERAL DITCH
1.63%
1.38%
2.01%
H
1-CONCRETE INLET
40 FT. 36" CONCRETE PIPE
G
4.17%
2.41%
2.41%
L
1.32%
1.44%
E
1.02%
6.00%
M
200 FT LATERAL DITCH
4.17%
200 FT LATERAL DITCH
1-EXPANDED ZINC
40 FT 36" CONC PIPE