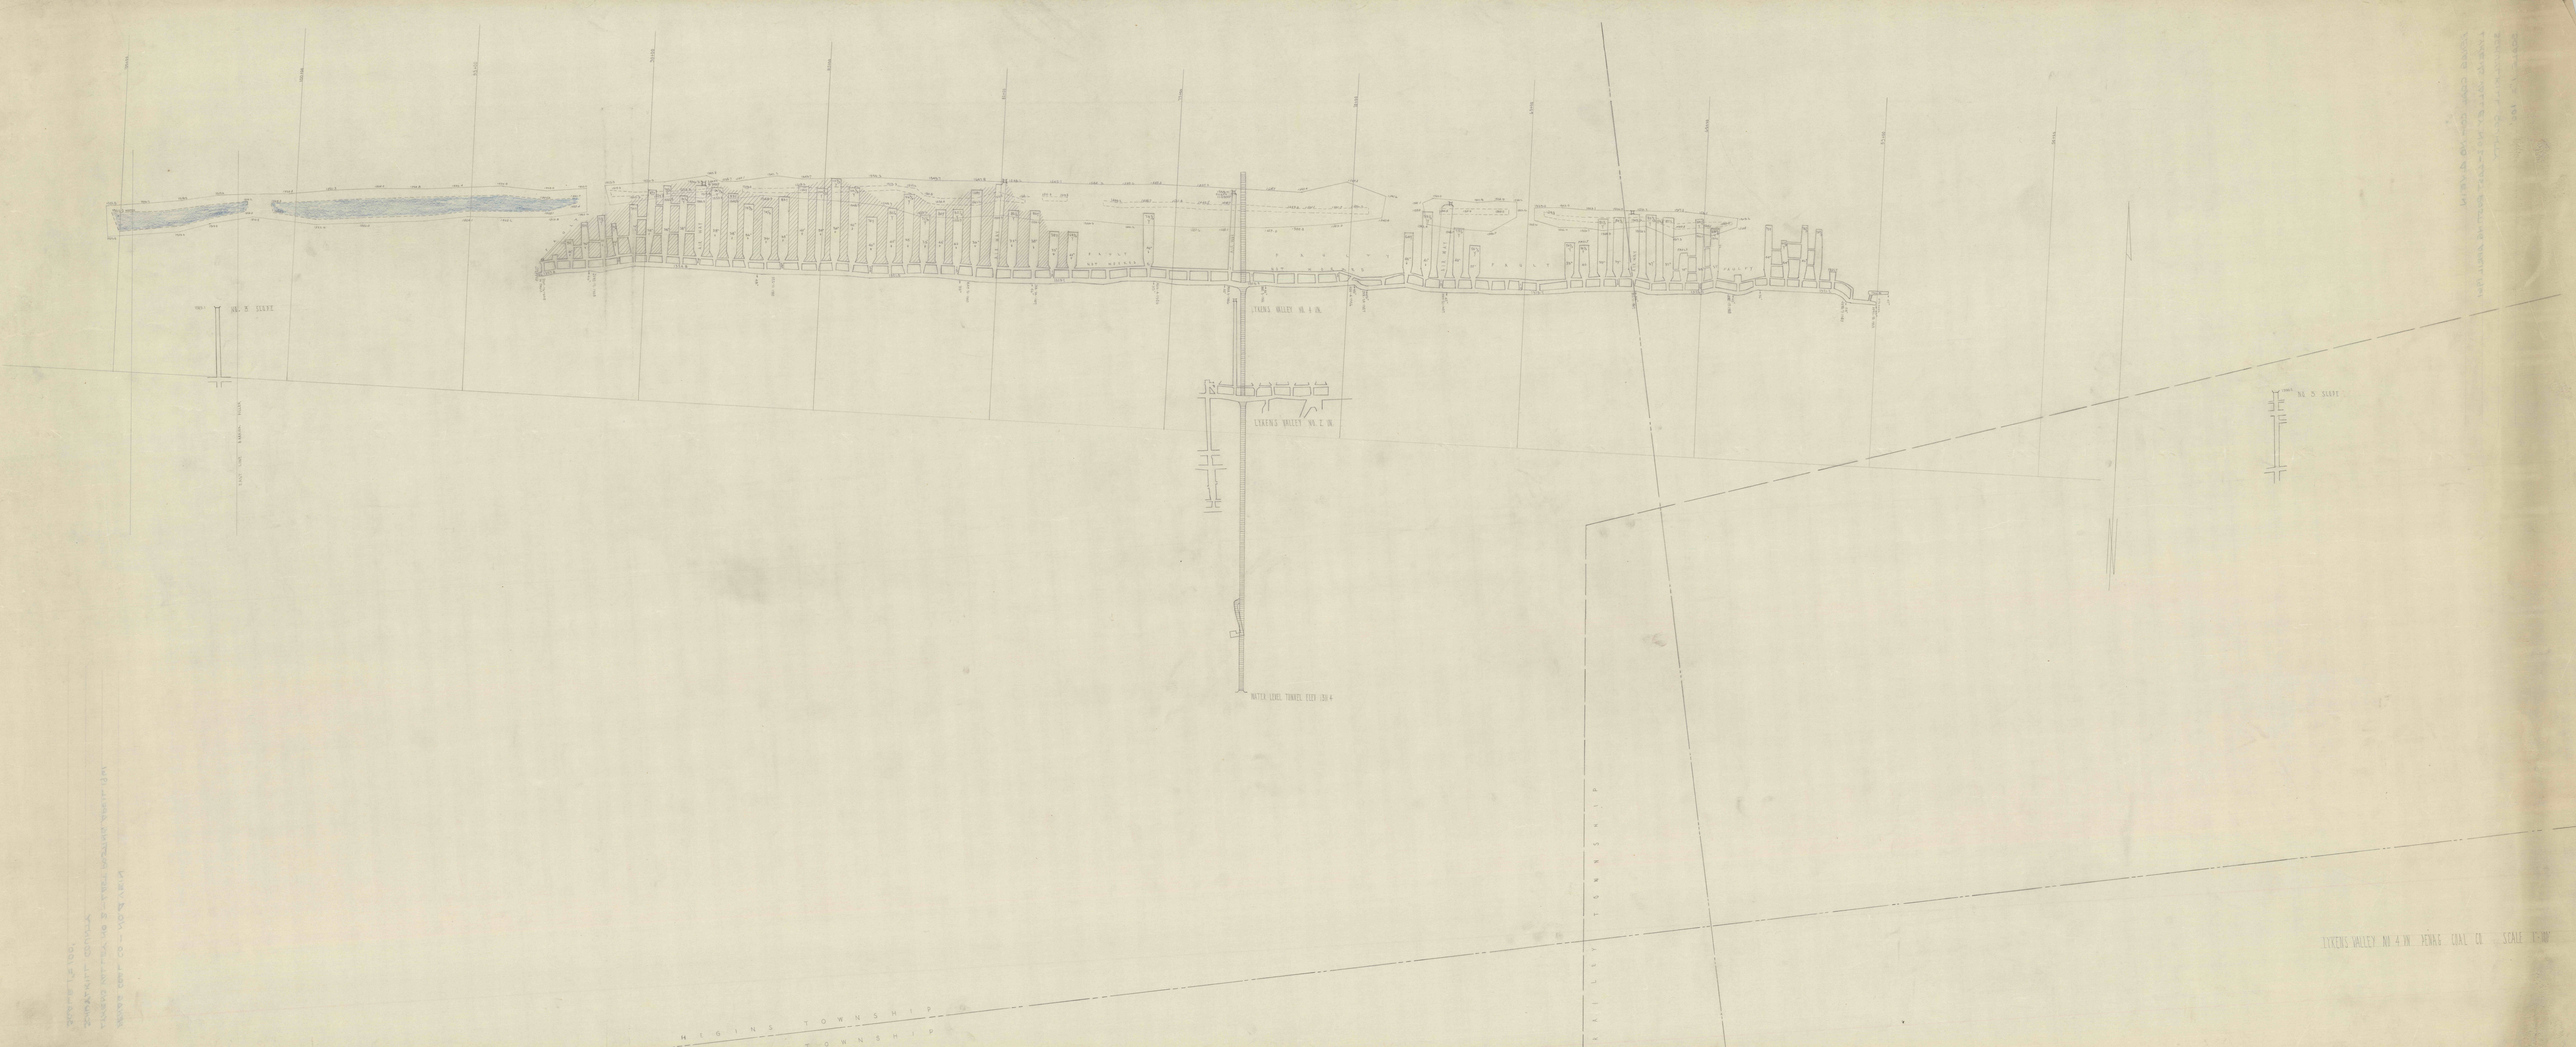
NO. 3 SLOPE
LYKENS VALLEY NO. 4 IN.
LYKENS VALLEY NO. 2 IN.
WATER LEVEL TUNNEL DEEP 1516.4
NO. 5 SLOPE
LYKENS VALLEY NO 4 IN PENNA. COAL CO. SCALE 1" = 100'
W I G I N S T O W N S H I P
A R M S T R O N G T O W N S H I P