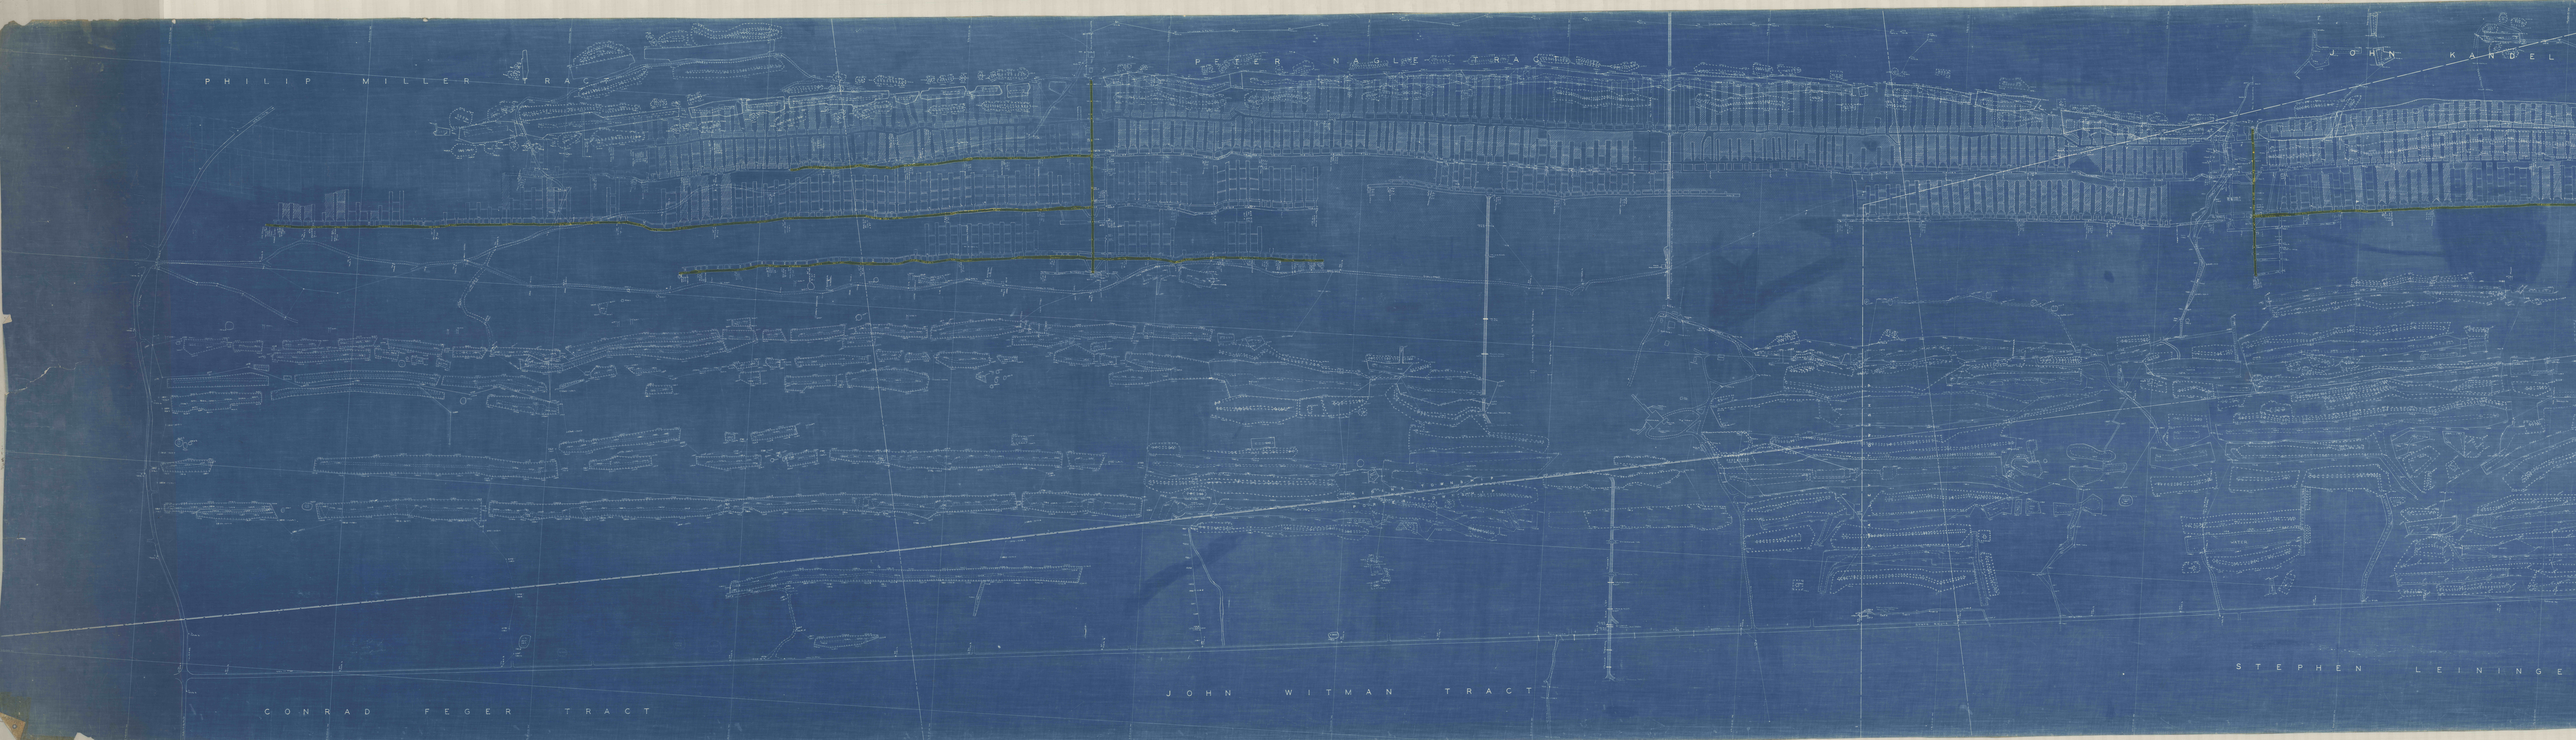

PHILIP MILLER TRACT
PETER NAGLE TRACT
JOHN KANDEL
CONRAD FEGER TRACT
JOHN WITMAN TRACT
STEPHEN LEININGE