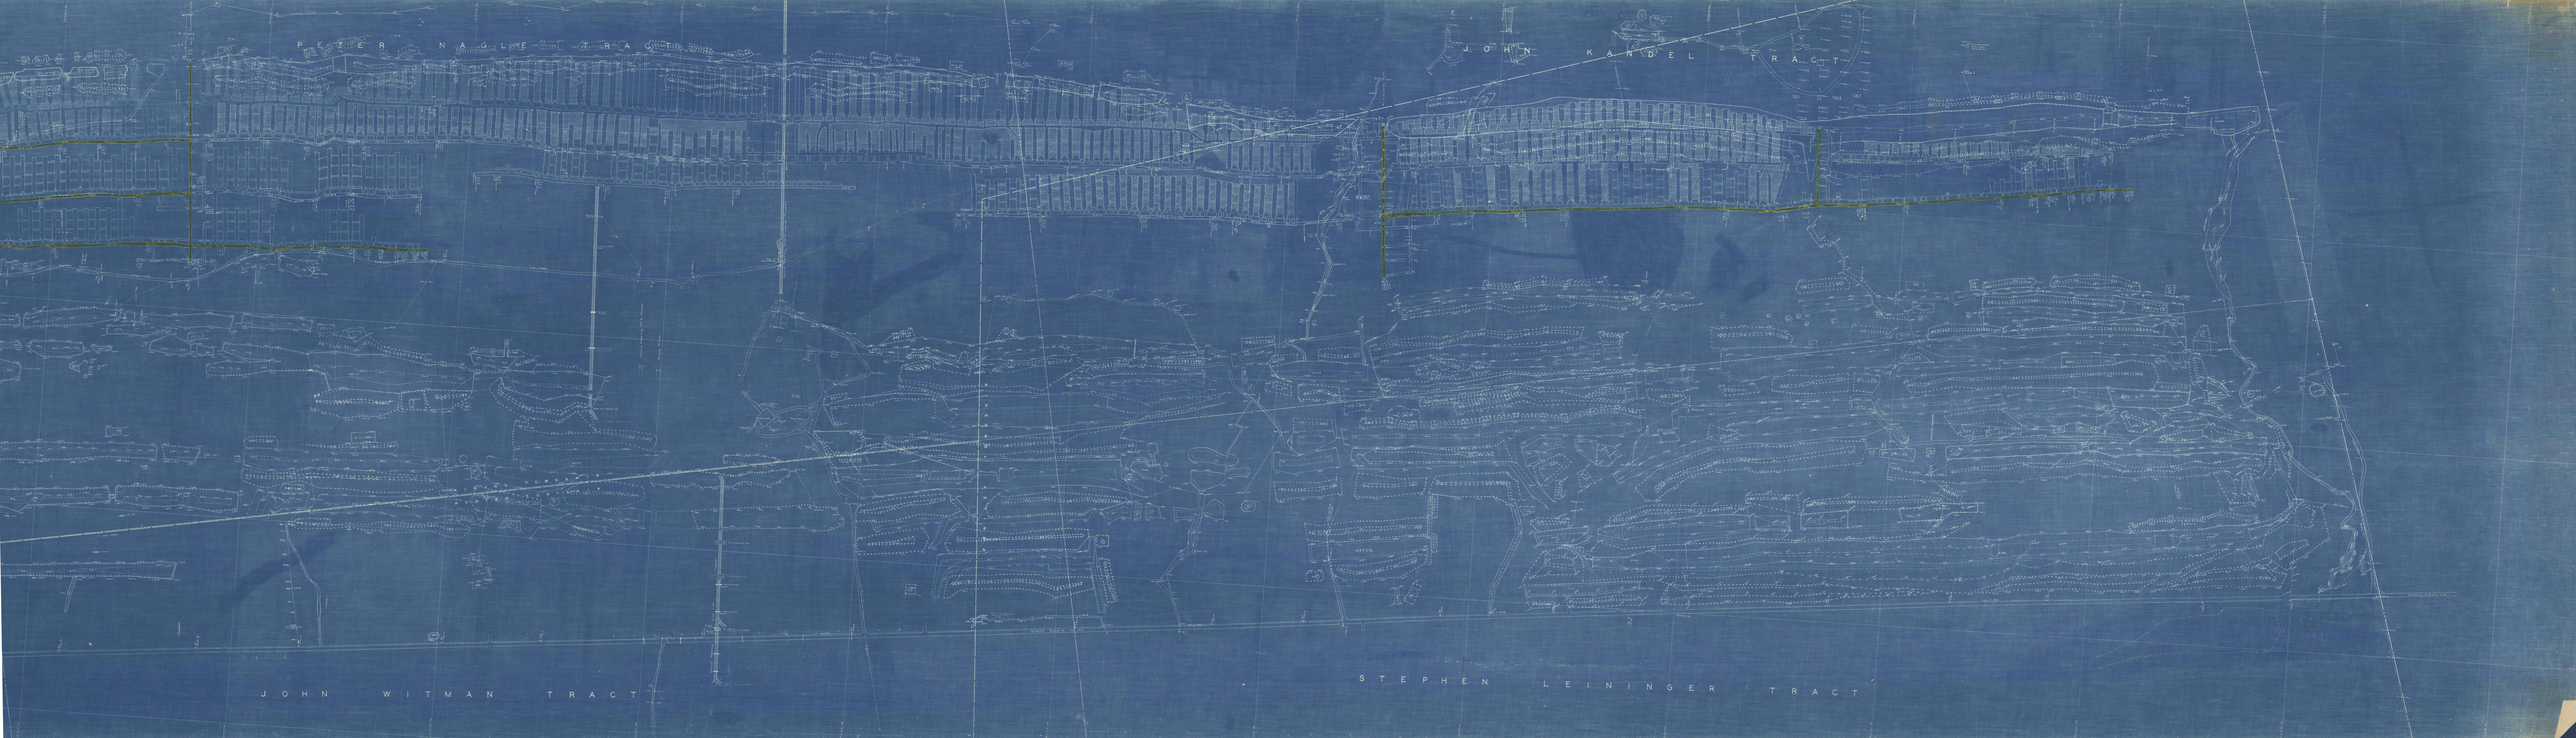
PETER NAGLE TRACT
JOHN KANDEL TRACT
JOHN WITMAN TRACT
STEPHEN LEININGER TRACT