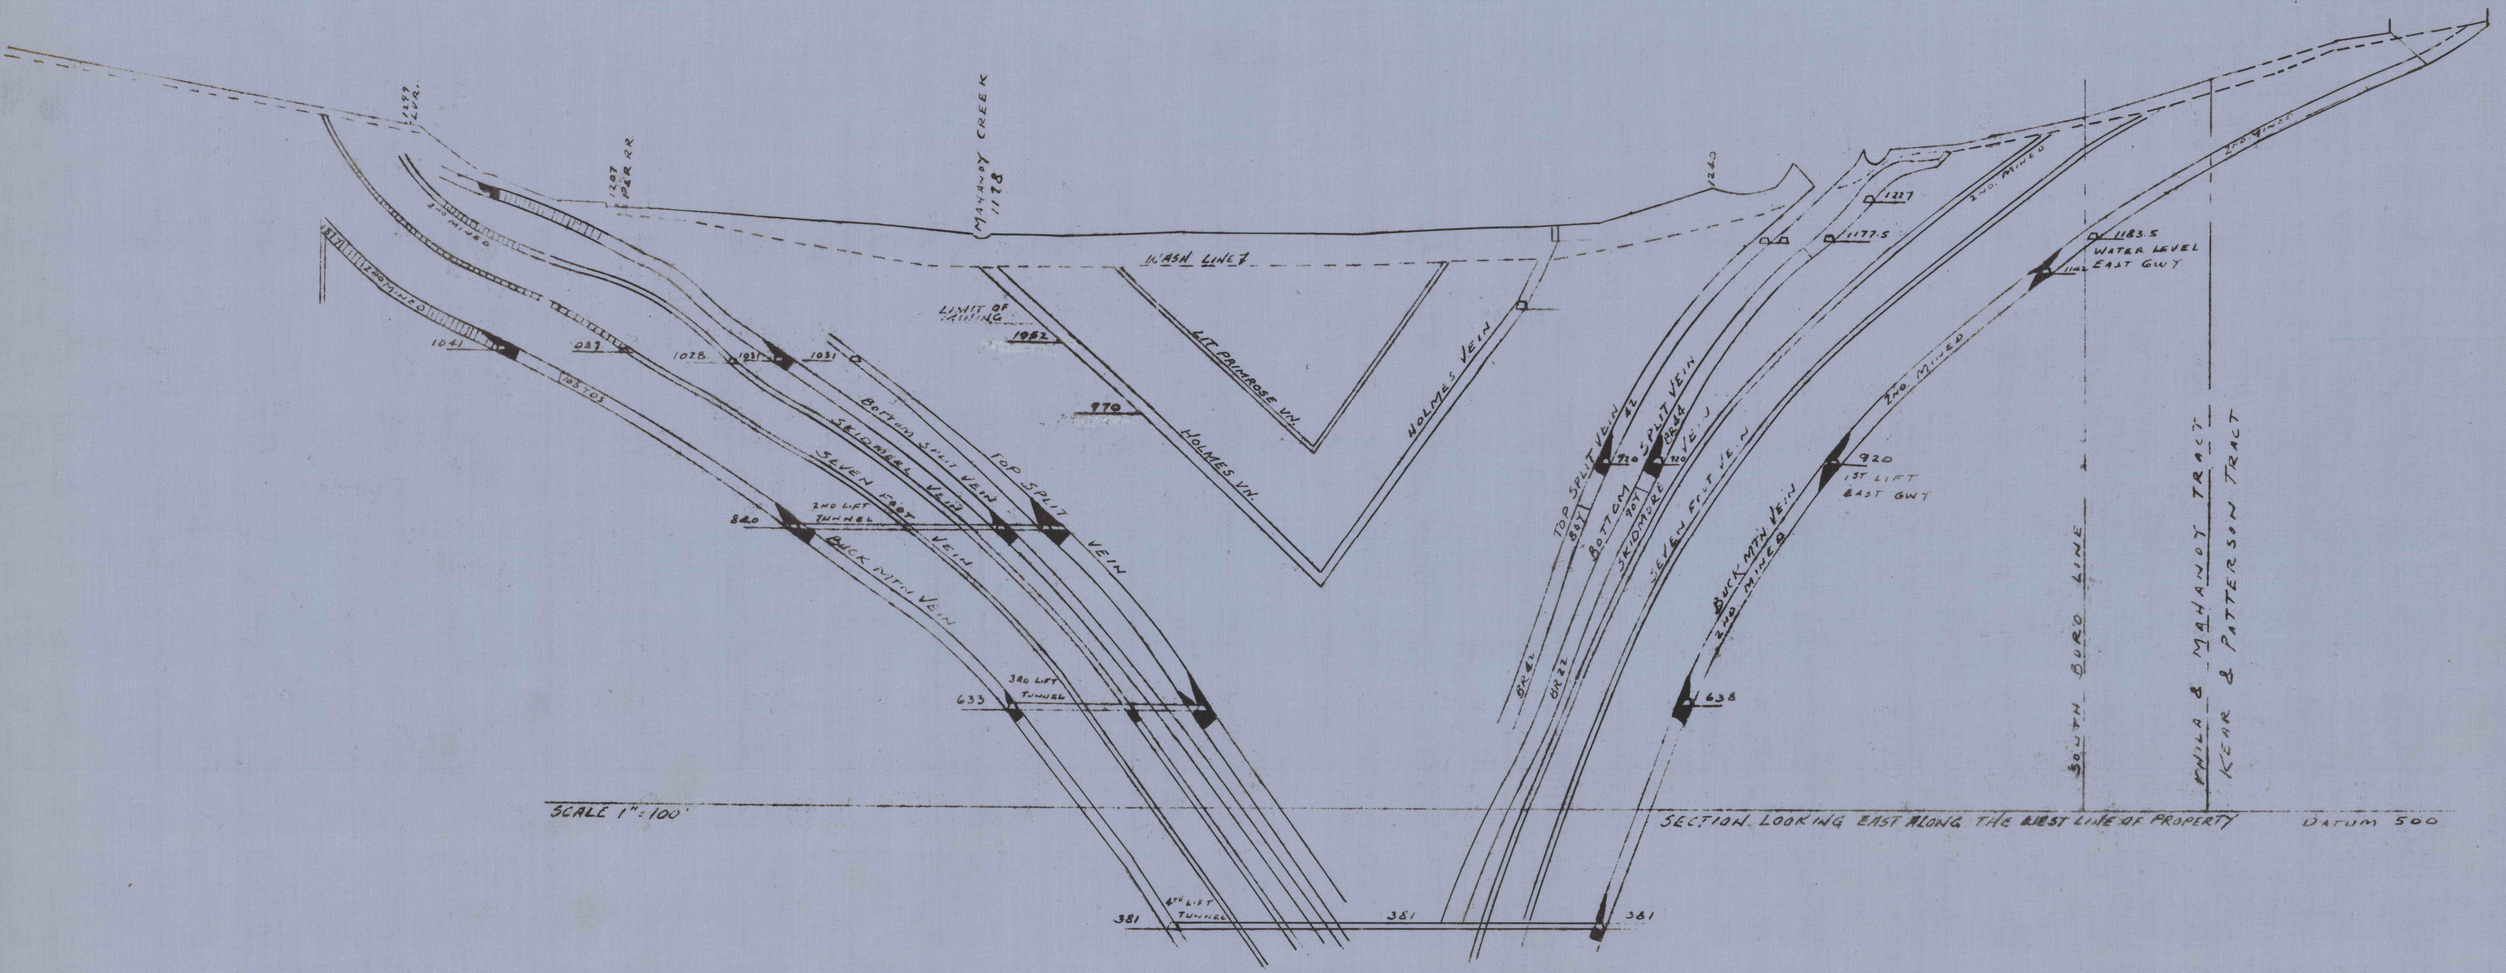
1159 LVR.
1207 P&R RR
MAHANOY CREEK
1178
WASH LINE
LIMIT OF MINING
1052
LIT PRIMROSE VN.
970
HOLMES VN.
HOLMES VEIN
1240
1227
1177.5
2ND MINED
1183.5
WATER LEVEL
EAST GWY
1142
1041
037
1028
1031
1031
BOTTOM SPLIT VEIN
SEVEN FOOT VEIN
TOP SPLIT VEIN
820
2ND LIFT TUNNEL
BUCK MTN VEIN
633
3RD LIFT TUNNEL
381
4TH LIFT TUNNEL
381
381
TOP SPLIT VEIN
837
BOTTOM SPLIT VEIN
SKIDMORE
SEVEN FOOT VEIN
BUCK MTN VEIN
2ND MINED
710
710
920
1ST LIFT
EAST GWY
638
SOUTH BORD LINE
MAHLA & MAHANOY TRACT
KEHR & PATTERSON TRACT
SCALE 1" = 100'
SECTION LOOKING EAST ALONG THE WEST LINE OF PROPERTY
DATUM 500