


WANAMIE COLLIERY  
SCALE 1"=100'

F-162-2

F-162-2

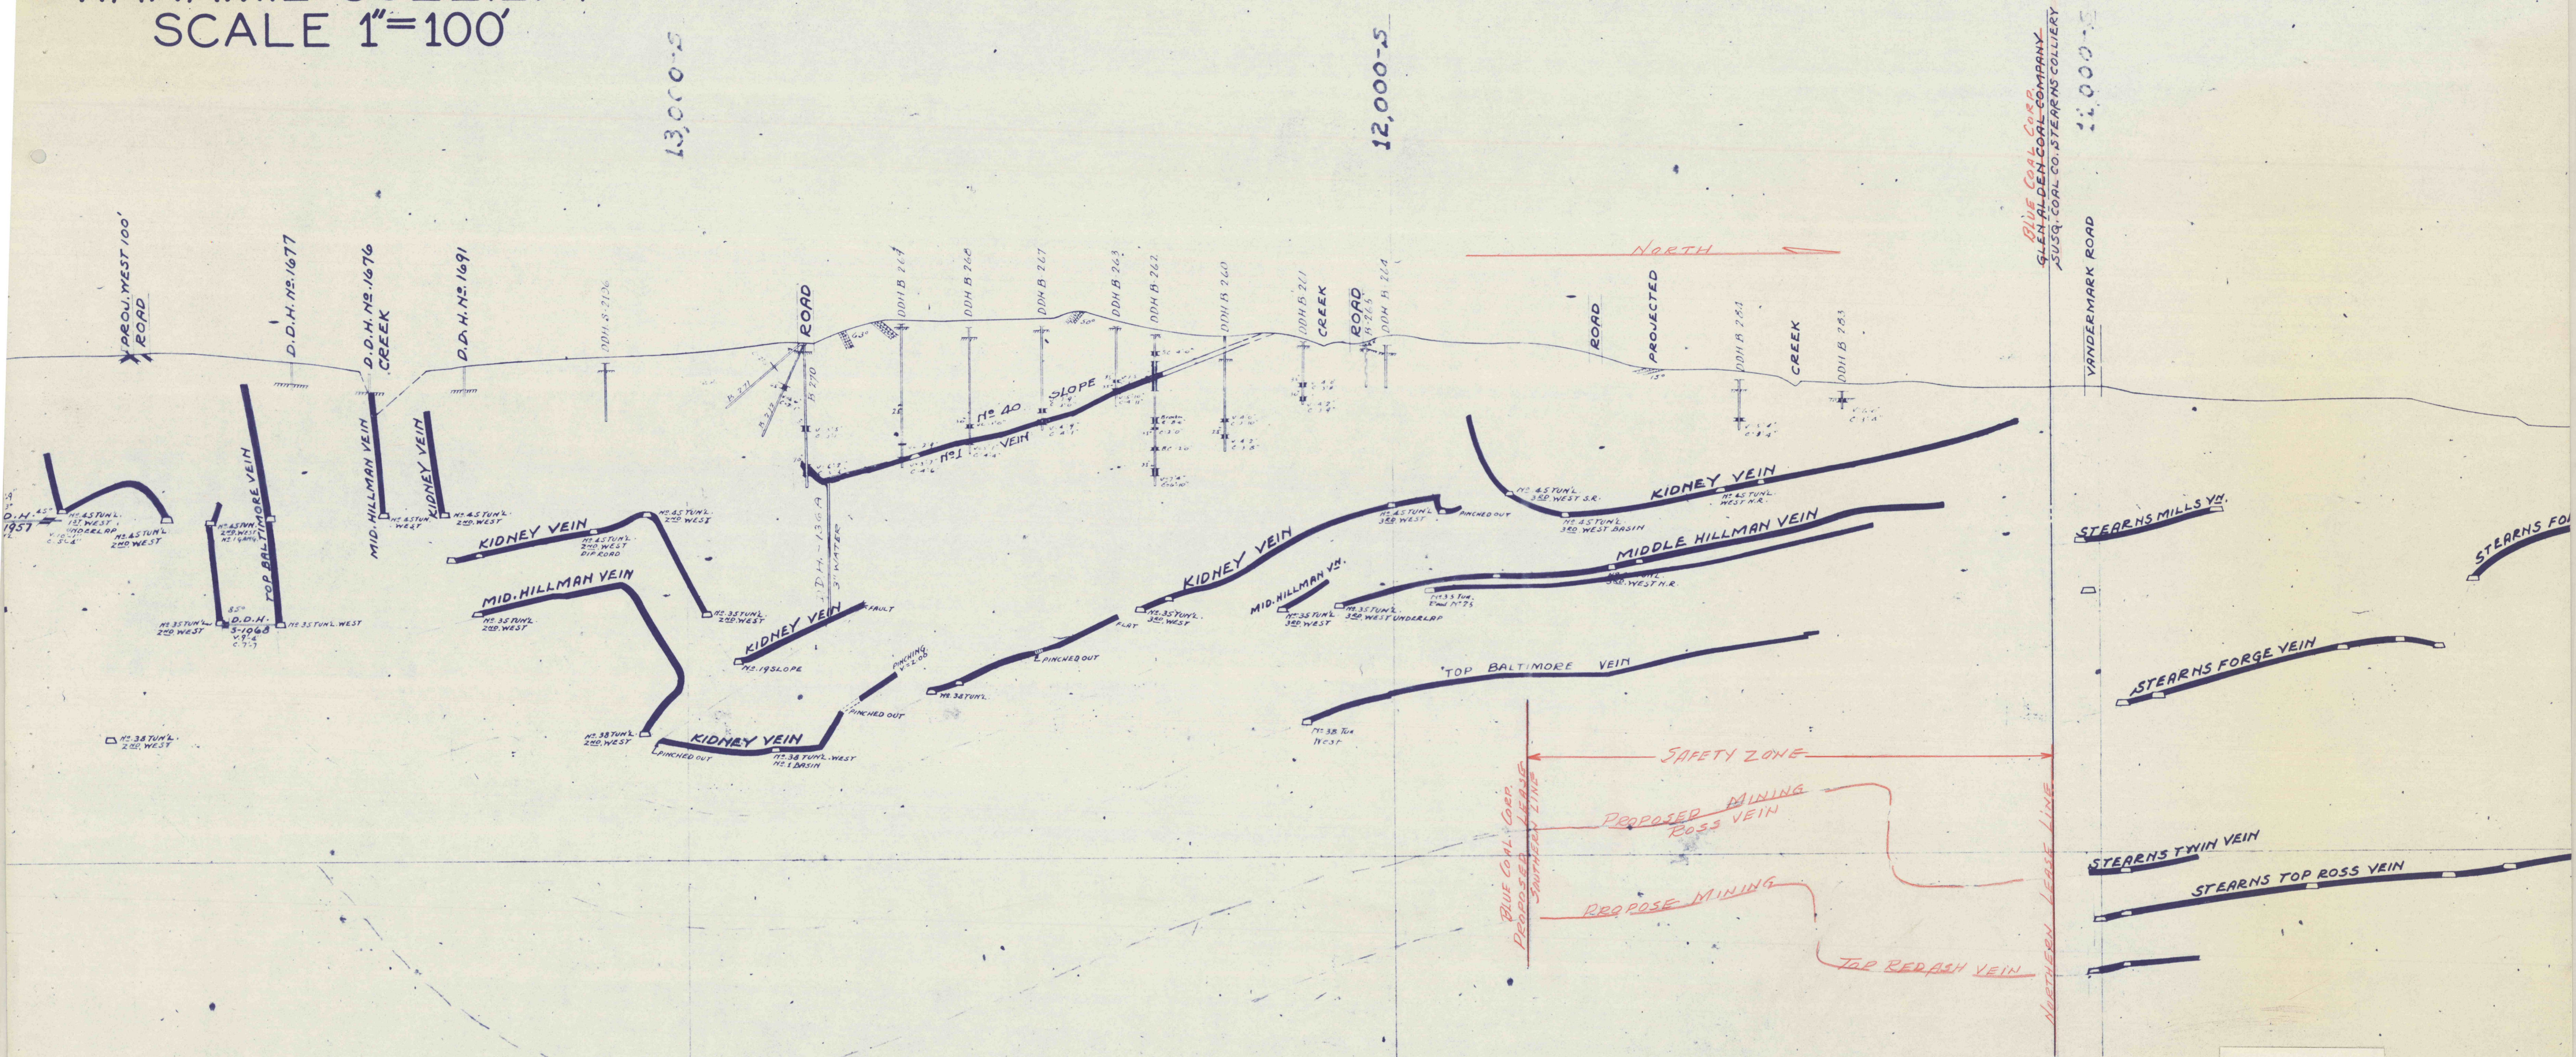


CROSS SECTION F-162-2  
Scale 1" = 100'

F-162-2

F-162-2

Approved <i>Amel Arcentine</i> President Glen Nan Coal Company Date <u>5/1/69</u>	Approved <i>[Signature]</i> Registered Mining Engineer Glen Nan Coal Company Date <u>5/1/69</u>
Approved <i>[Signature]</i> Registered Mining Engineer Pa. Dept. Mines & Mineral Industries Date <u>8-26-69</u>	AUTHORIZED
Approved <i>[Signature]</i> Deputy Secretary Pa. Dept. Mines & Mineral Industries Date <u>8-26-69</u>	Approved <i>[Signature]</i> District Inspector Pa. Dept. Mines & Mineral Industries Date <u>7/23/69</u>
	Approved <i>[Signature]</i> Secretary Pa. Dept. Mines & Mineral Industries Date <u>OCT 22 1969</u>

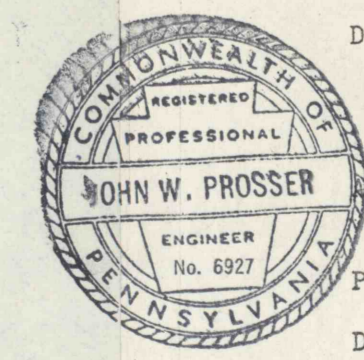

dms.