


\$42

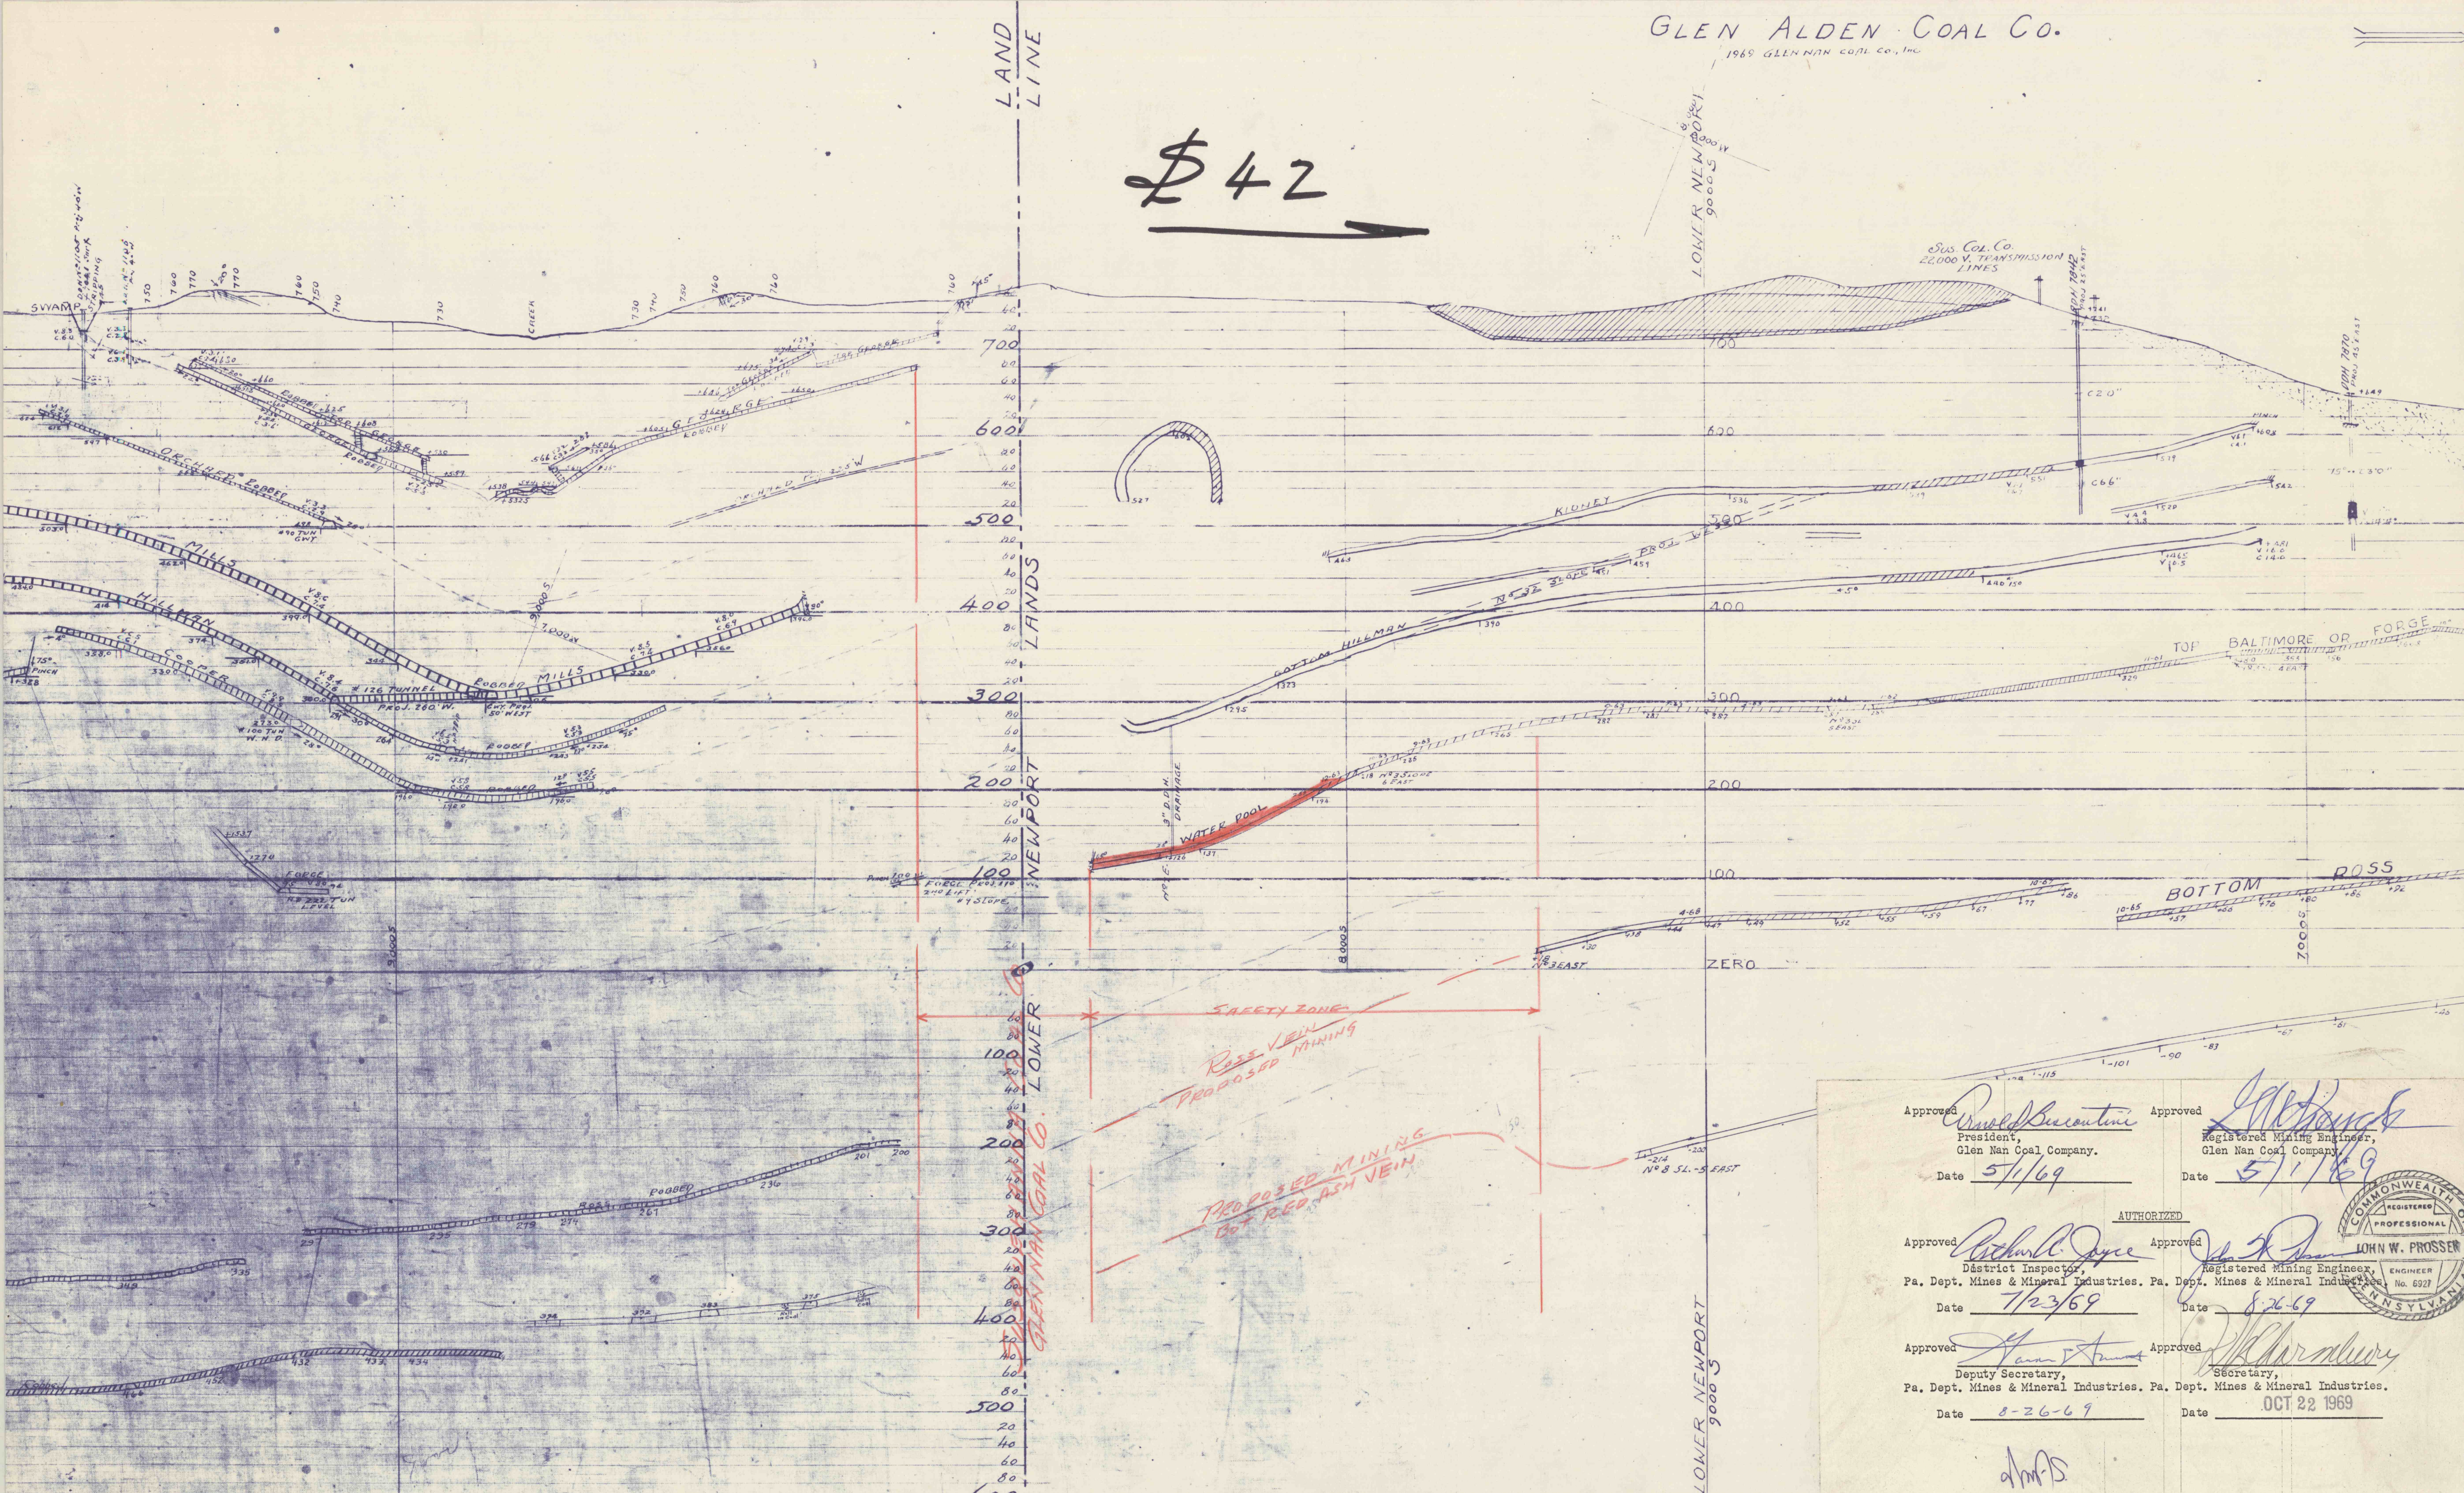

Approved *Arnold Buccantini*
President,
Glen Nan Coal Company.
Date 5/1/69

Approved *J. J. [Signature]*
Registered Mining Engineer,
Glen Nan Coal Company.
Date 5/1/69

Approved *Richard C. Joyce*
District Inspector,
Pa. Dept. Mines & Mineral Industries.
Date 7/23/69

Approved *John W. Prosser*
Registered Mining Engineer,
Pa. Dept. Mines & Mineral Industries.
Date 8-26-69

Approved *[Signature]*
Deputy Secretary,
Pa. Dept. Mines & Mineral Industries.
Date 8-26-69

Approved *[Signature]*
Secretary,
Pa. Dept. Mines & Mineral Industries.
Date OCT 22 1969

