



3

\$43 →

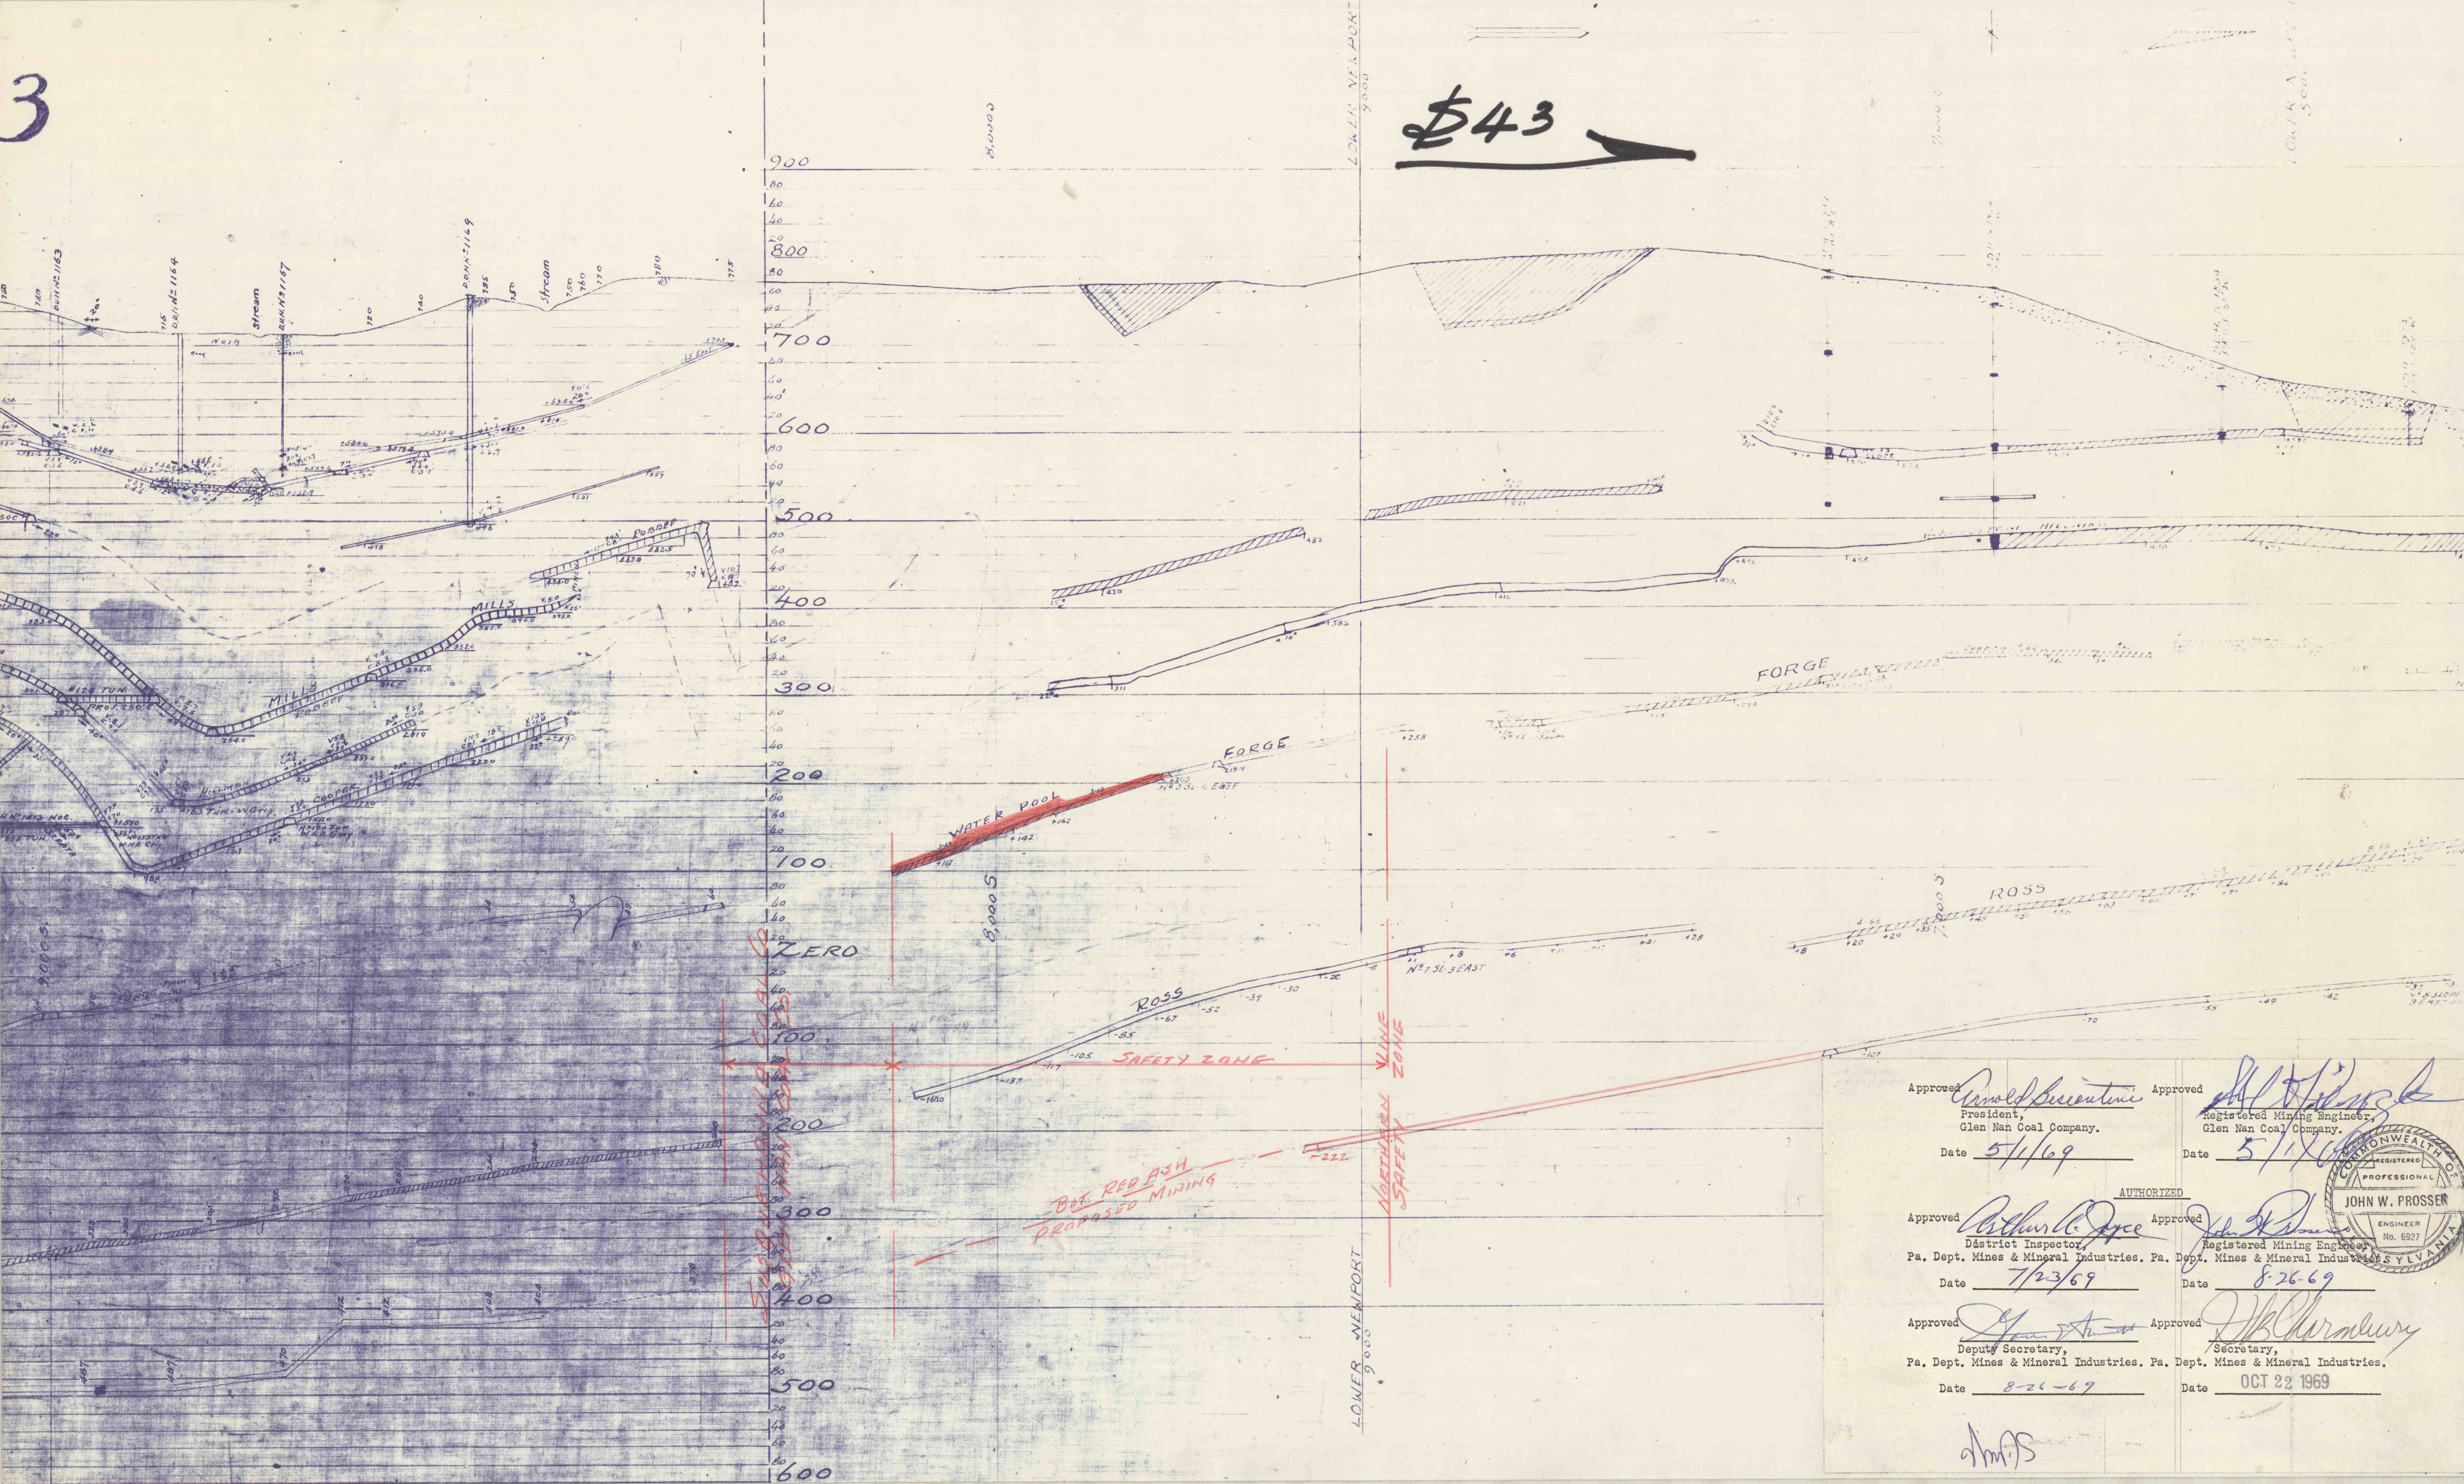

Approved <u>Arnold Succentini</u> President, Glen Nan Coal Company. Date <u>5/1/69</u>	Approved <u>[Signature]</u> Registered Mining Engineer, Glen Nan Coal Company. Date <u>5/1/69</u>
Approved <u>Arthur C. Joyce</u> District Inspector, Pa. Dept. Mines & Mineral Industries. Pa. Dept. Mines & Mineral Industries. Date <u>7/23/69</u>	Approved <u>[Signature]</u> Registered Mining Engineer, Pa. Dept. Mines & Mineral Industries. Pa. Dept. Mines & Mineral Industries. Date <u>8-26-69</u>
Approved <u>[Signature]</u> Deputy Secretary, Pa. Dept. Mines & Mineral Industries. Pa. Dept. Mines & Mineral Industries. Date <u>8-26-69</u>	Approved <u>[Signature]</u> Secretary, Pa. Dept. Mines & Mineral Industries. Pa. Dept. Mines & Mineral Industries. Date <u>OCT 22 1969</u>

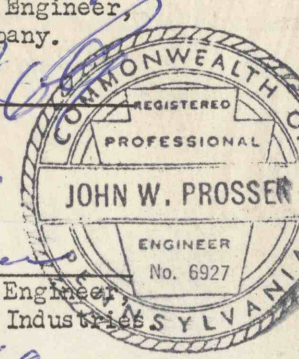

Handwritten initials