


\$44

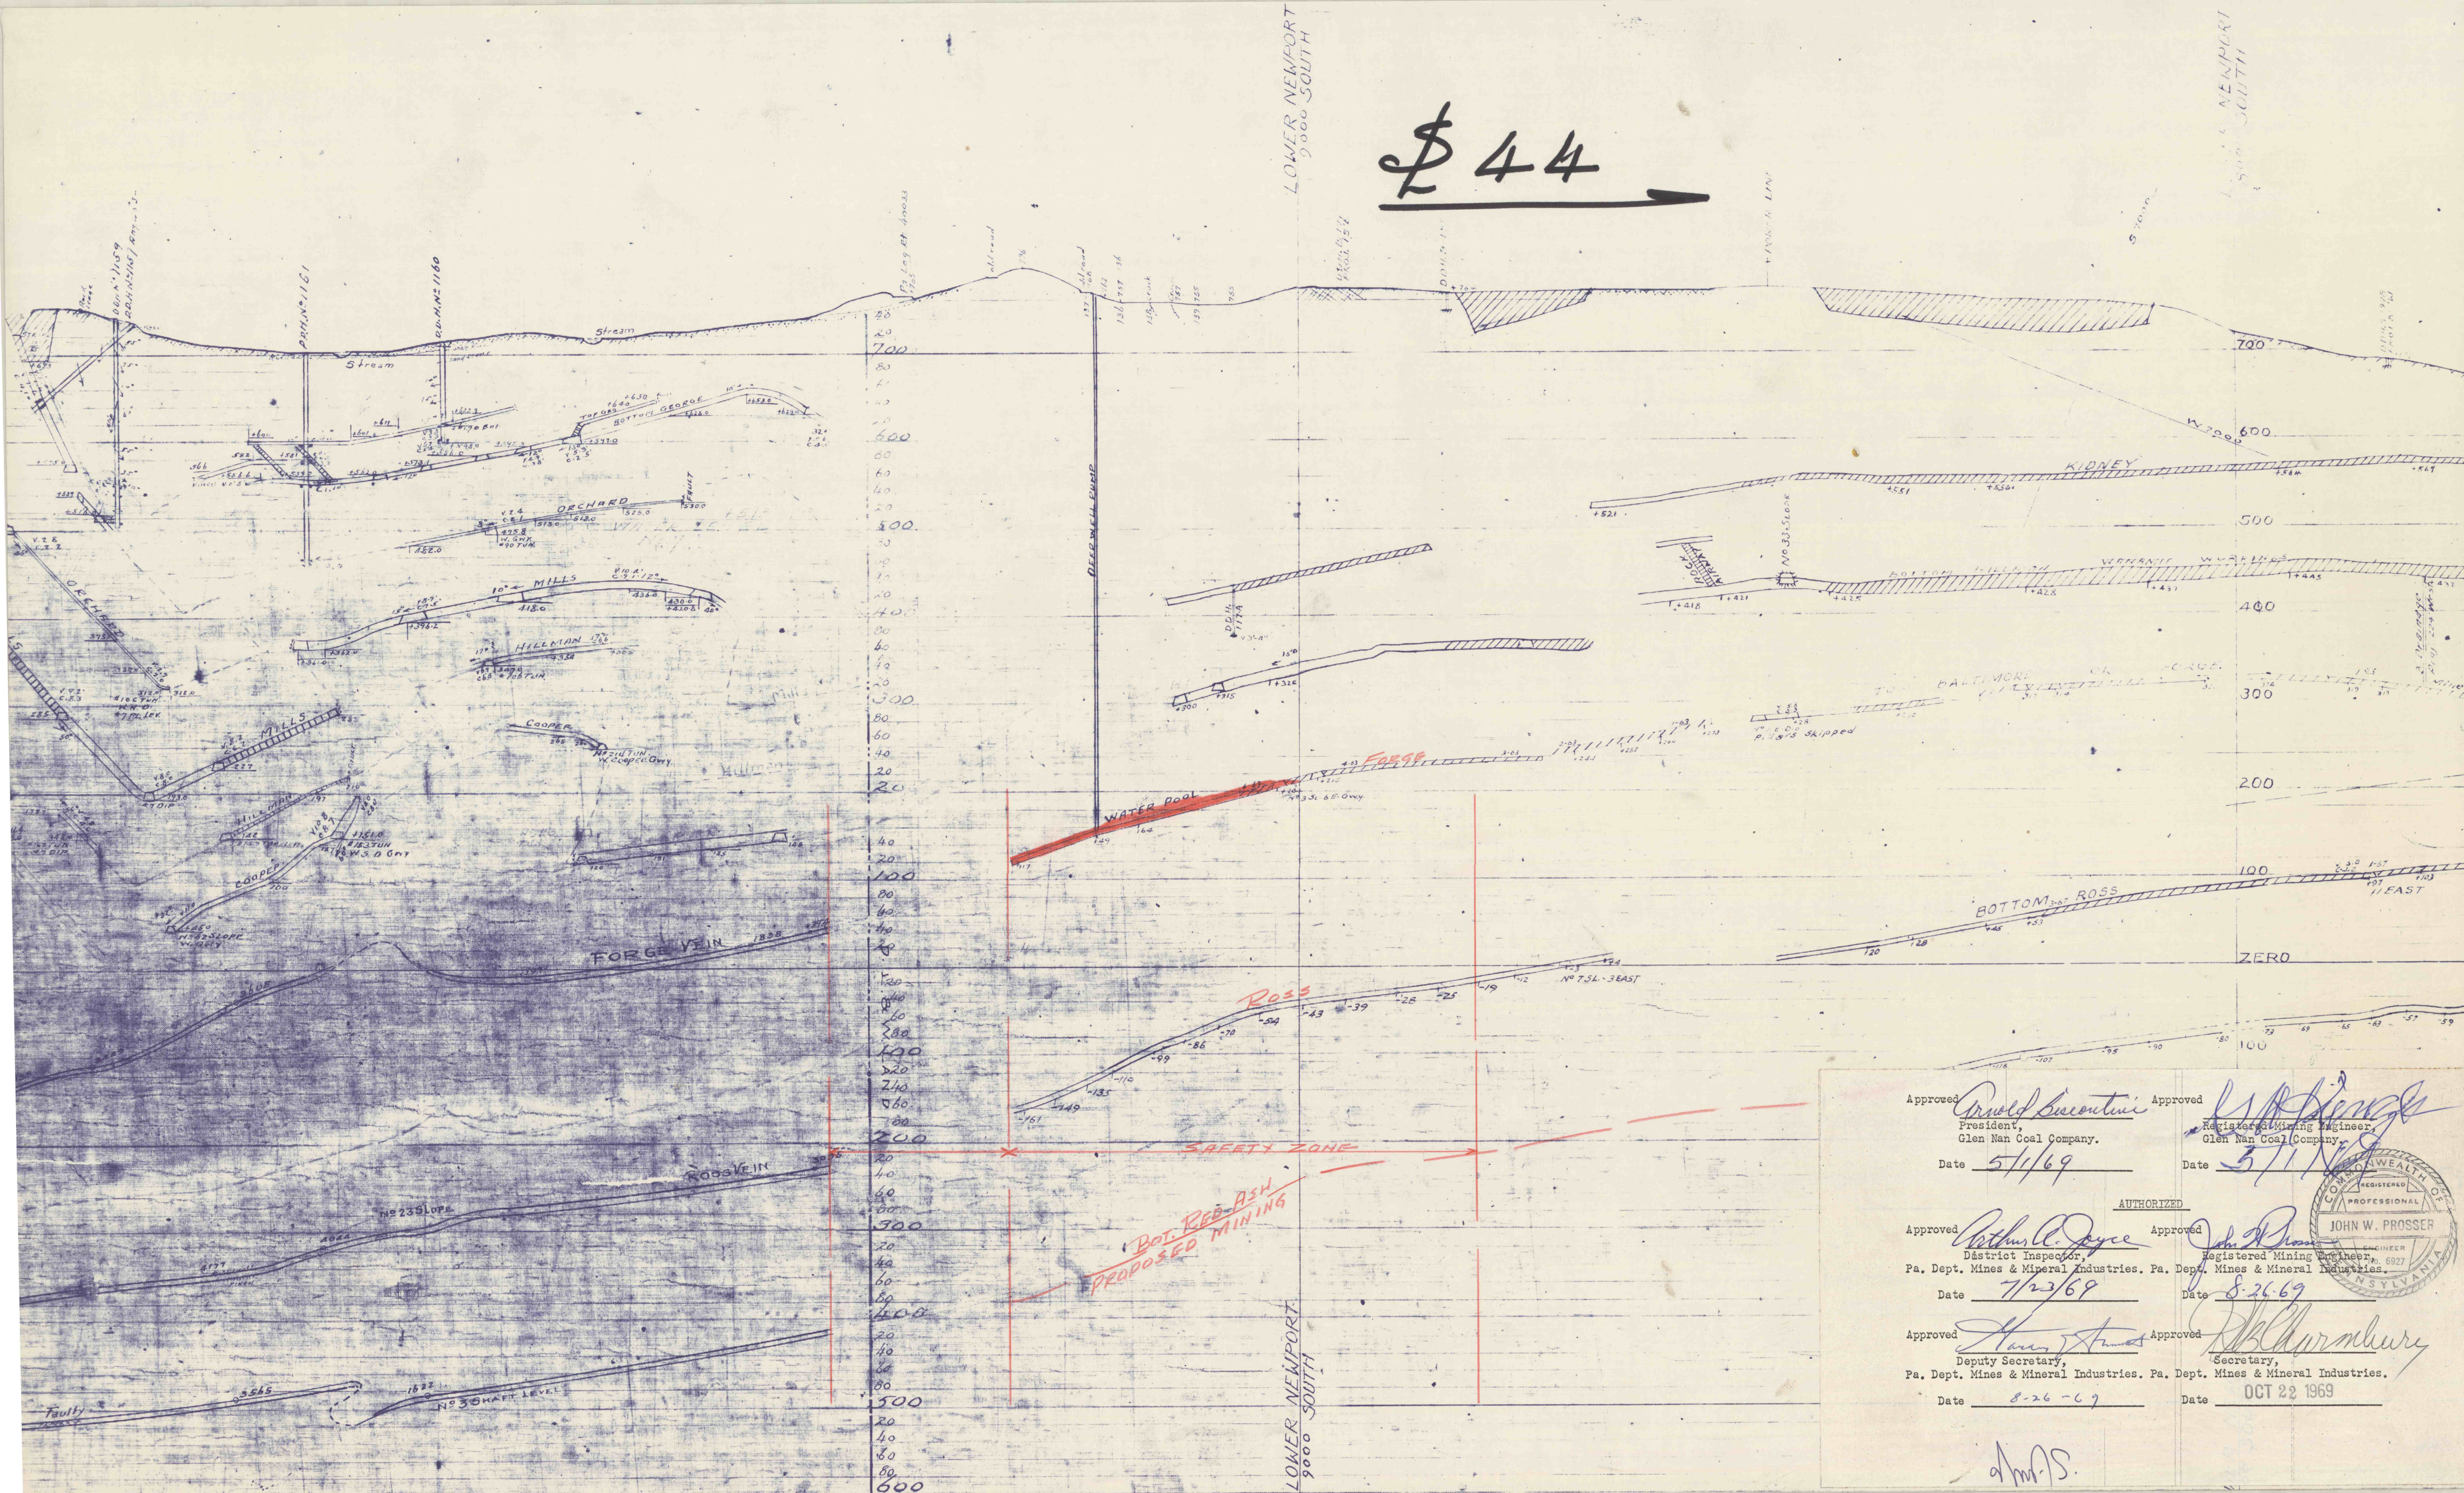

Approved *Arnold Sweetman*
President,
Glen Nan Coal Company.
Date 5/1/69


Approved *L.S. Dinges*
Registered Mining Engineer,
Glen Nan Coal Company.
Date 5/1/69

Approved *Arthur C. Joyce*
District Inspector,
Pa. Dept. Mines & Mineral Industries.
Date 7/23/69

AUTHORIZED
Approved *John P. Ross*
Registered Mining Engineer,
Pa. Dept. Mines & Mineral Industries.
Date 8-26-69

Approved *Henry Stans*
Deputy Secretary,
Pa. Dept. Mines & Mineral Industries.
Date 8-26-69

Approved *R.B. Churnbury*
Secretary,
Pa. Dept. Mines & Mineral Industries.
Date OCT 22 1969

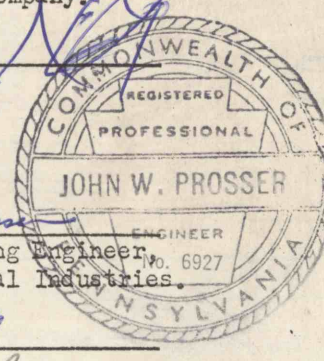

dm.s.