


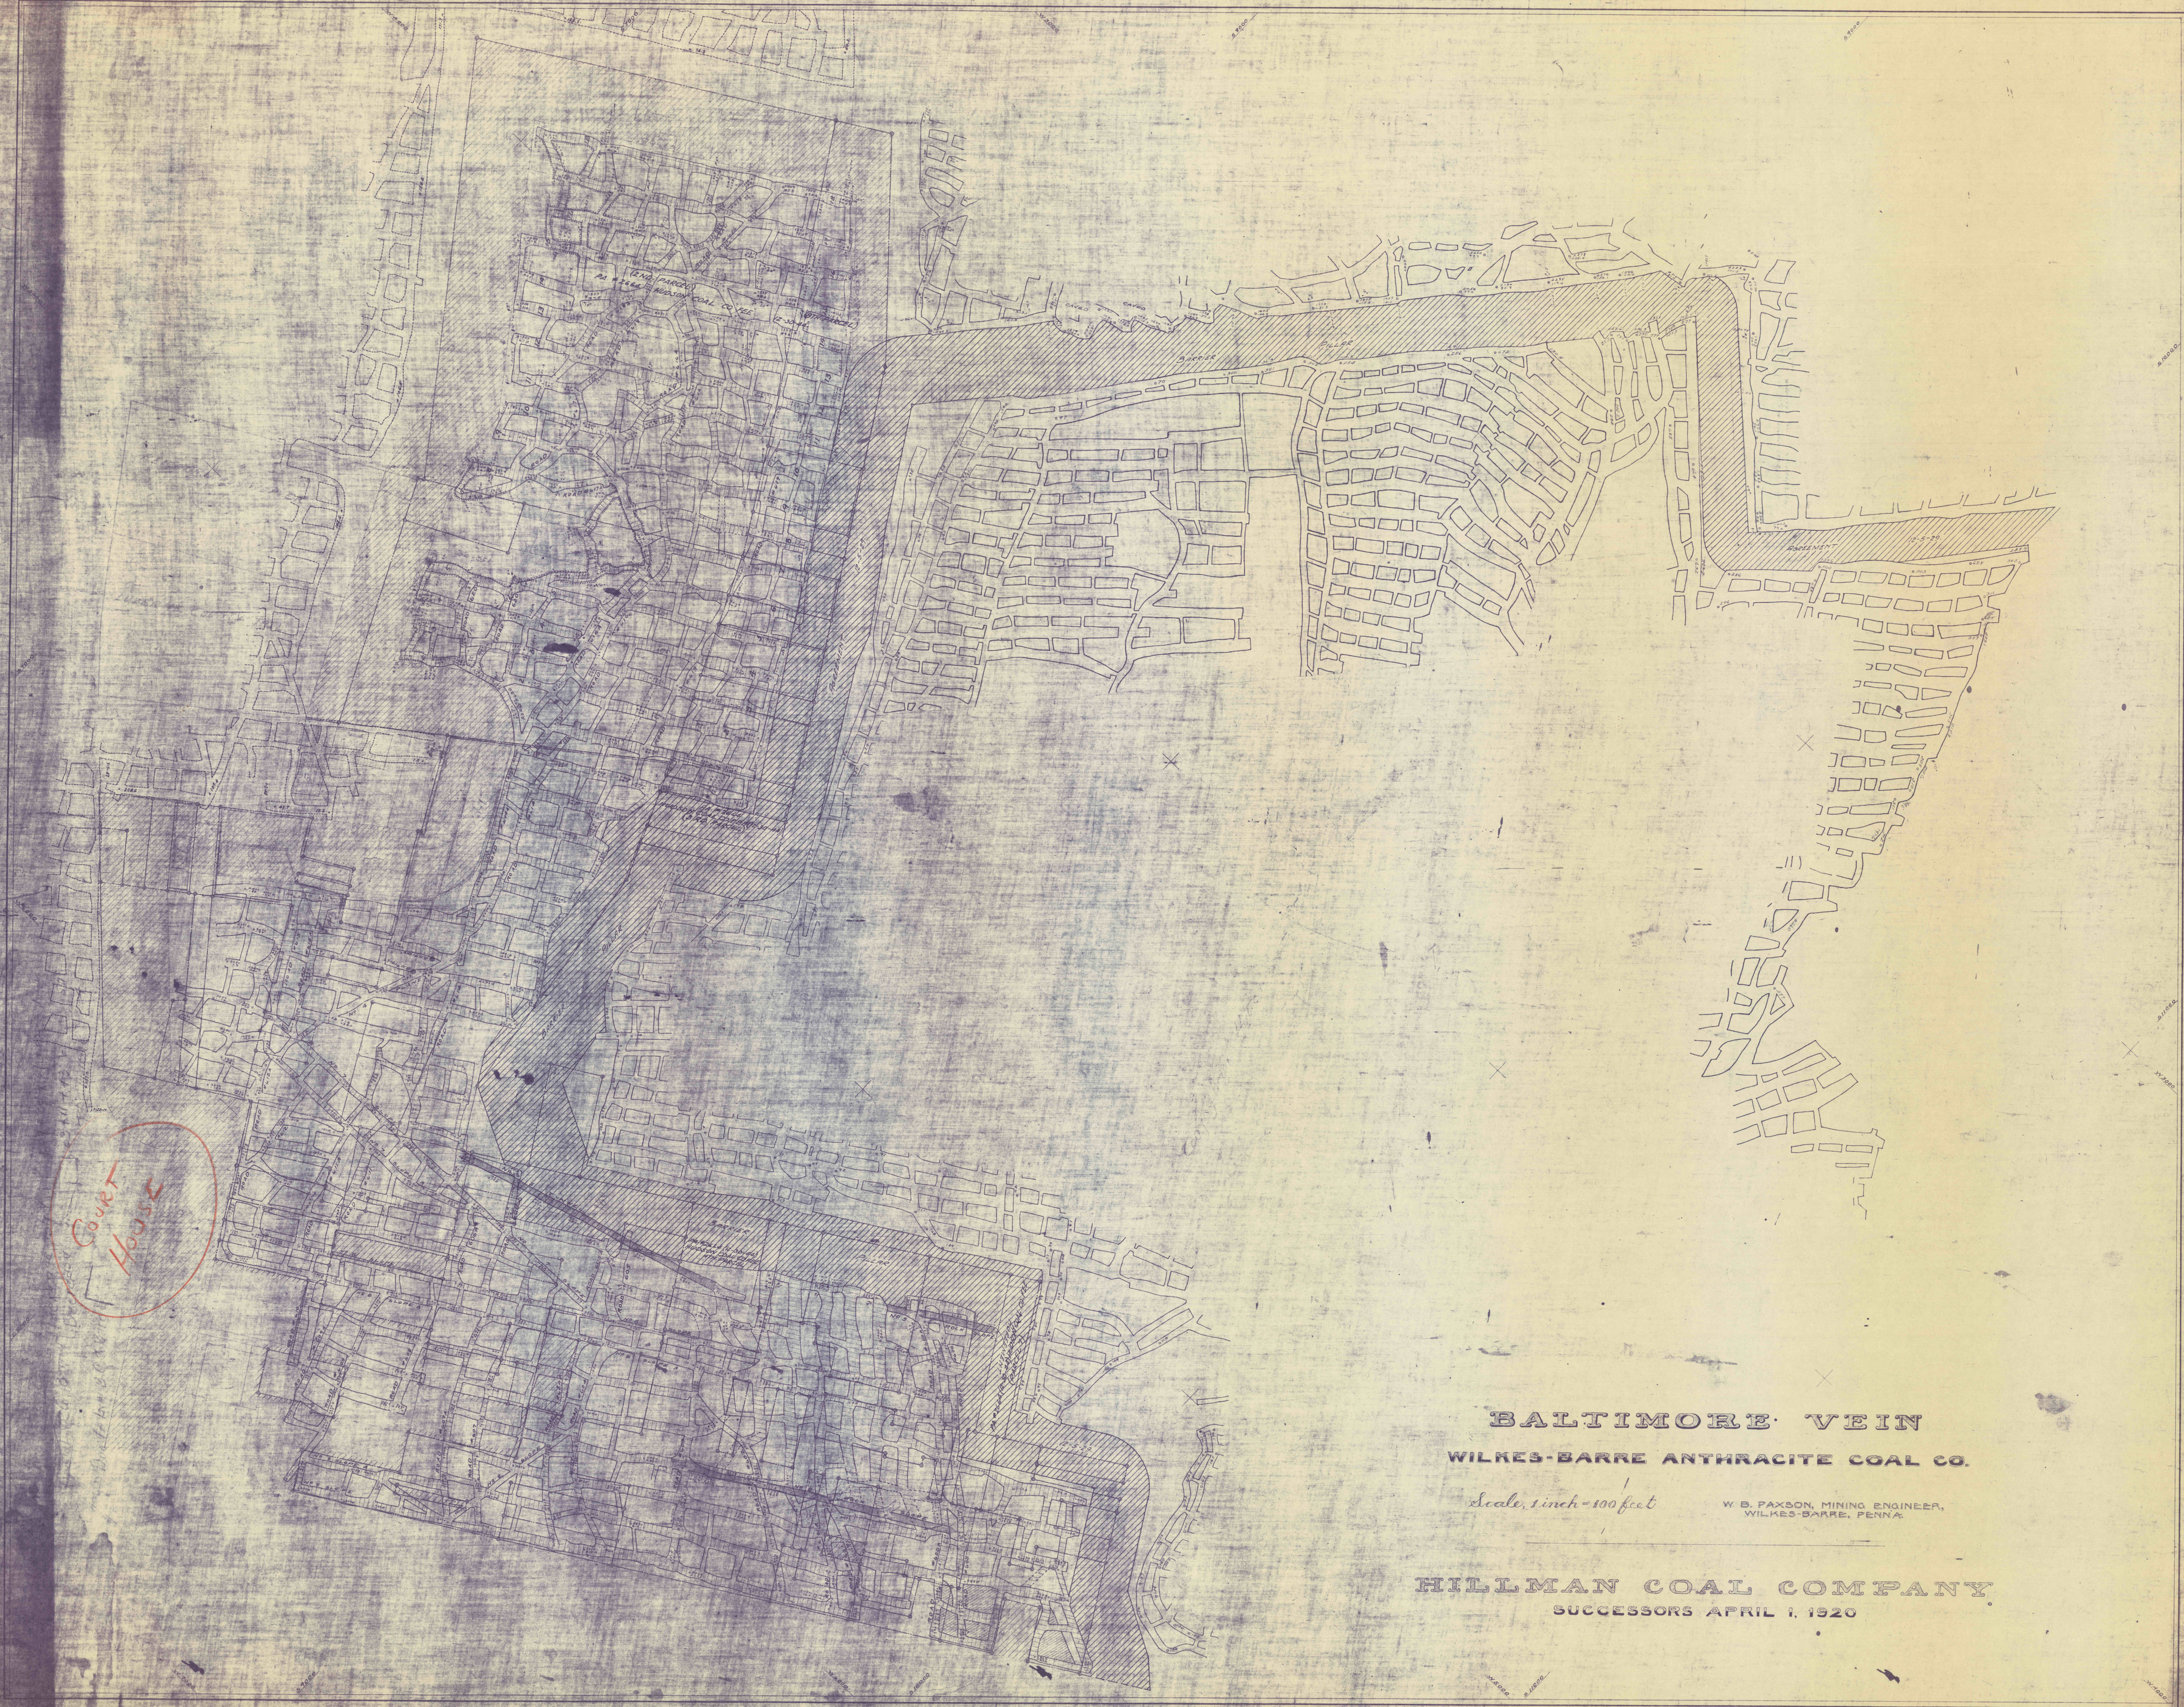

BALTIMORE VEIN
WILKES-BARRE ANTHRACITE COAL CO.

Scale, 1 inch = 100 feet

W. B. PAXSON, MINING ENGINEER,
WILKES-BARRE, PENNA.

HILLMAN COAL COMPANY
SUCCESSORS APRIL 1, 1920