



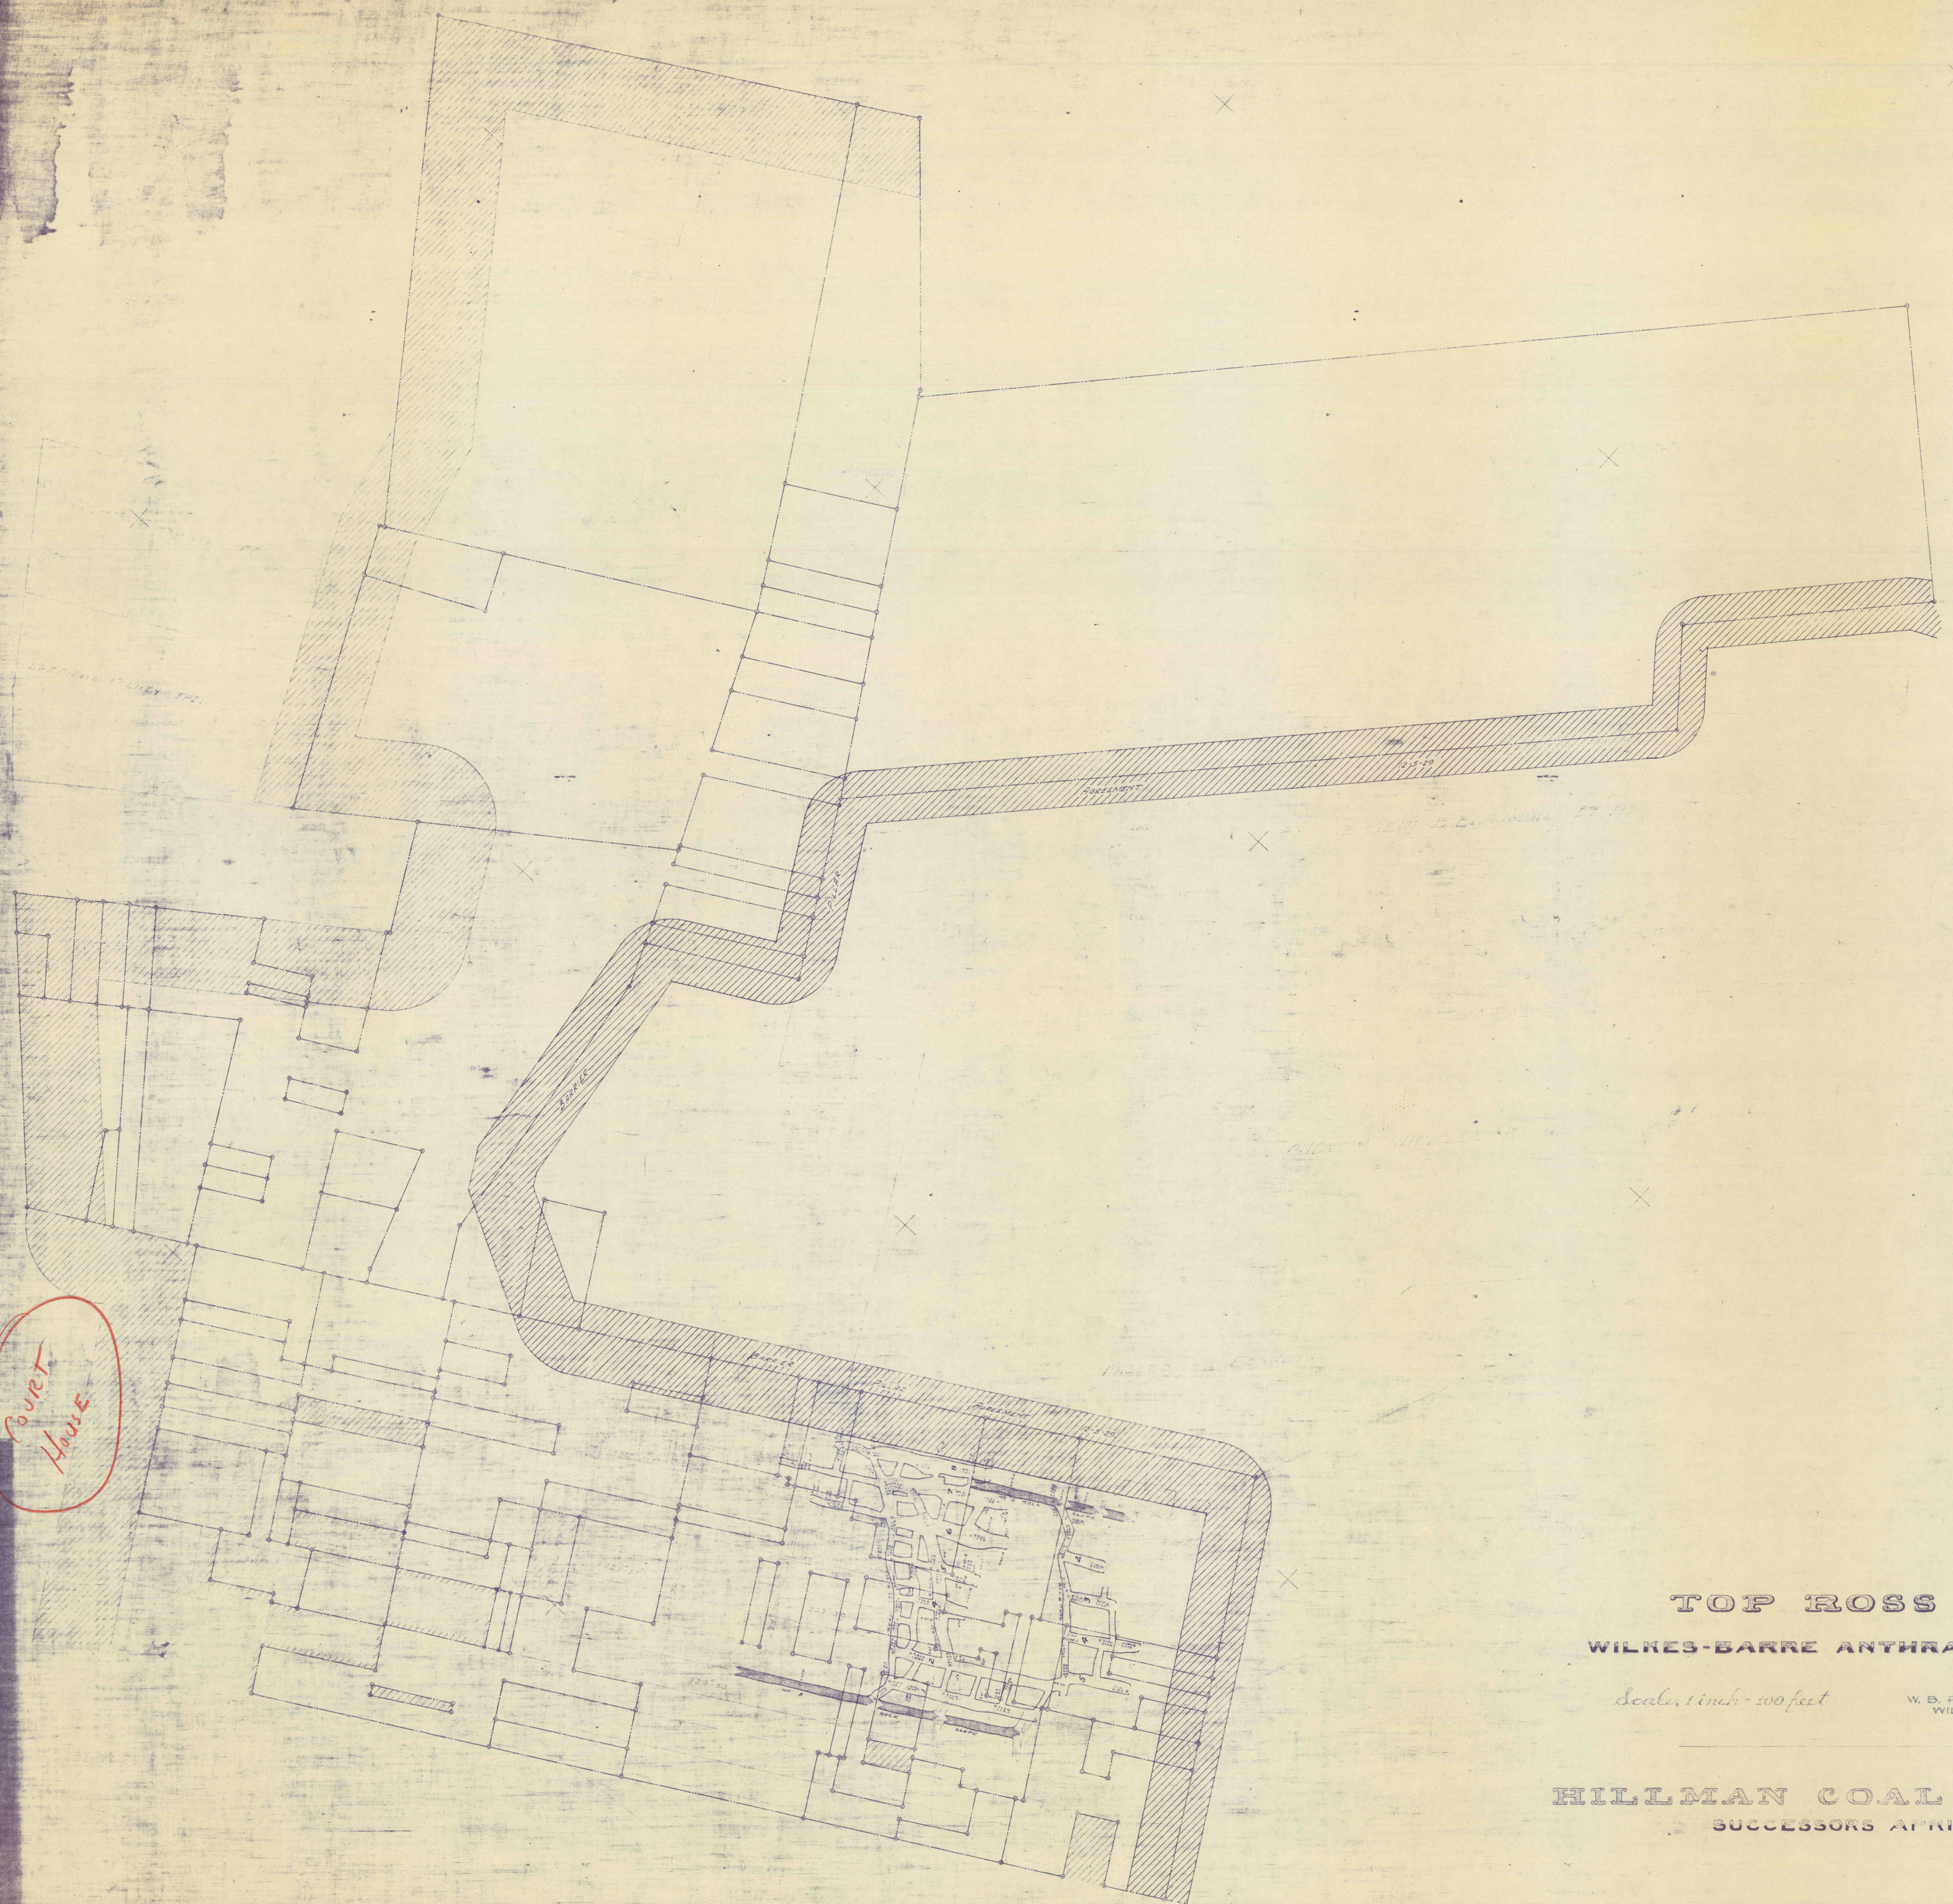

TOP ROSS VEIN
WILKES-BARRE ANTHRACITE COAL CO.


W. B. PARSON, MINING ENGINEER,
WILKES BARRE, PENNA.

HILLMAN COAL COMPANY
SUCCESSORS APRIL 1, 1920