


TOWER CITY 1"=100'

SHEET 5665 II SE
A.M.S. SERIES V831

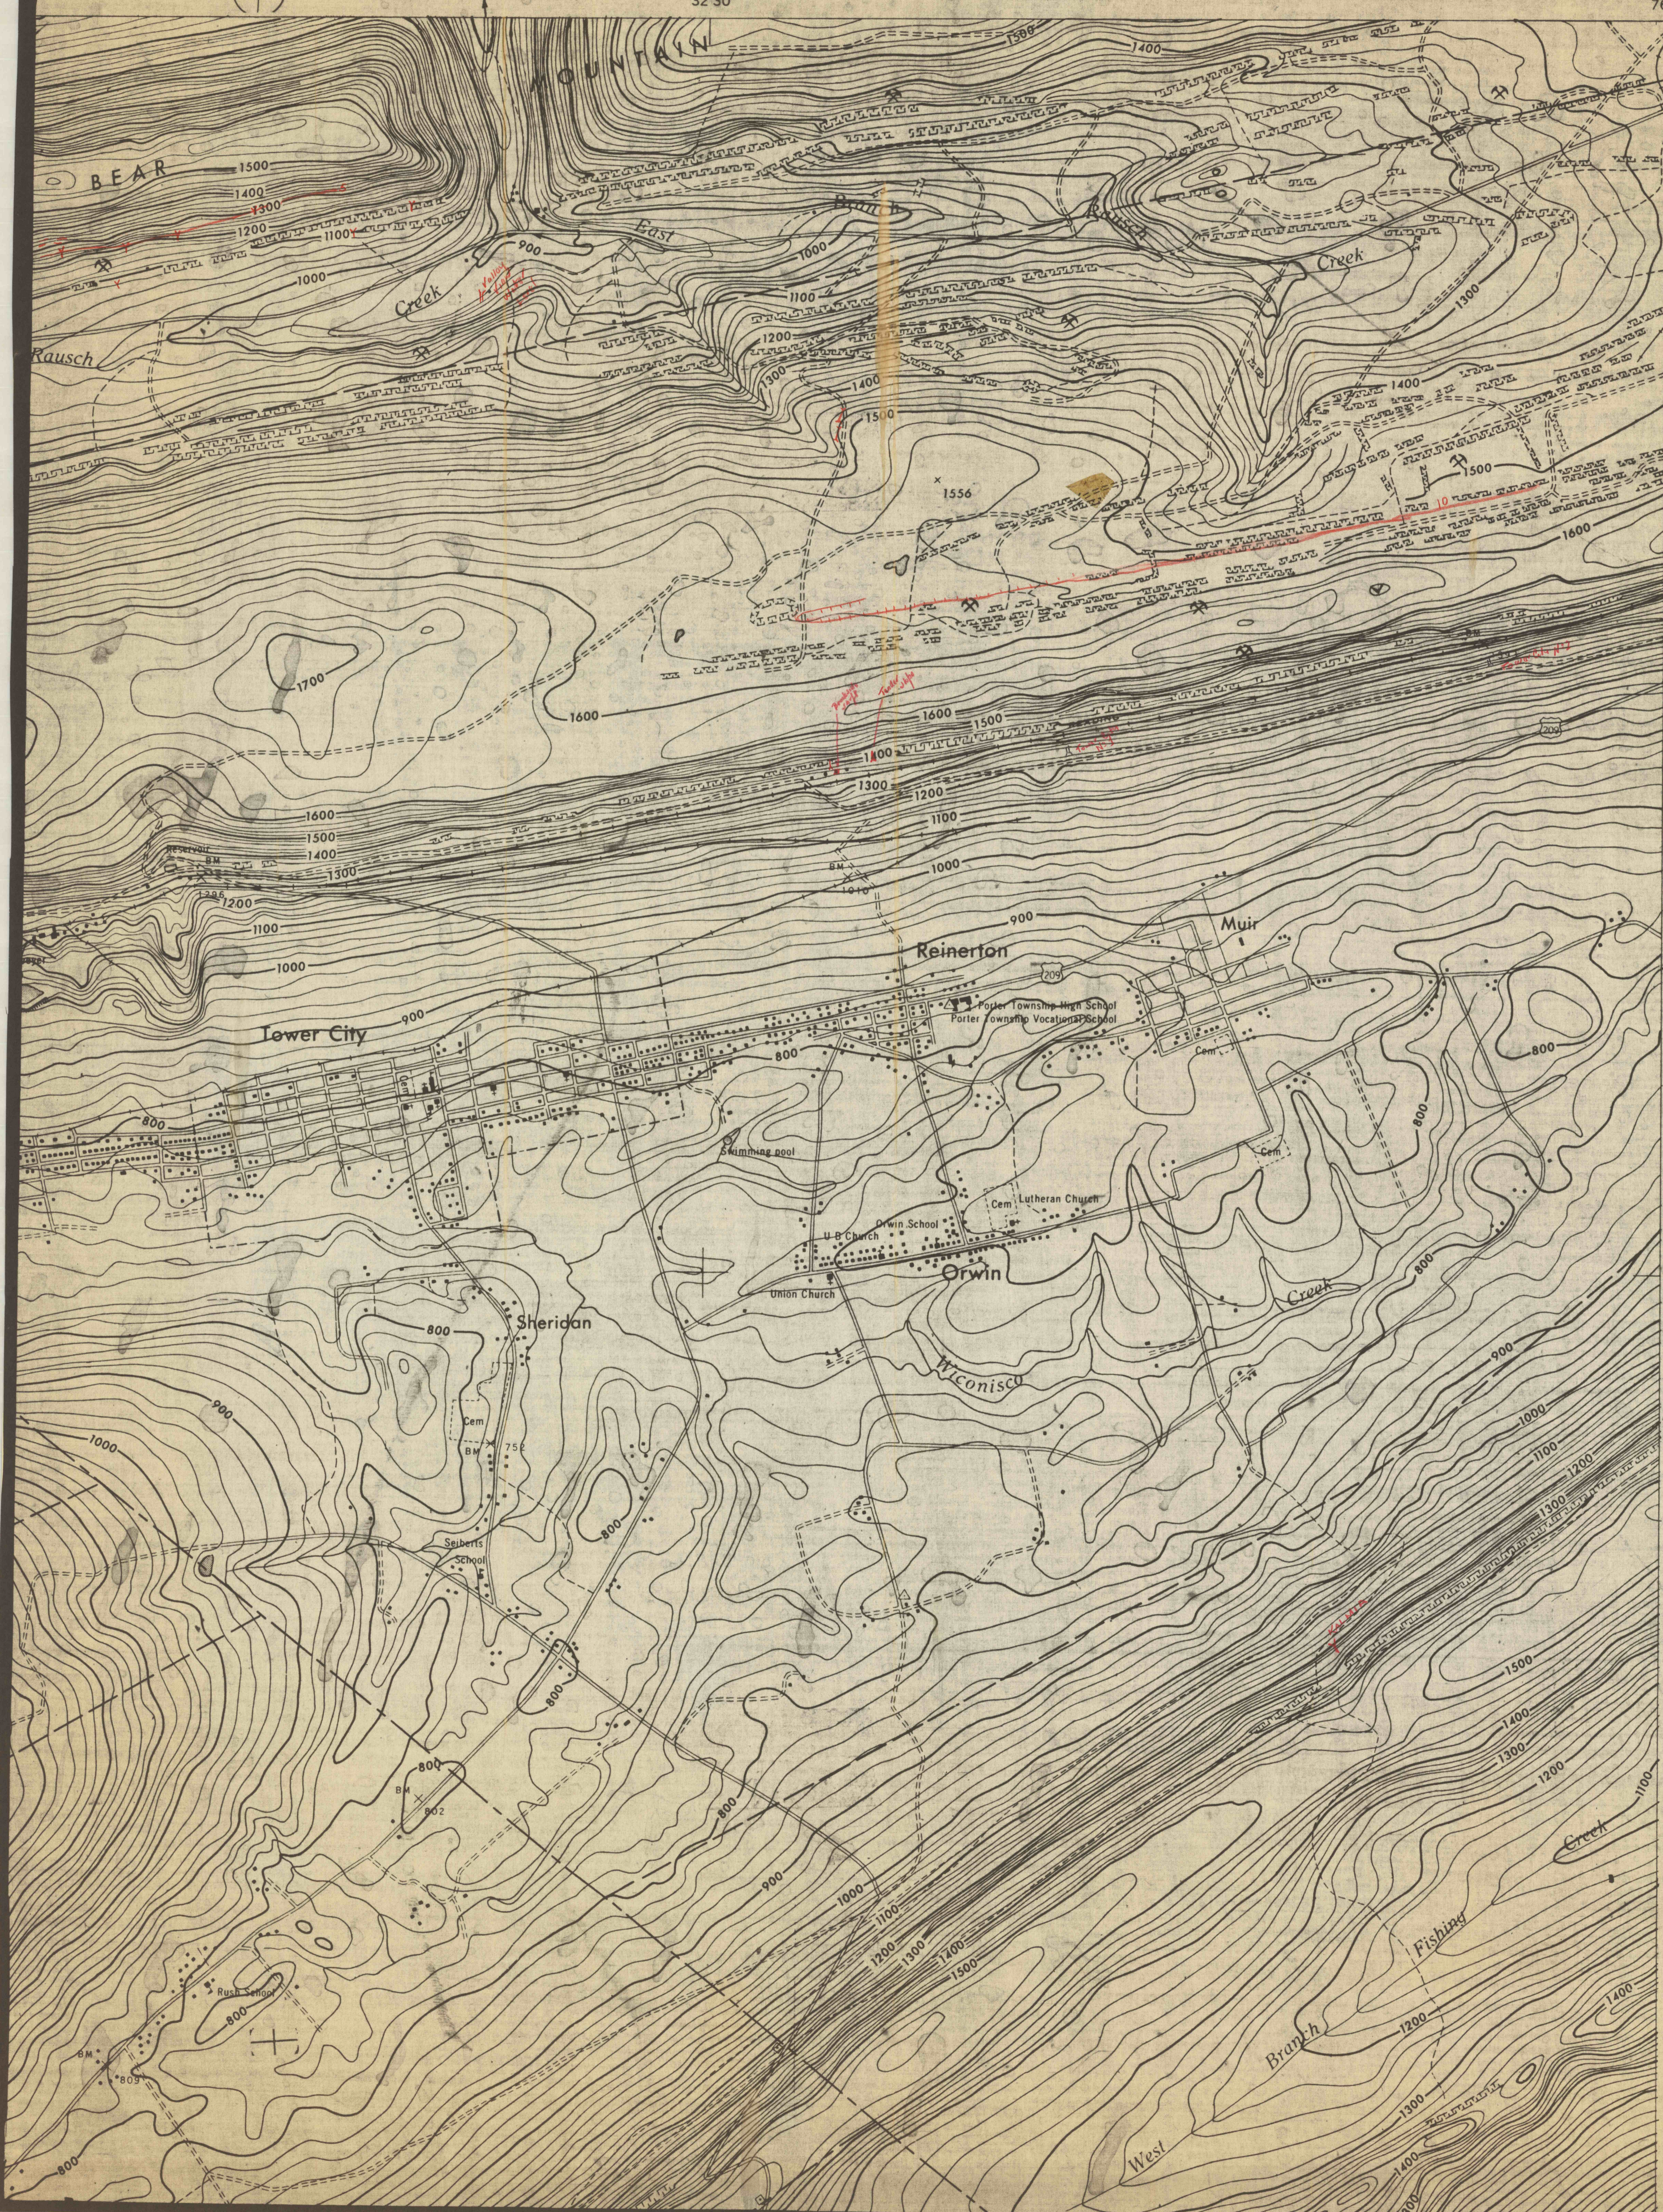

76°30'00"
40°37'30"

GOOD SHEPARD S. M.
GOWALDSON S. M.

35°00'

5851
M