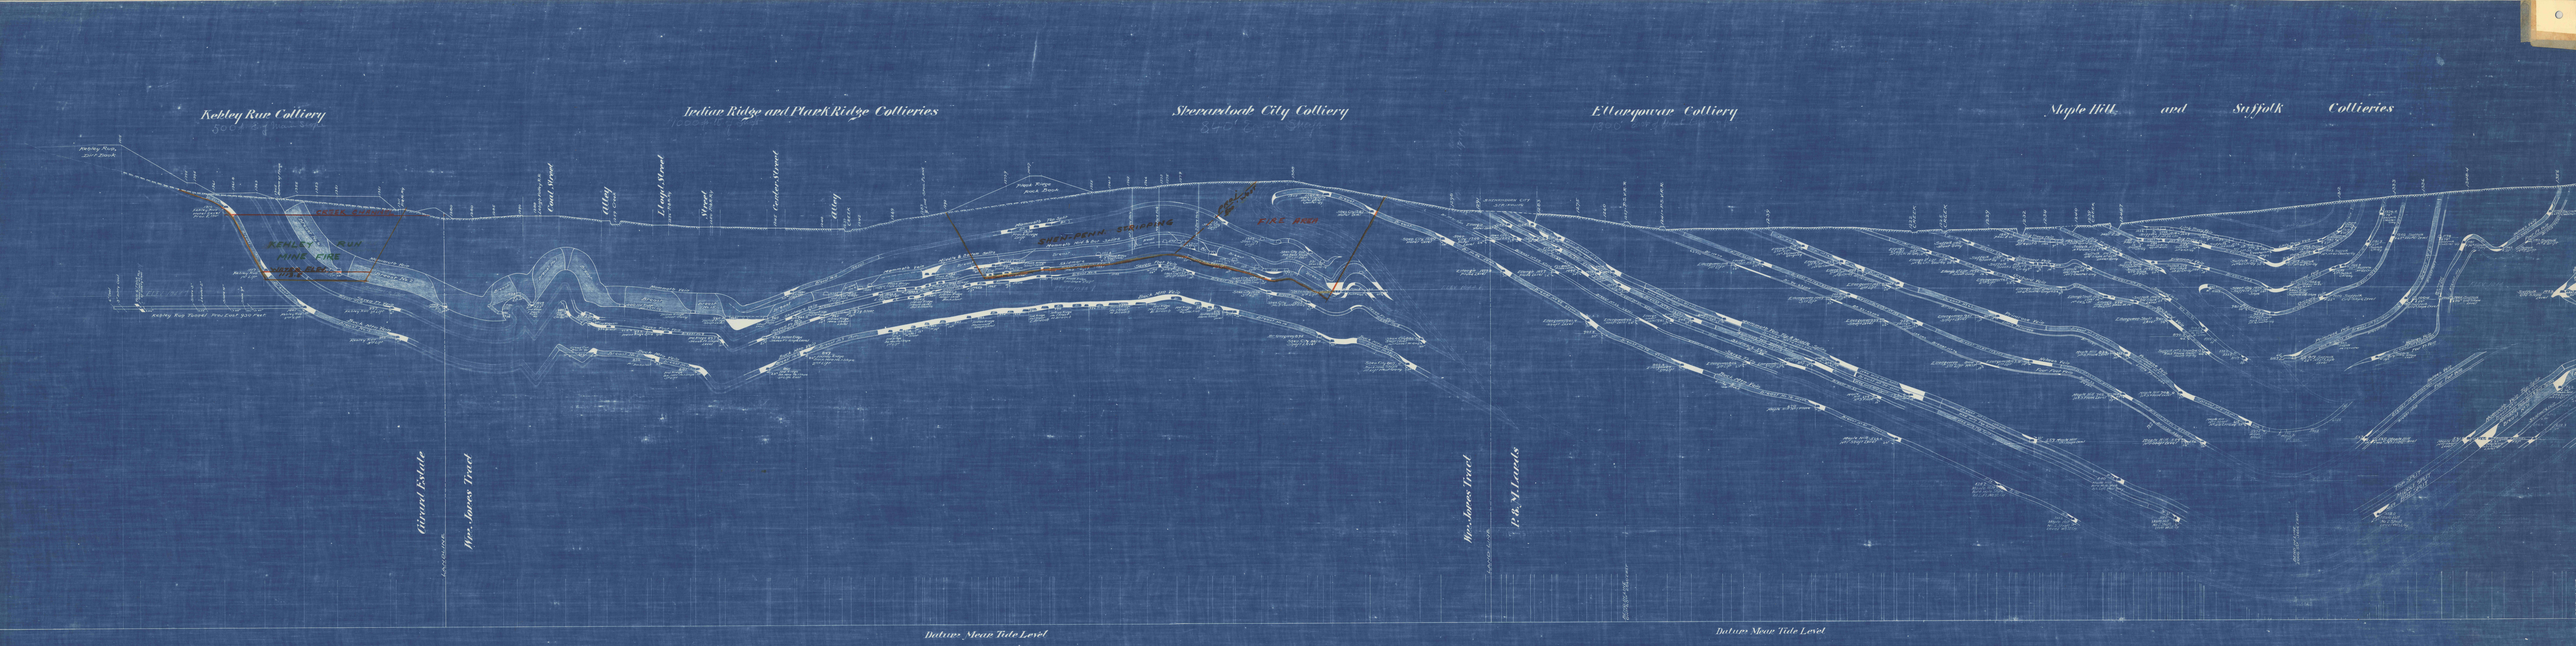

CROSS SECTION BY LINE THROUGH SHENANDOAH, MAPLE HILL AND MAHANOY BASINS

SCALE 100' PER INCH

Ashland, Pa., February 21 1908

T.B. Van Barren, Div. Engr.

Posted March 3 1905

1115

500 ft East of Kehley Run Hoisting Slope
1000 ft West of Indian Ridge Shaft
840 ft East of Shenandoah City Shaft
4200 ft West of Maple Hill Shaft
1000 ft East of Boston Run (Main) Hoisting Slope