

BASE LINE 15+00 N




BASE LINE 10+00 N

BASE LINE 8+00 N

BASE LINE

KEHELEY RUN MINE FIRE
PROJECT No. S.L. 809
BASE LINE 20 STATION TRANSVERSE
NOVEMBER - 1970
VOL. 2 - Pgs. 25 TO 46 INC.

SCALE 1"=100'

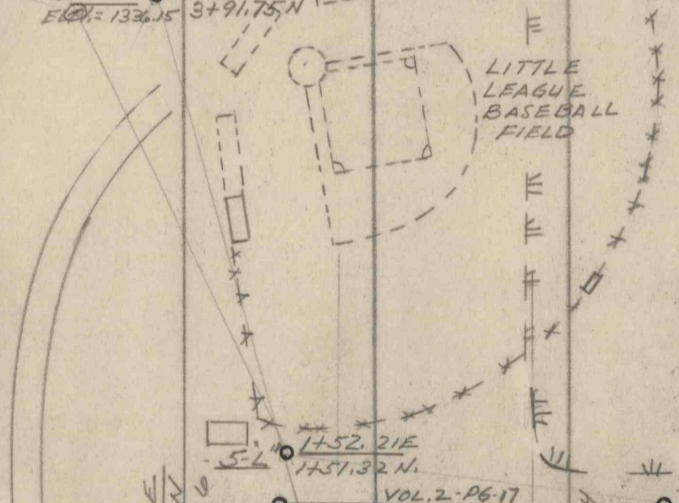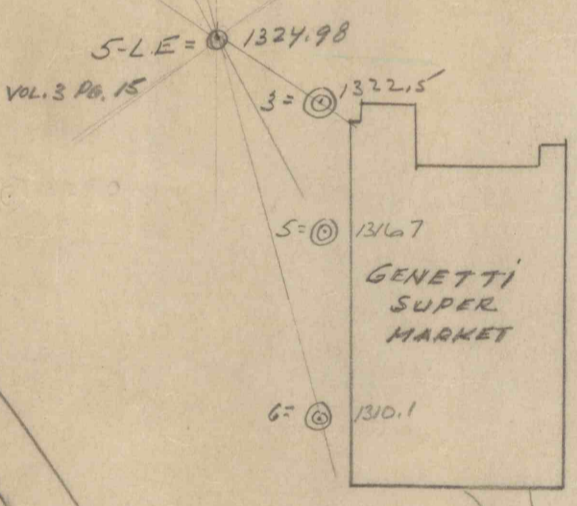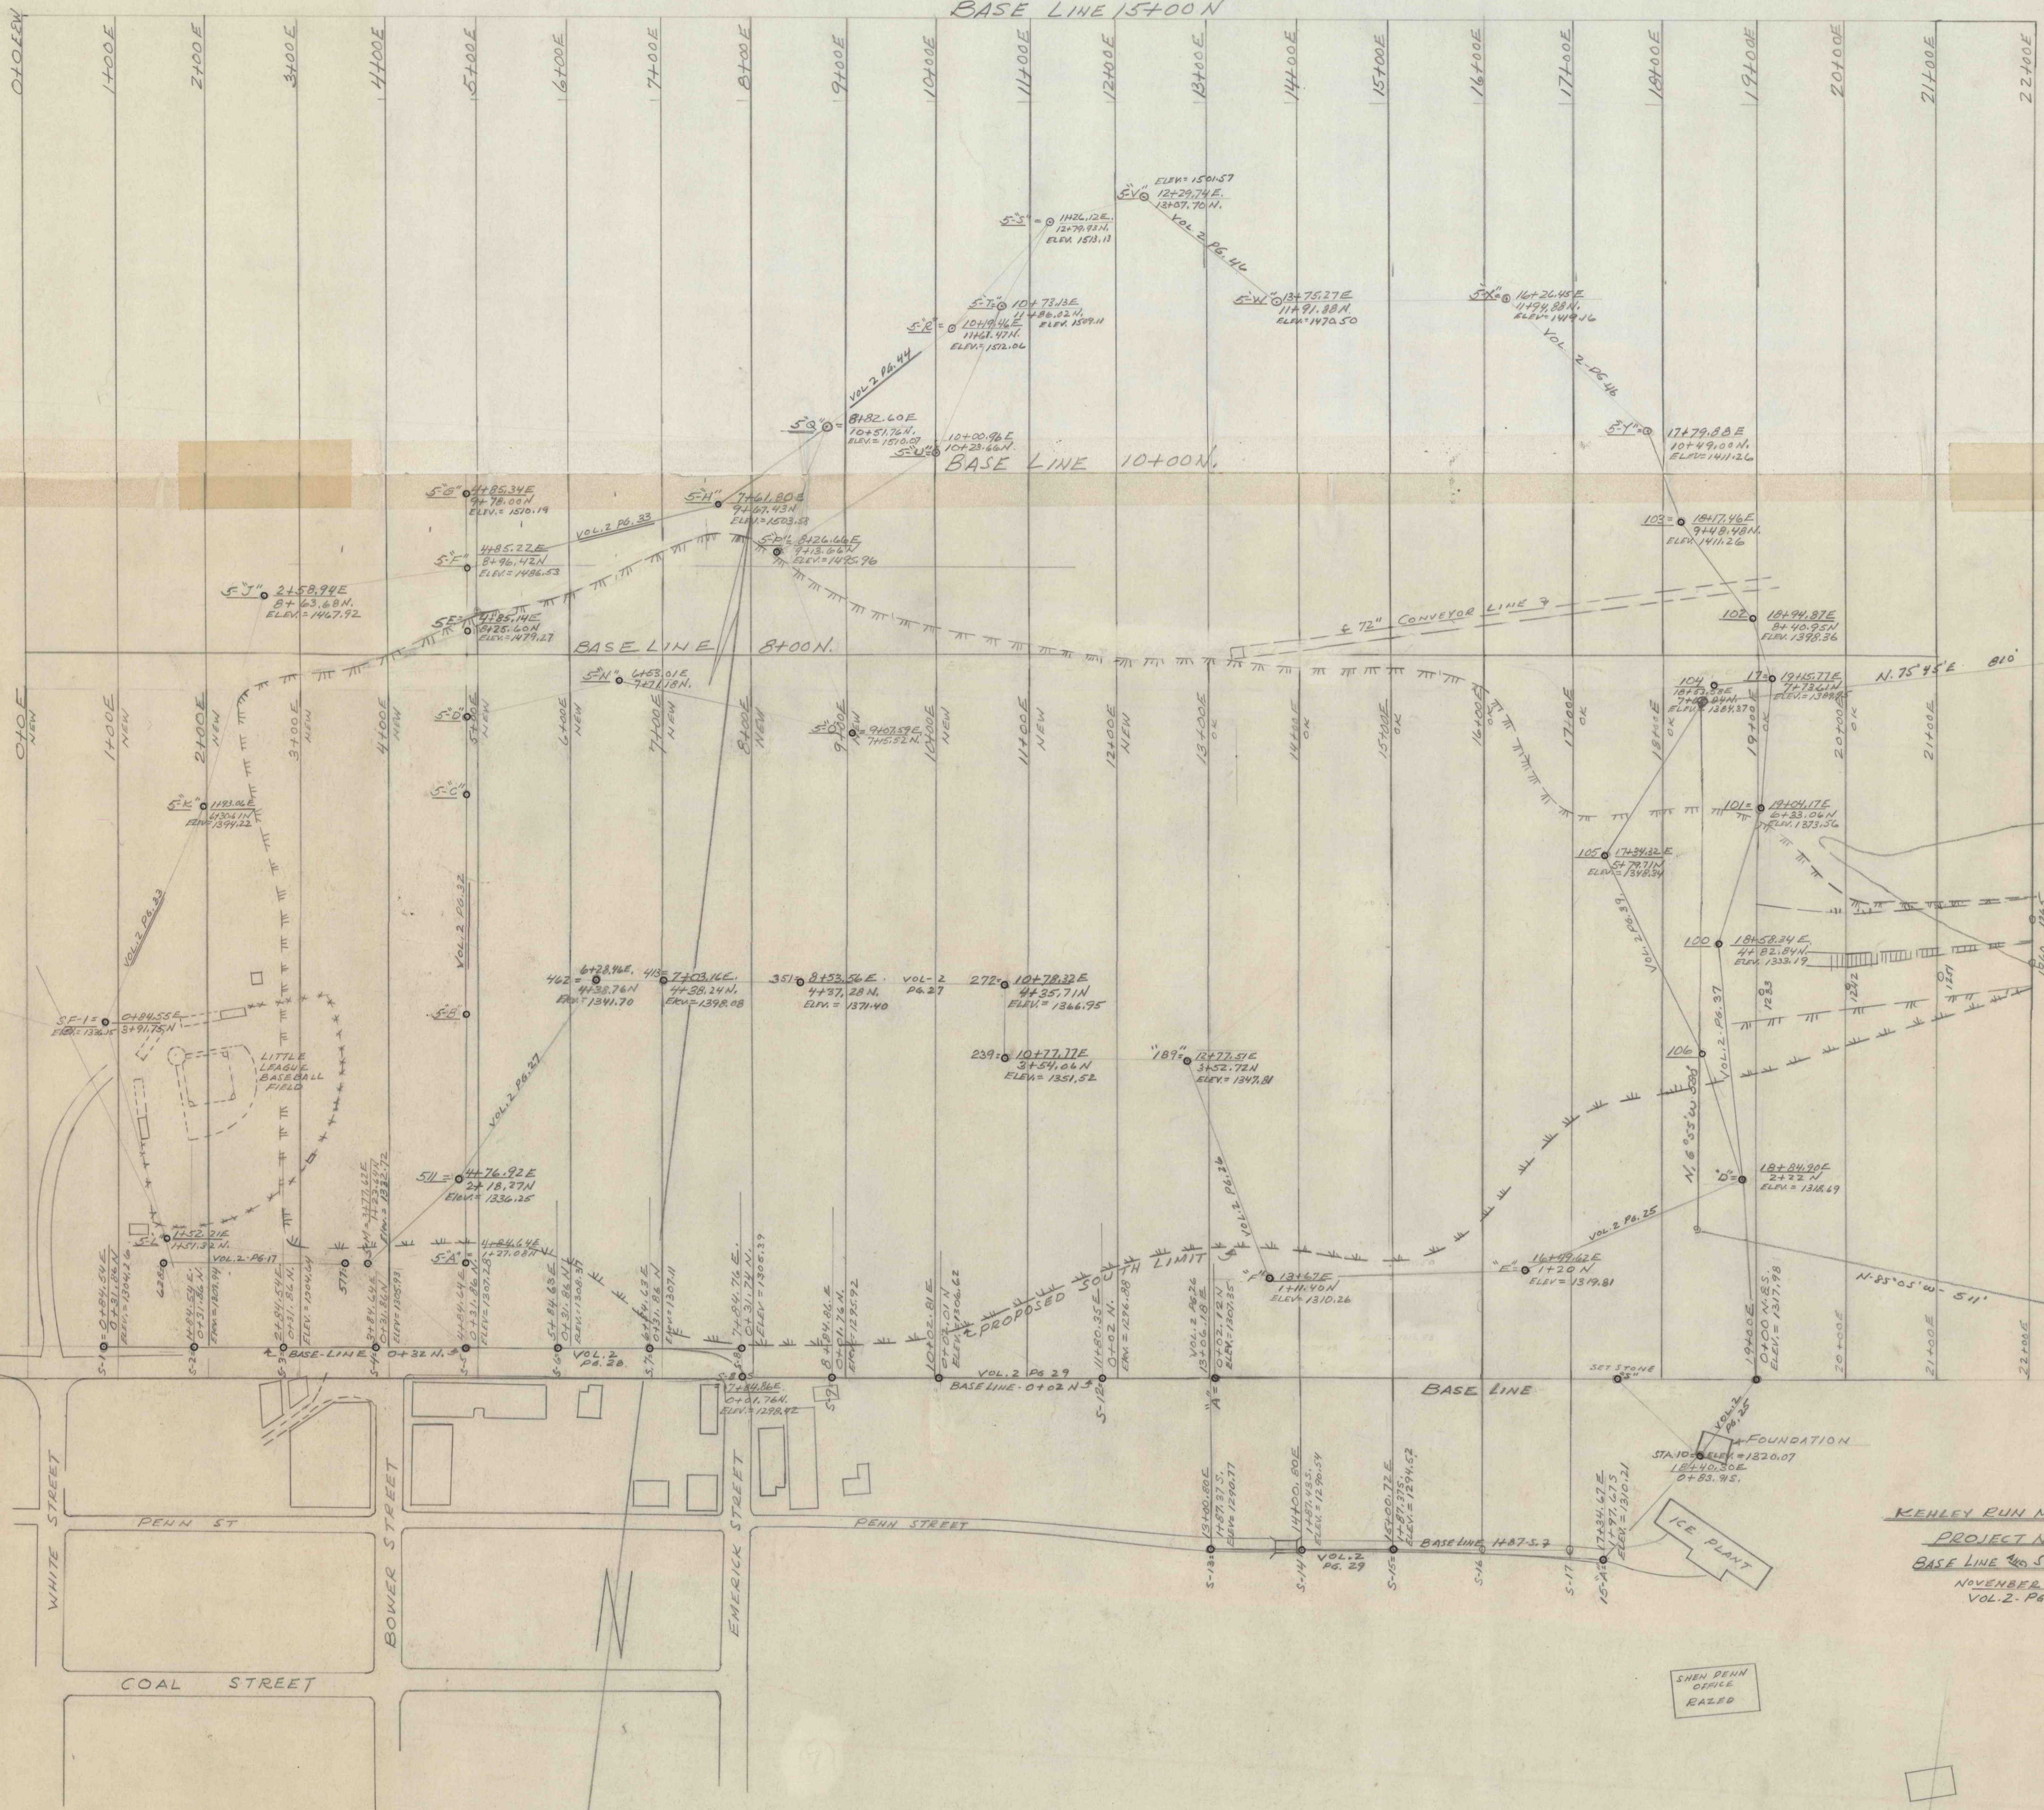

SHEN PENN OFFICE RAZED

DEER INDIAN RIDGE
PROPOSED PUMP SITE

BASE LINE 20 STATION TRANSVERSE
KEHELEY RUN MINE FIRE PROJECT
2/10/00