





SECTION 29+00E

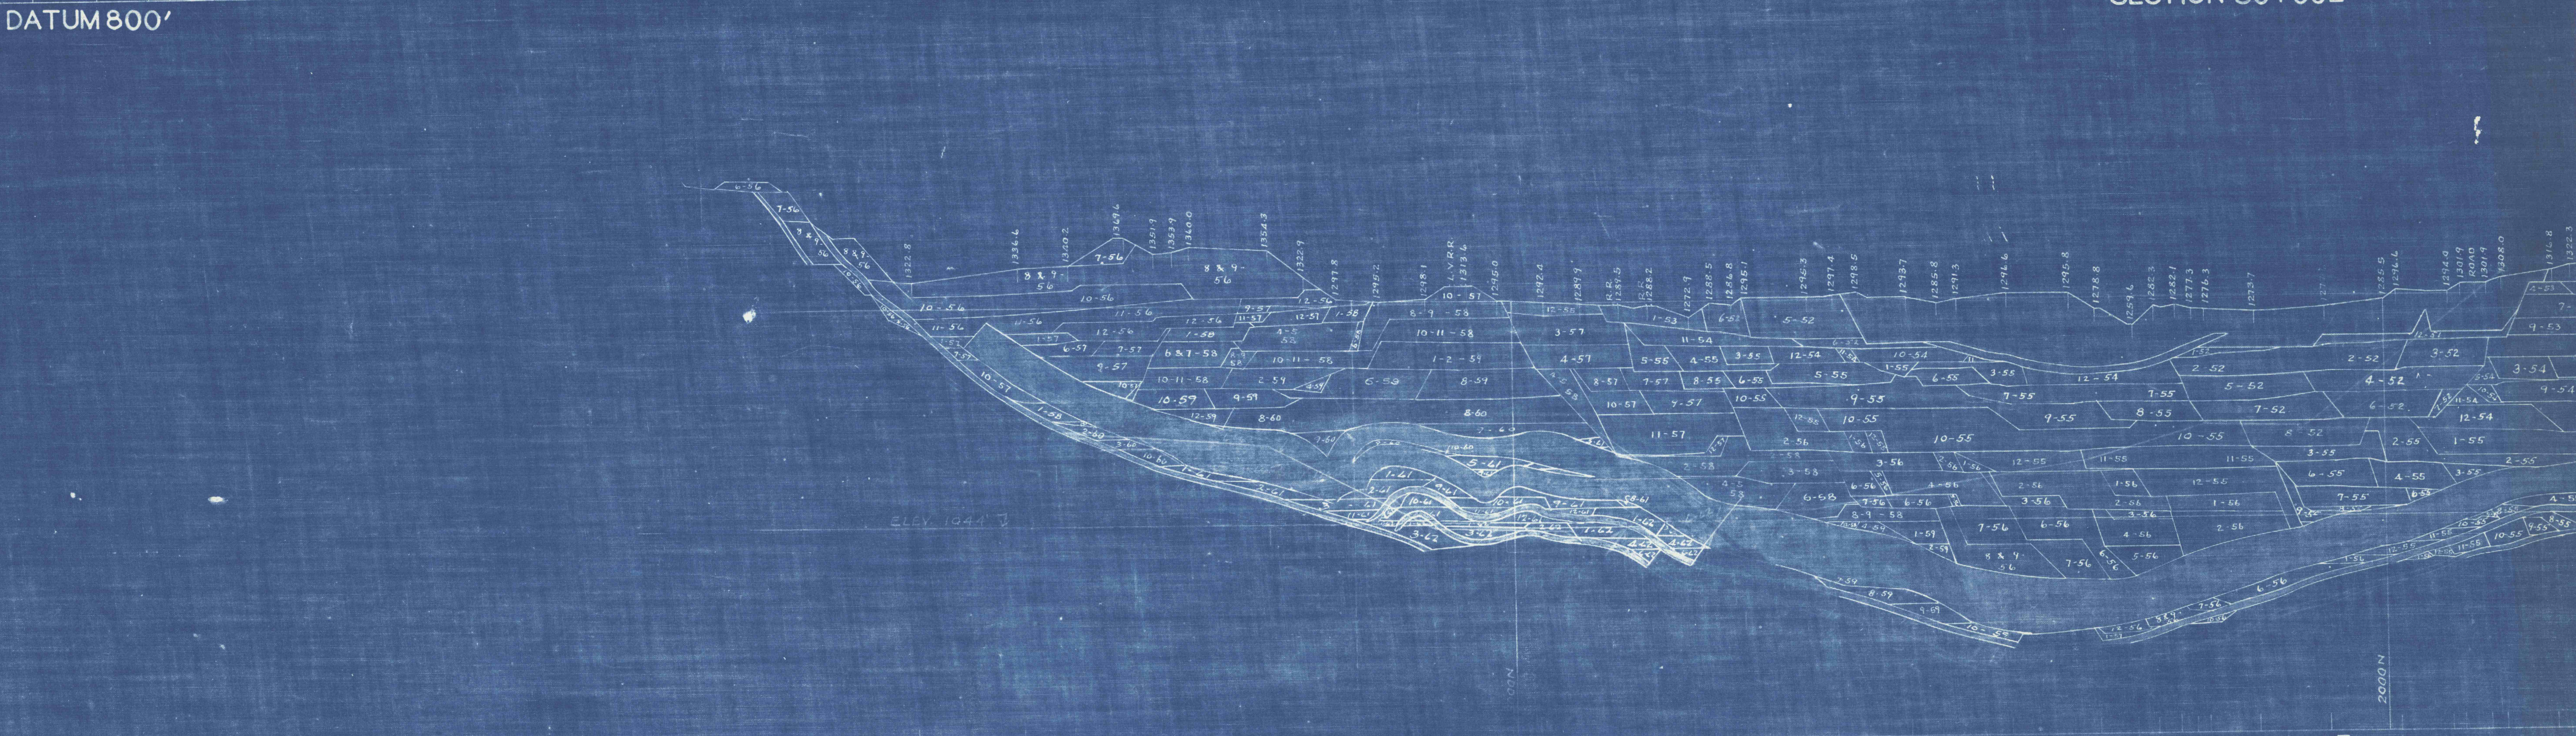

SECTION 30+00E



SECTION 31+00E

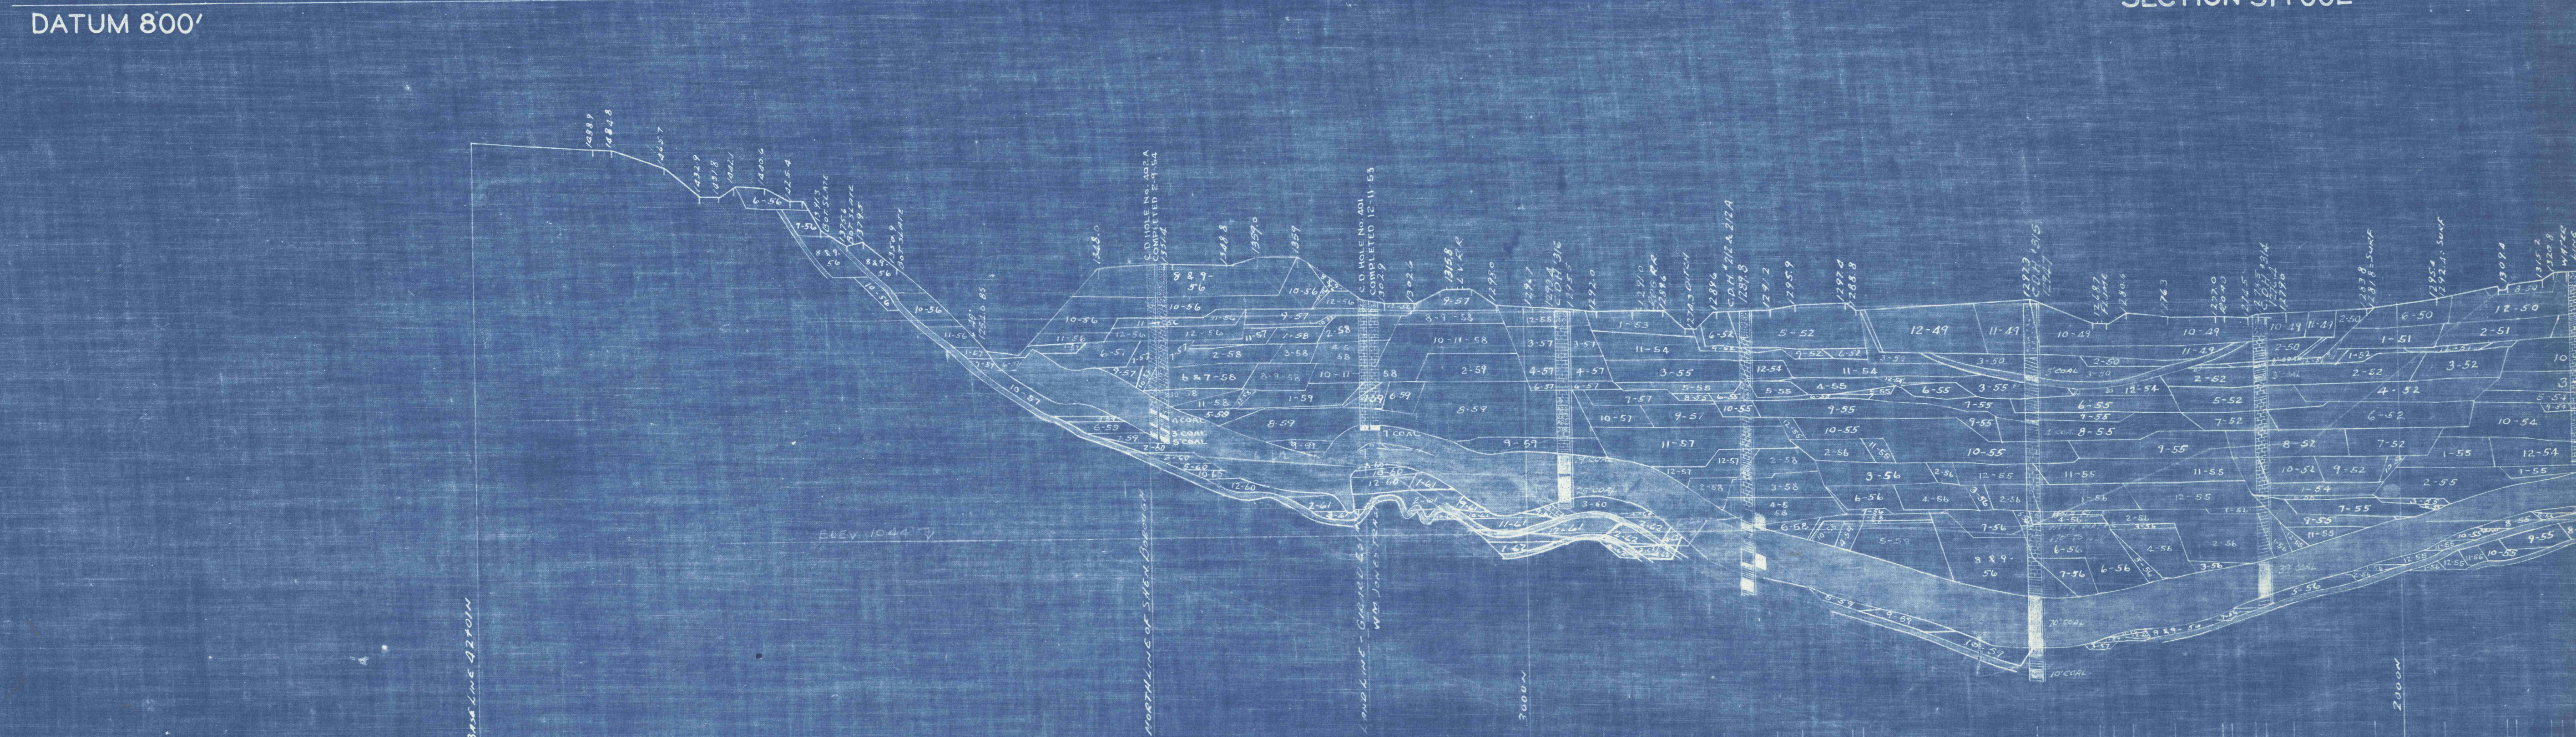

SECTION 32+00E