



DATUM 800'

SECTION 25+00E

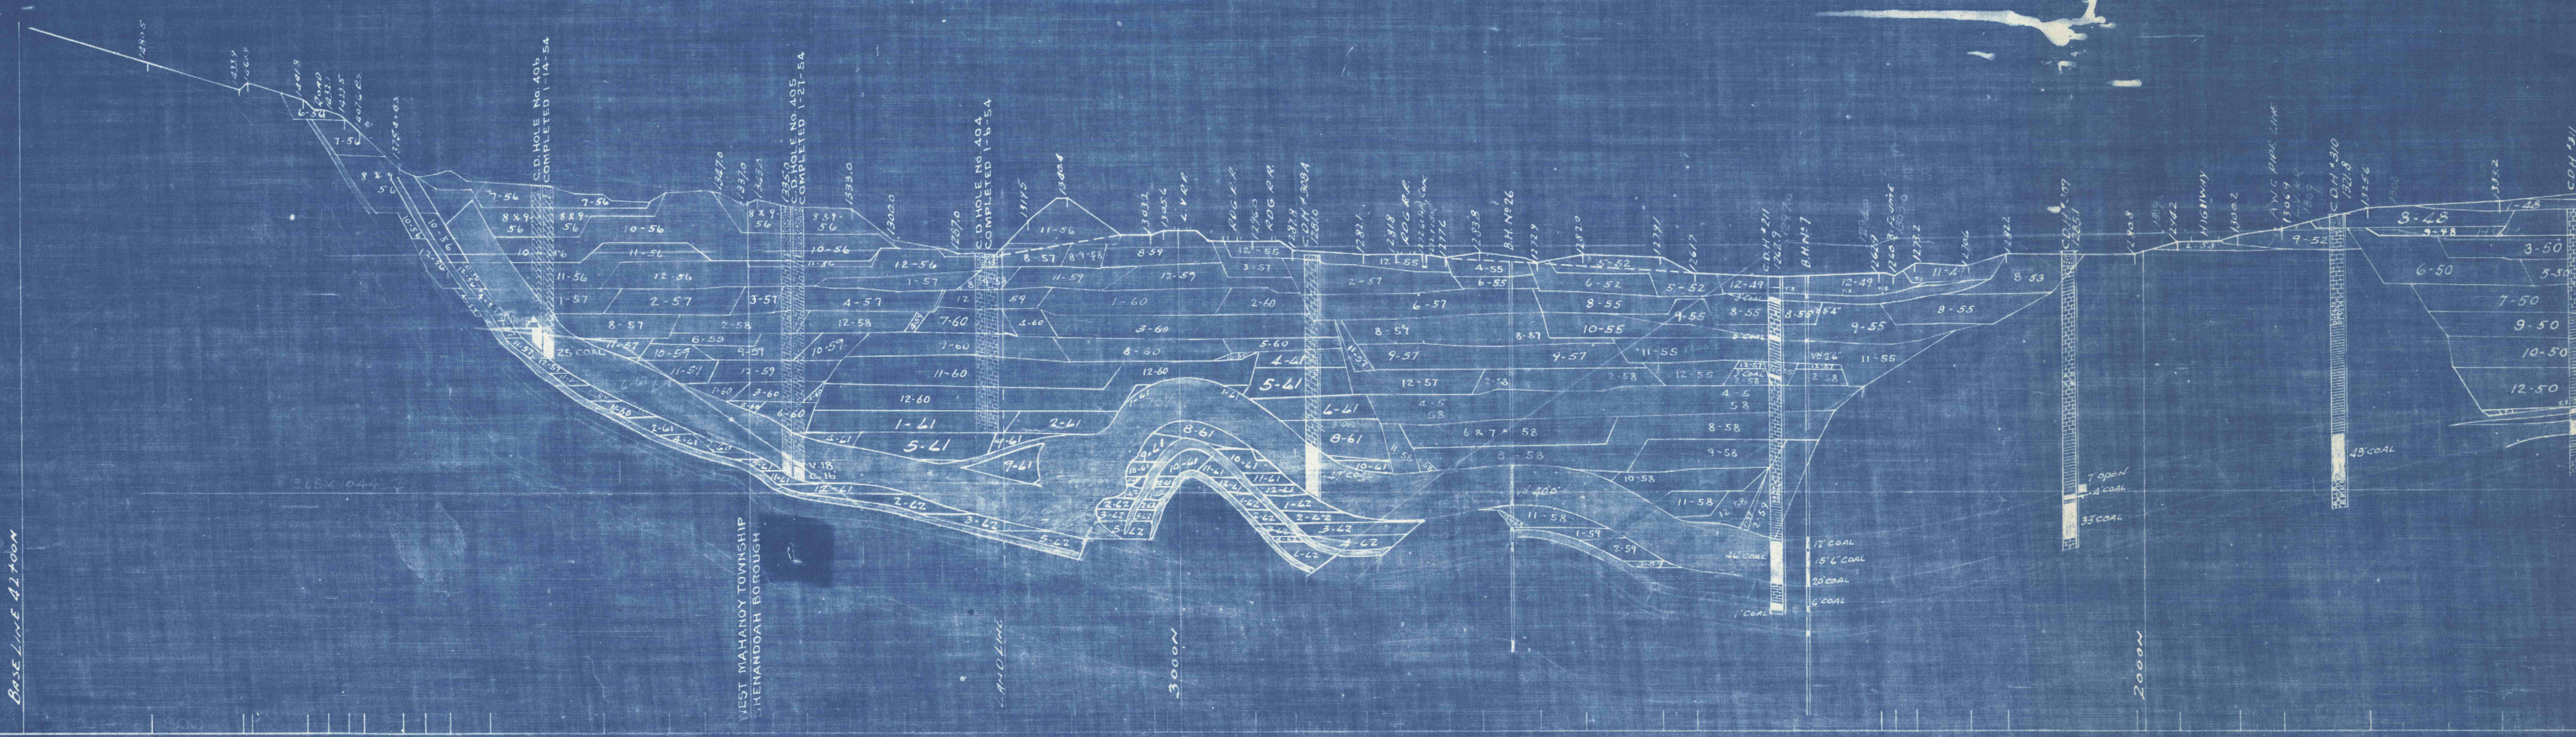


DATUM 800'

SECTION 26+00E

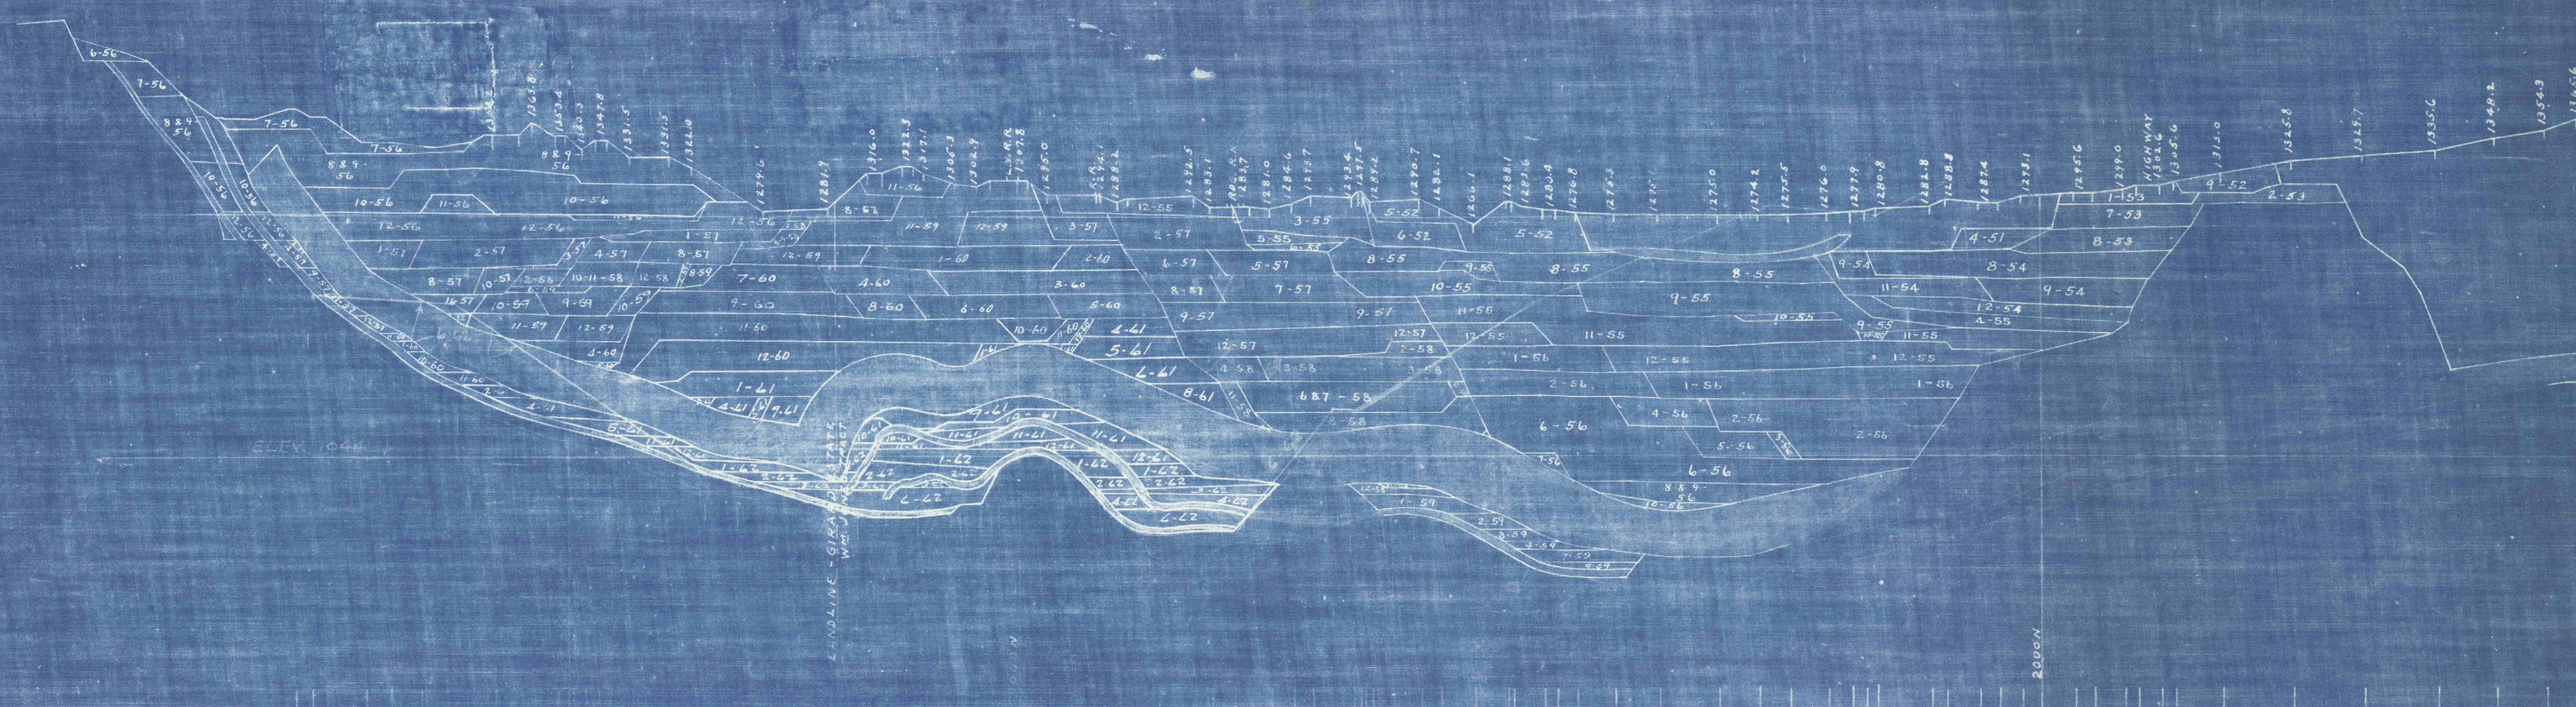

DATUM 800'

SECTION 27+00E

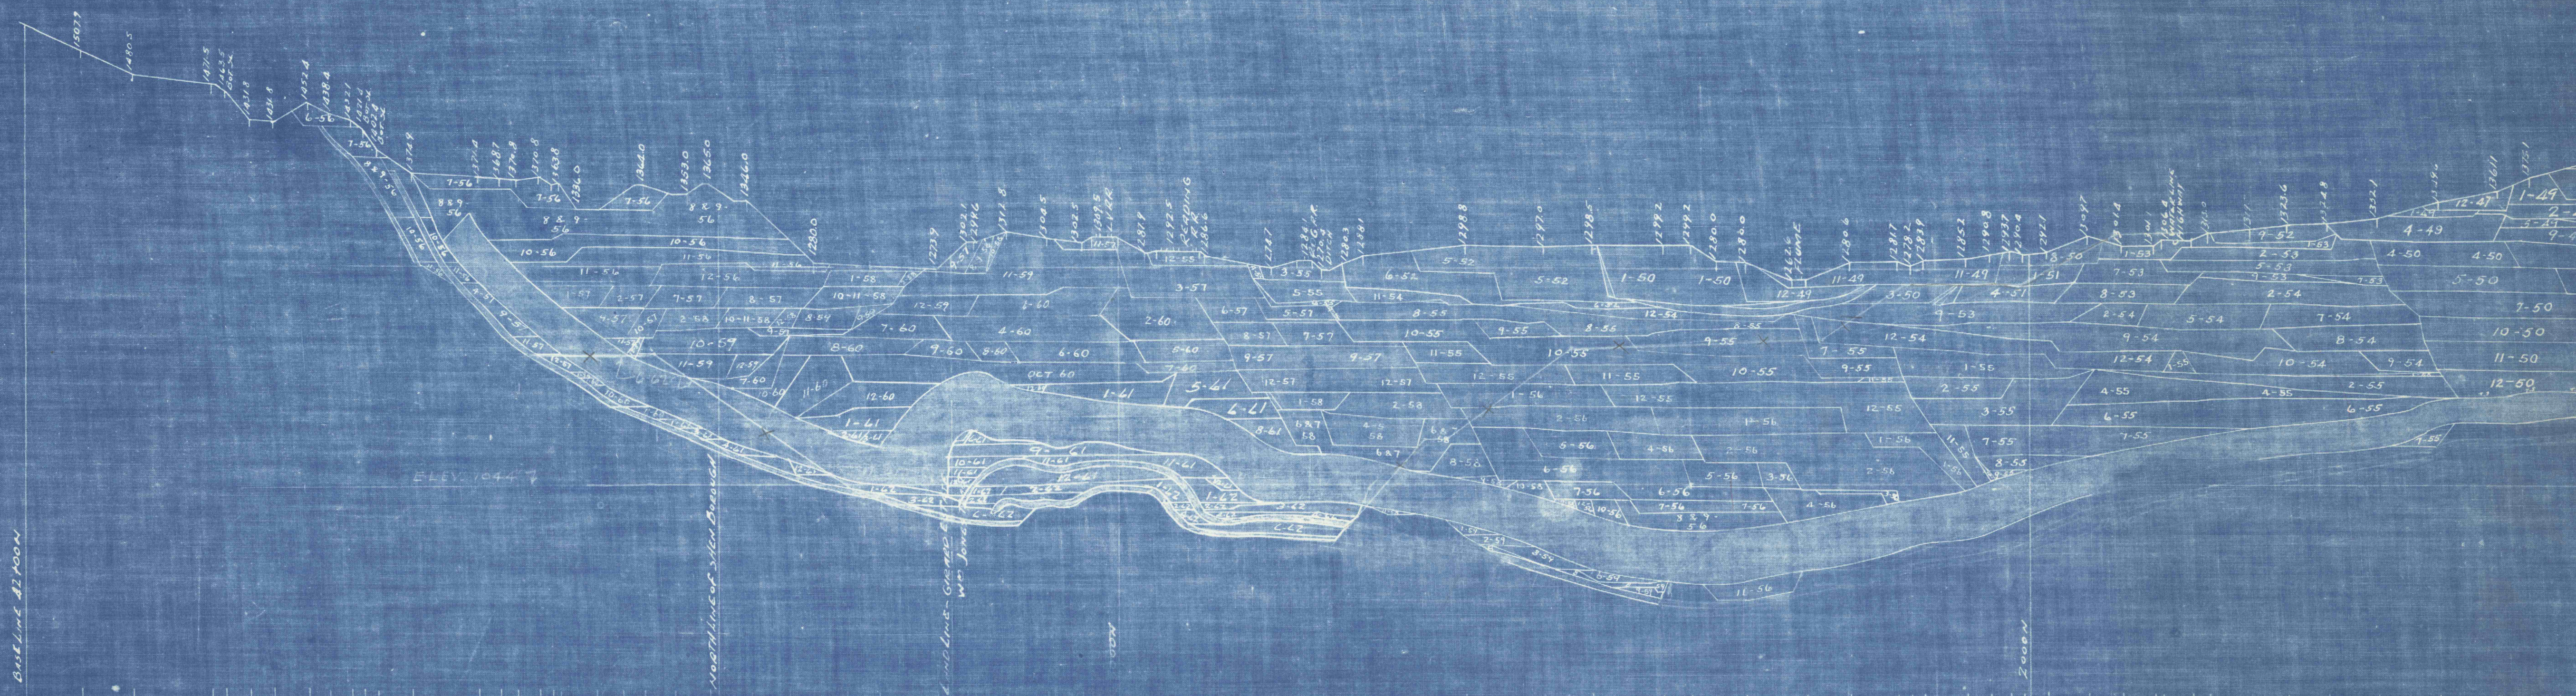

DATUM 800'

SECTION 28+00E