



DATUM 800'

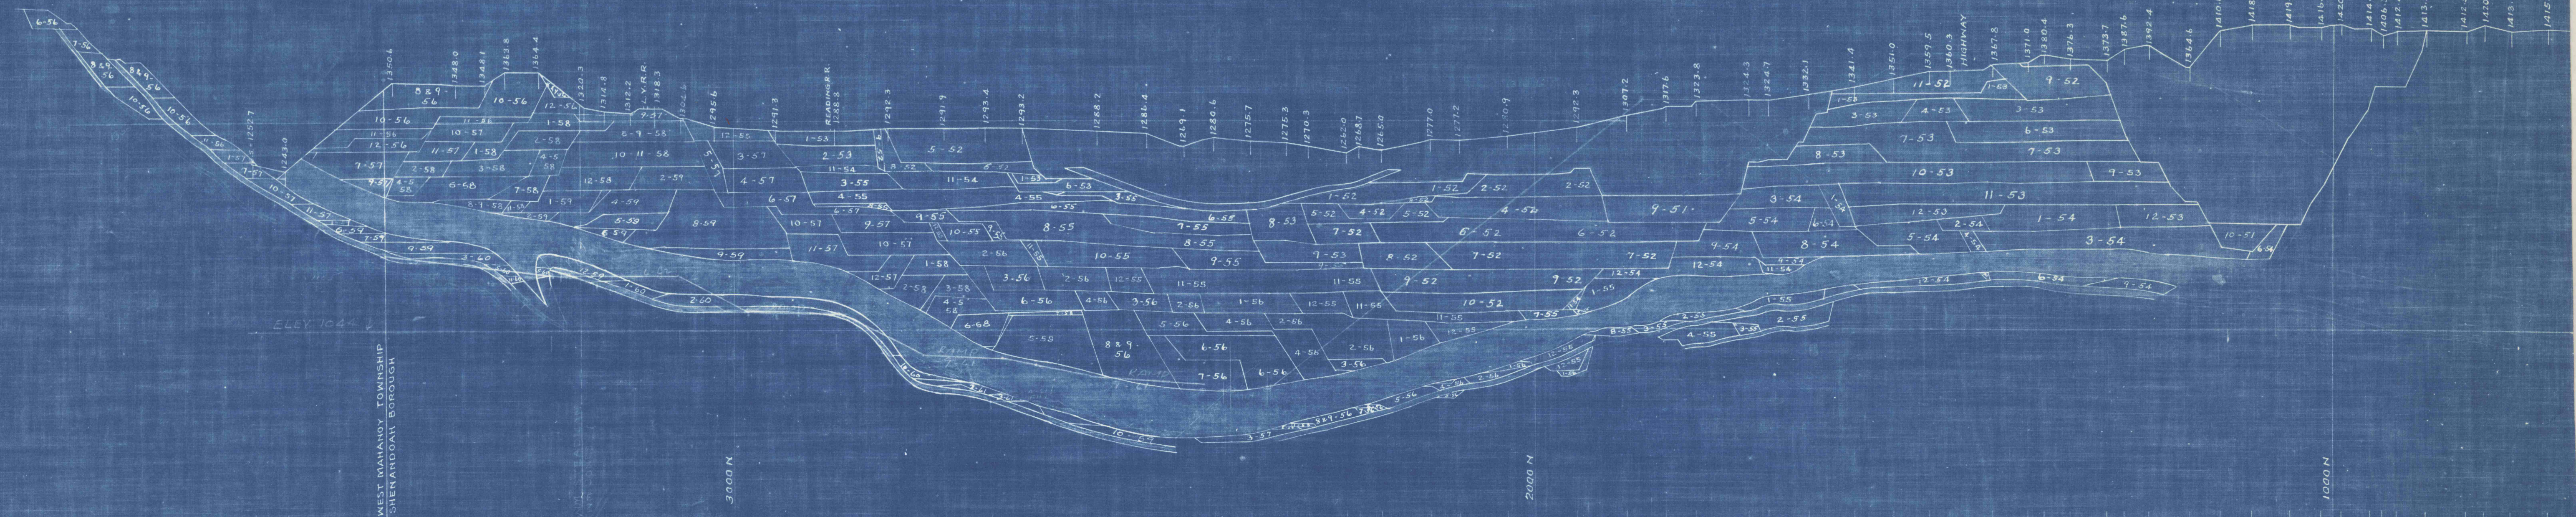

SECTION 33+00E

LOOKING EAST


DATUM 800'

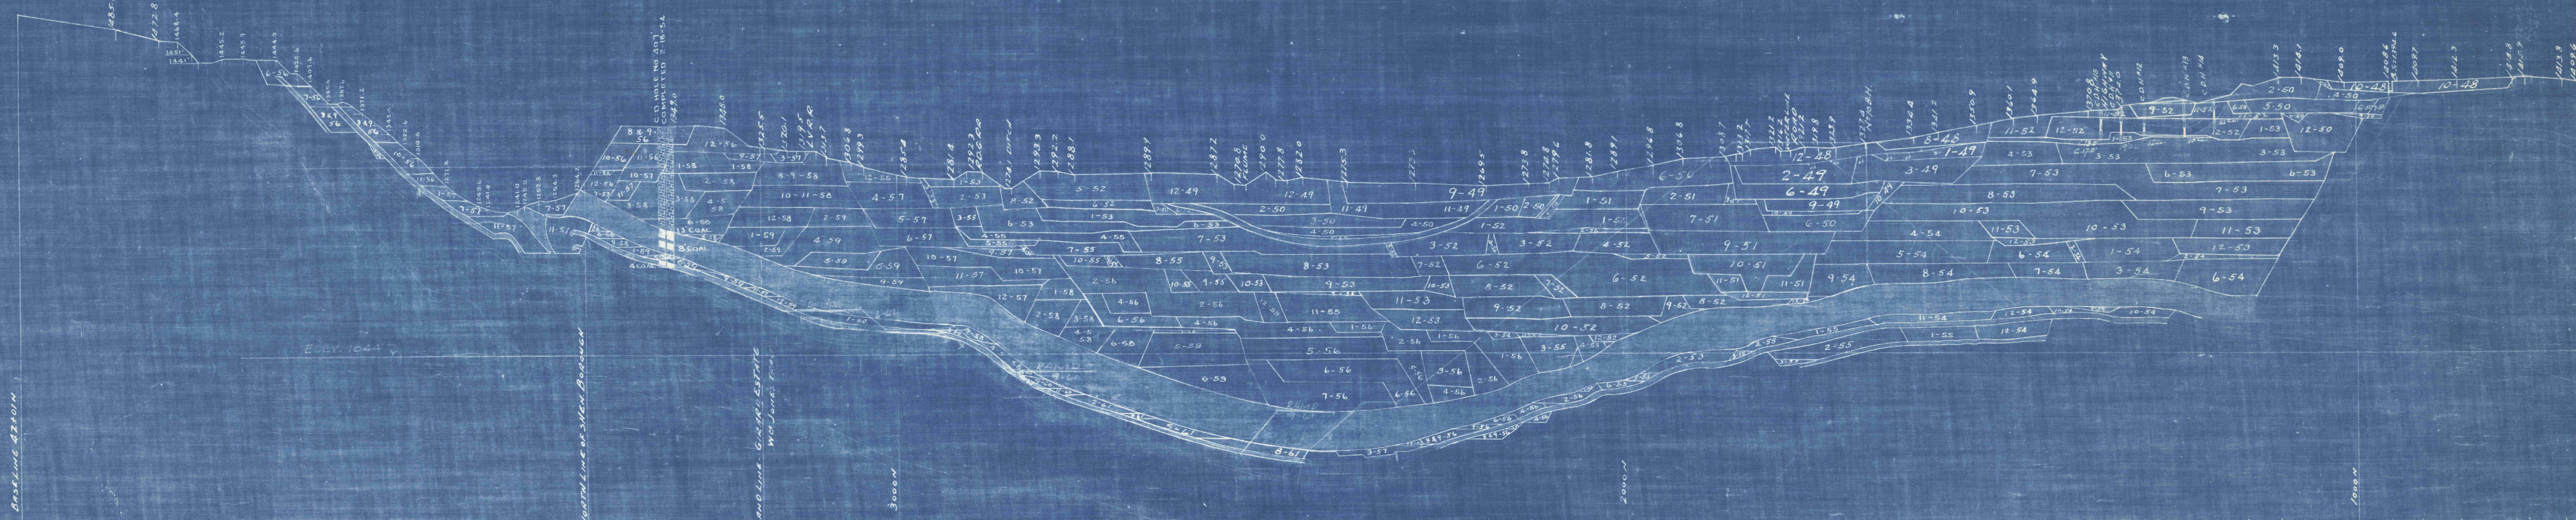

SECTION 34+00E

LOOKING EAST


DATUM 800'

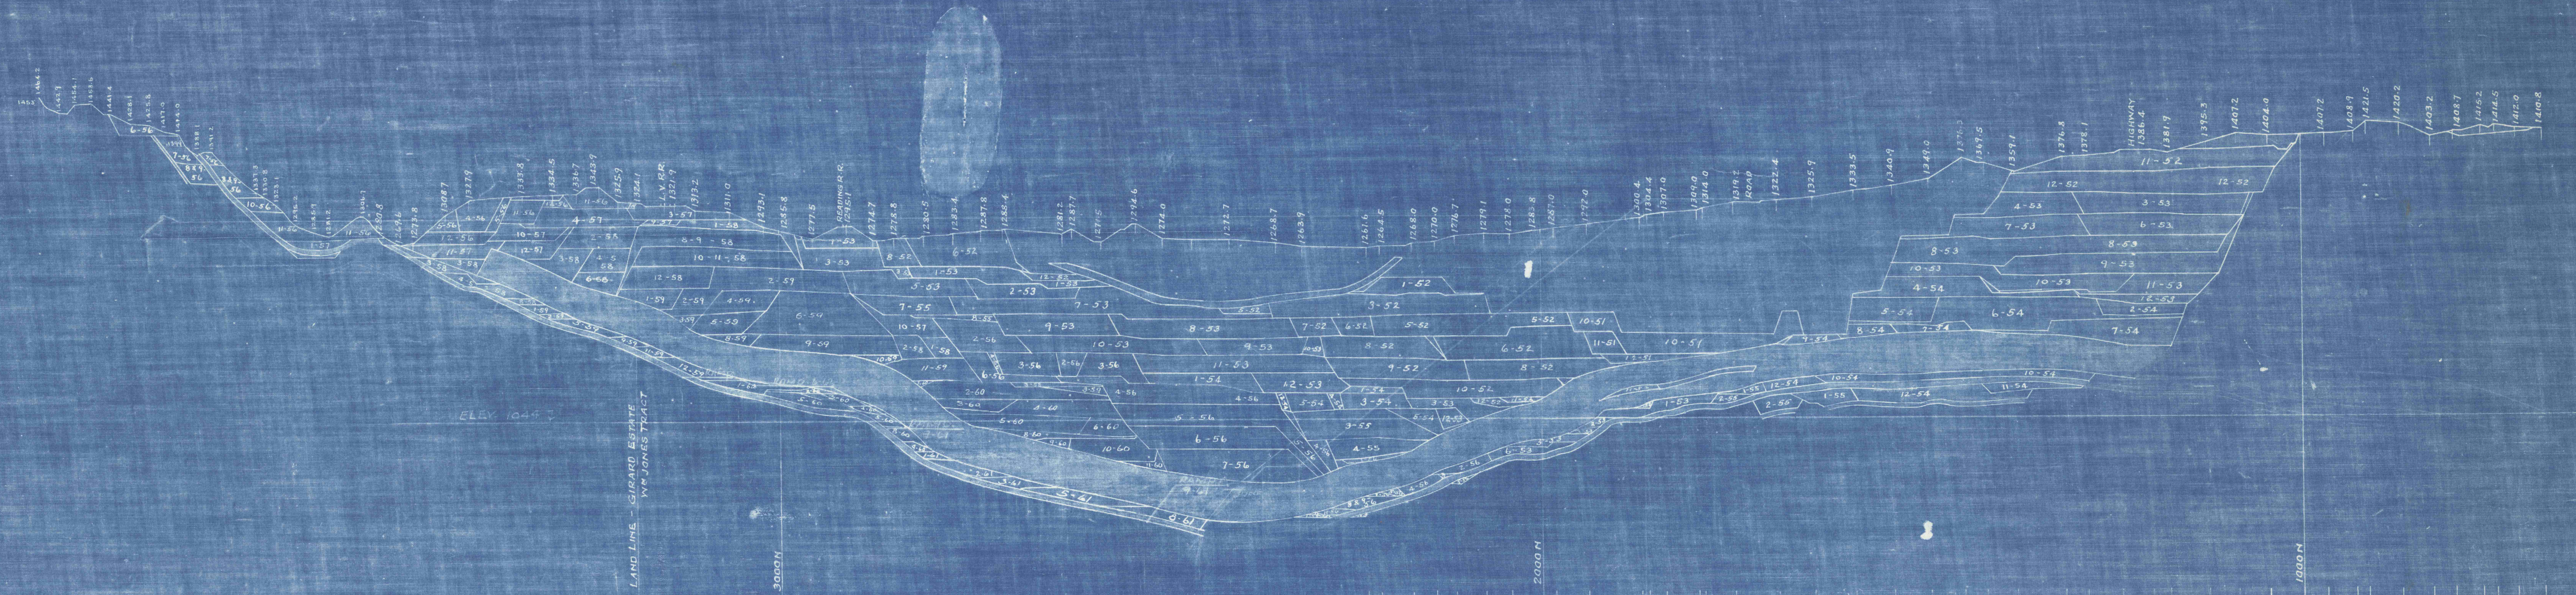

SECTION 35+00E

LOOKING EAST

DATUM 800'

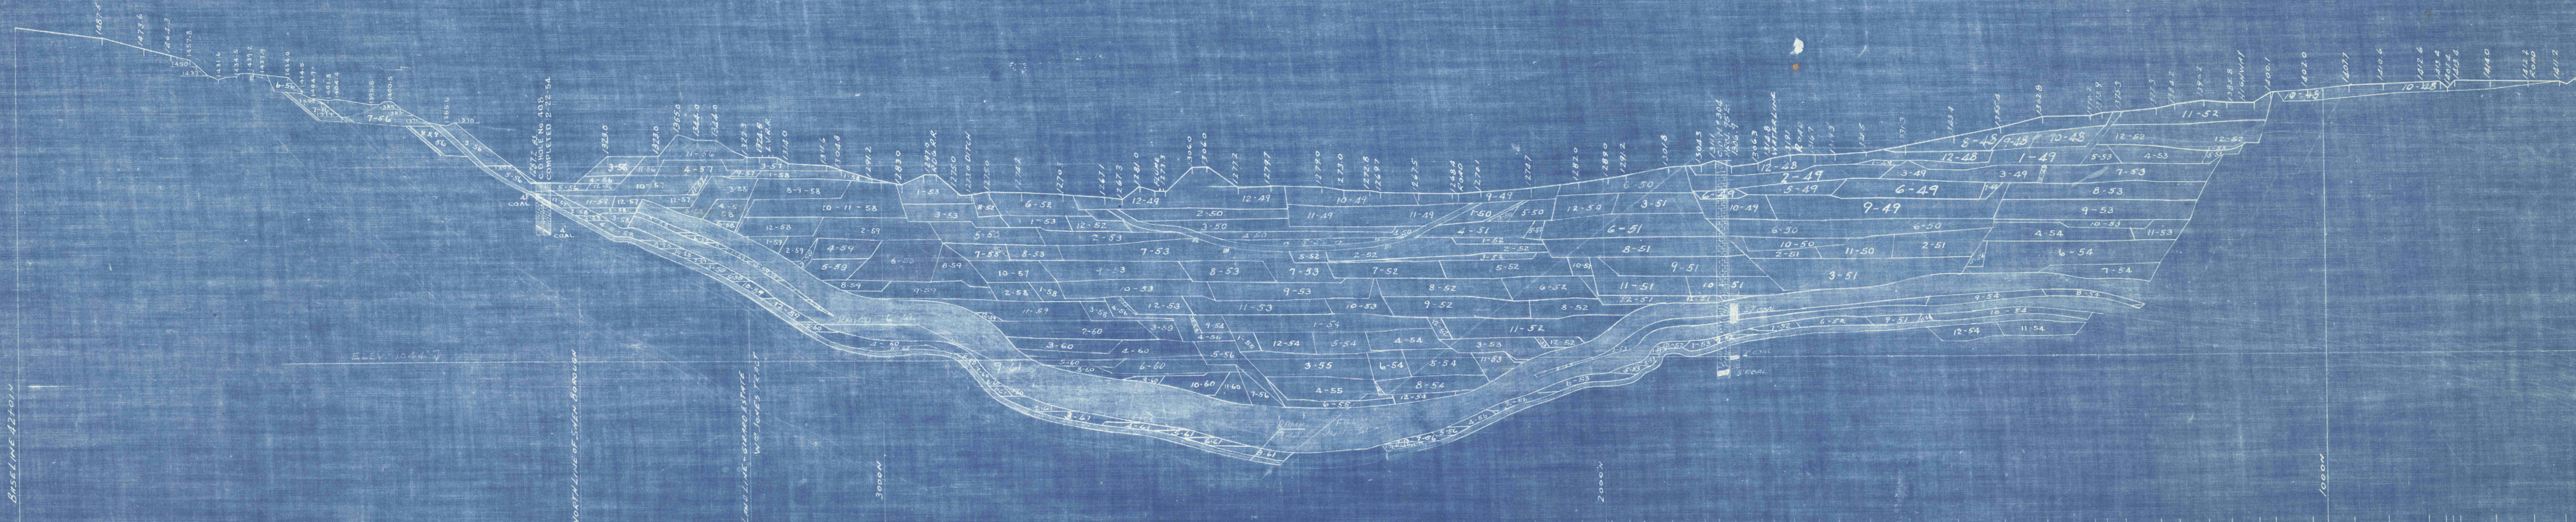

SECTION 36+00E

LOOKING EAST