


ATUM 800'

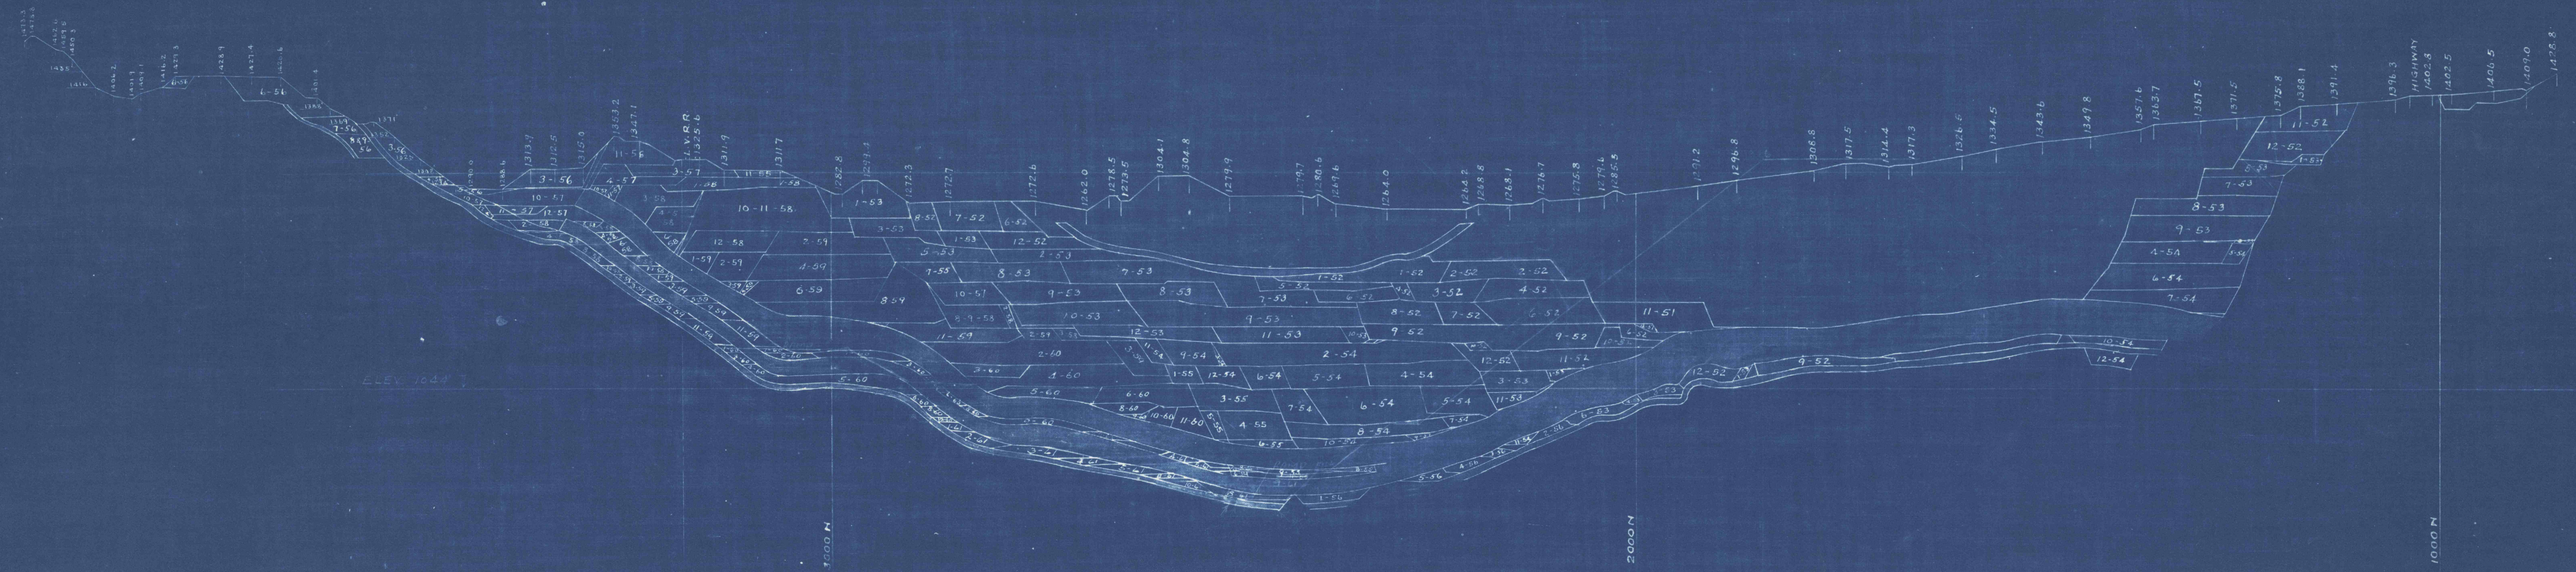

SECTION 37+00E

LOOKING EAST


ATUM 800'



SECTION 38+00E

LOOKING EAST

ATUM 800'

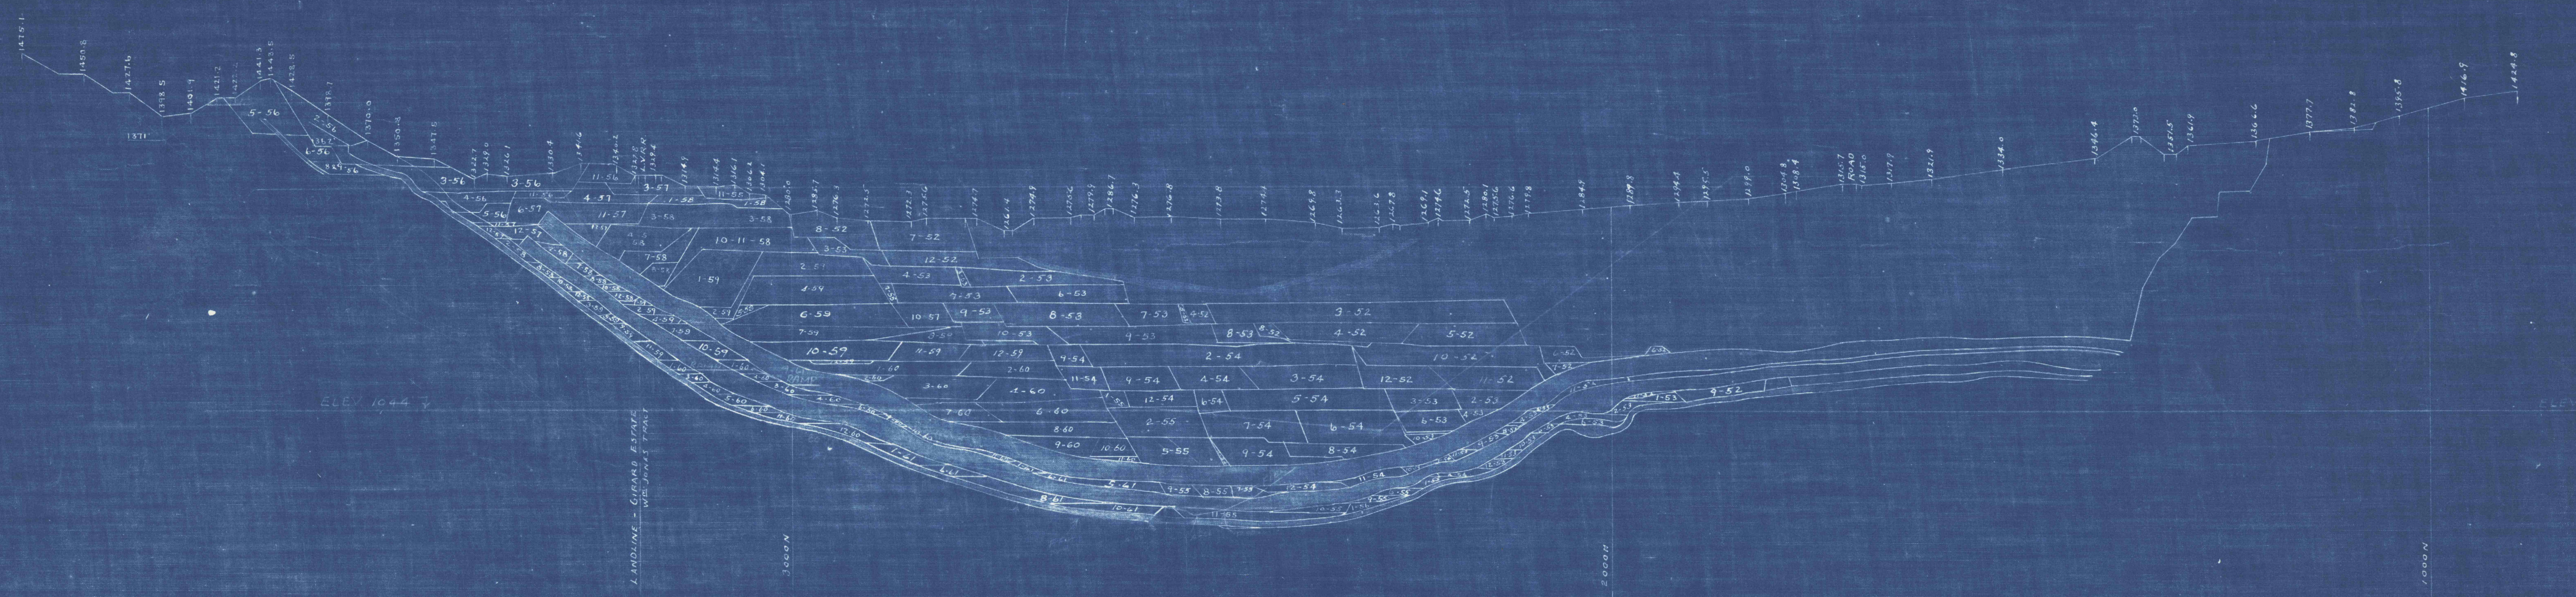

SECTION 39+00E

LOOKING EAST

ATUM 800'



SECTION 40+00E

LOOKING EAST