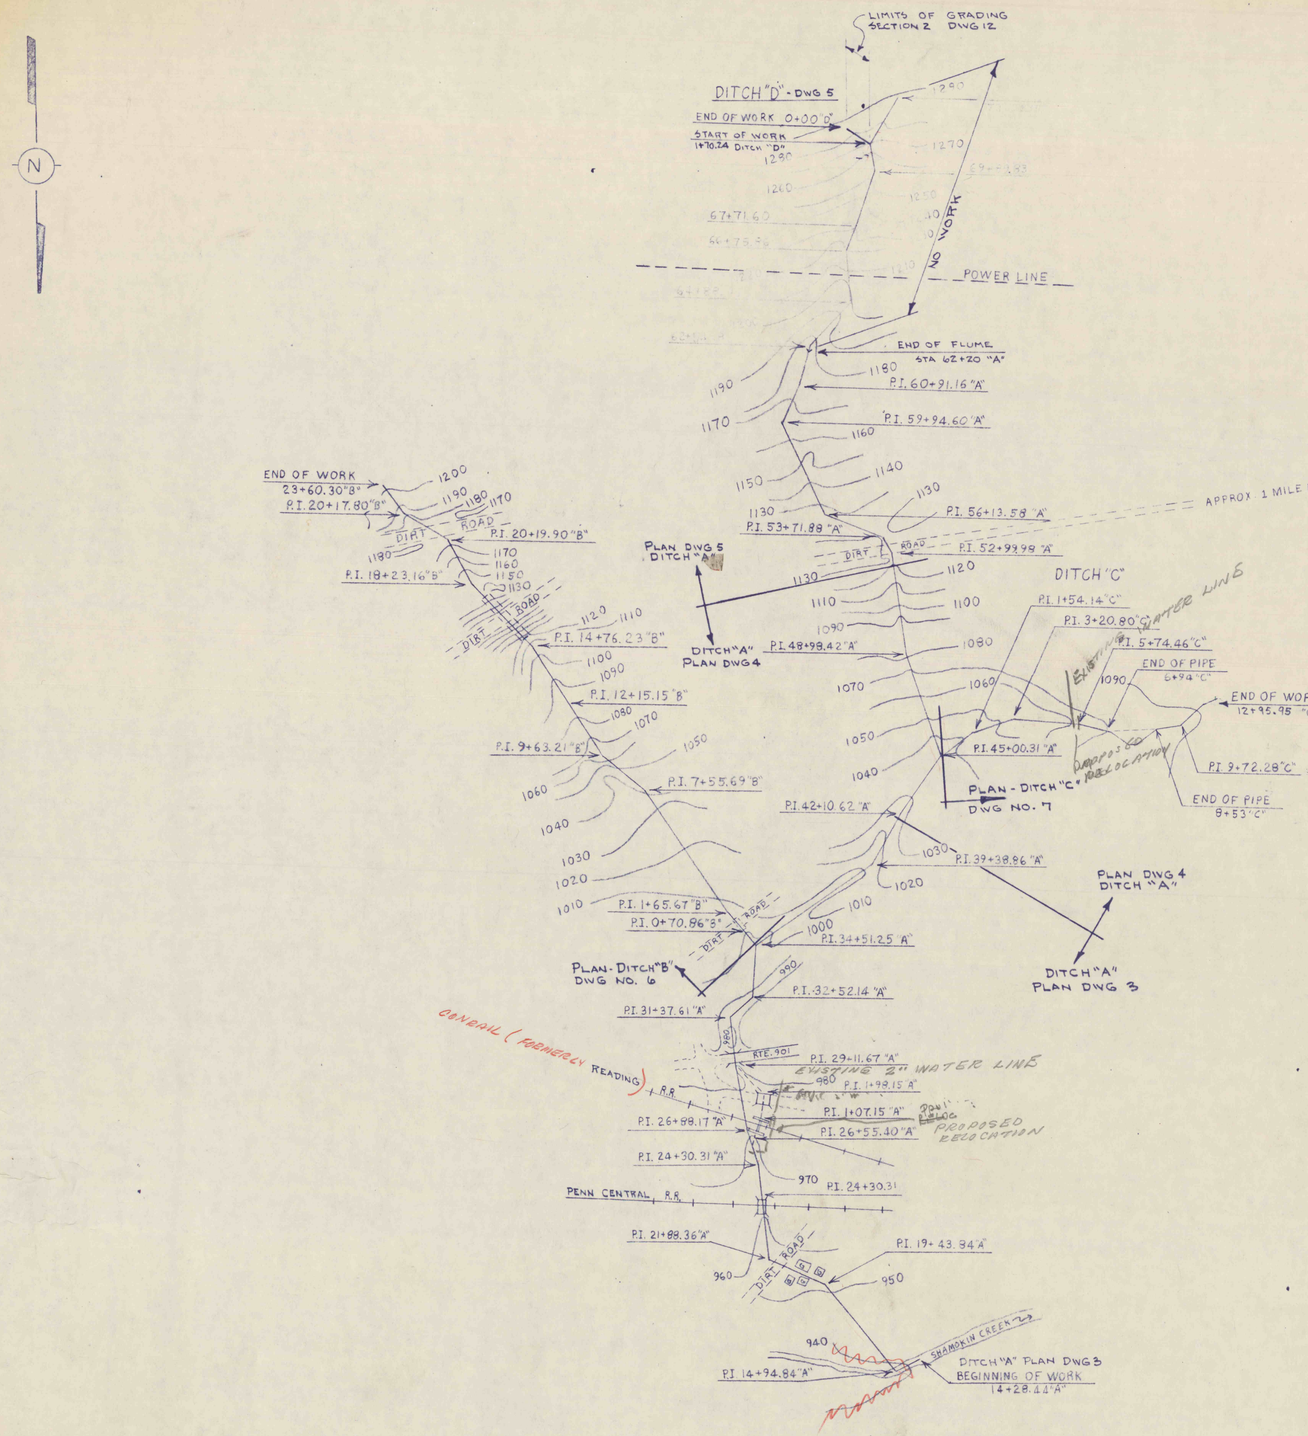

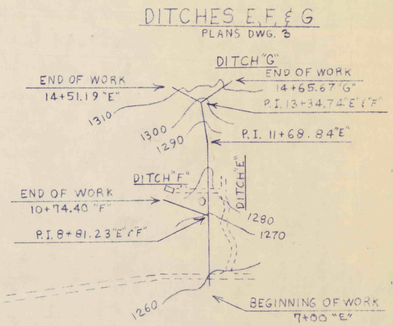

GENERAL PLAN OF CHANNEL WORK

SCALE - 1" = 300' - 0"

THUR MAY 10, 1979

CALL READING RAIL ROAD.
WHAT TITLE DO THEY USE?
IS IT CONRAIL ? UNION & RR ST - 628-2674
DO YOU HAVE JURIDISTRICTION
OF EVISTING READING LINE GOING
THRU VILLAGE OF EXCELSIOR

K & H - MT. CARMEL 1-339-2930
(MR. BRASSINGTON) - CONRAIL

MR. M. KARMAZIN
THUR. MAY 10, 1979
M. M. Z.

NO.	DATE	REVISION	APPR.

SUBMITTED
PROFESSIONAL

APPROVED
CHIEF - DIVISION OF MINE RECLAMATION

APPROVED
DIRECTOR - BUREAU OF DESIGN

COMMONWEALTH OF PENNSYLVANIA
DEPARTMENT OF ENVIRONMENTAL RESOURCES
OFFICE OF RESOURCES MANAGEMENT

PROJECT NO. SL 113-2

MINE DRAINAGE POLLUTION ABATEMENT
QUICK STARTS E, F and G
SHAMOKIN CREEK WATERSHED

JOHN S. LUCKENS ASSOC.
P. O. Box 190 Shamokin, Penna.

GENERAL PLAN OF CHANNEL WORK

DRAWN BY	DATE	DRAWING NO.
CHECKED BY	January 2, 1974	2 of 14
	SCALE 1" = 300'	