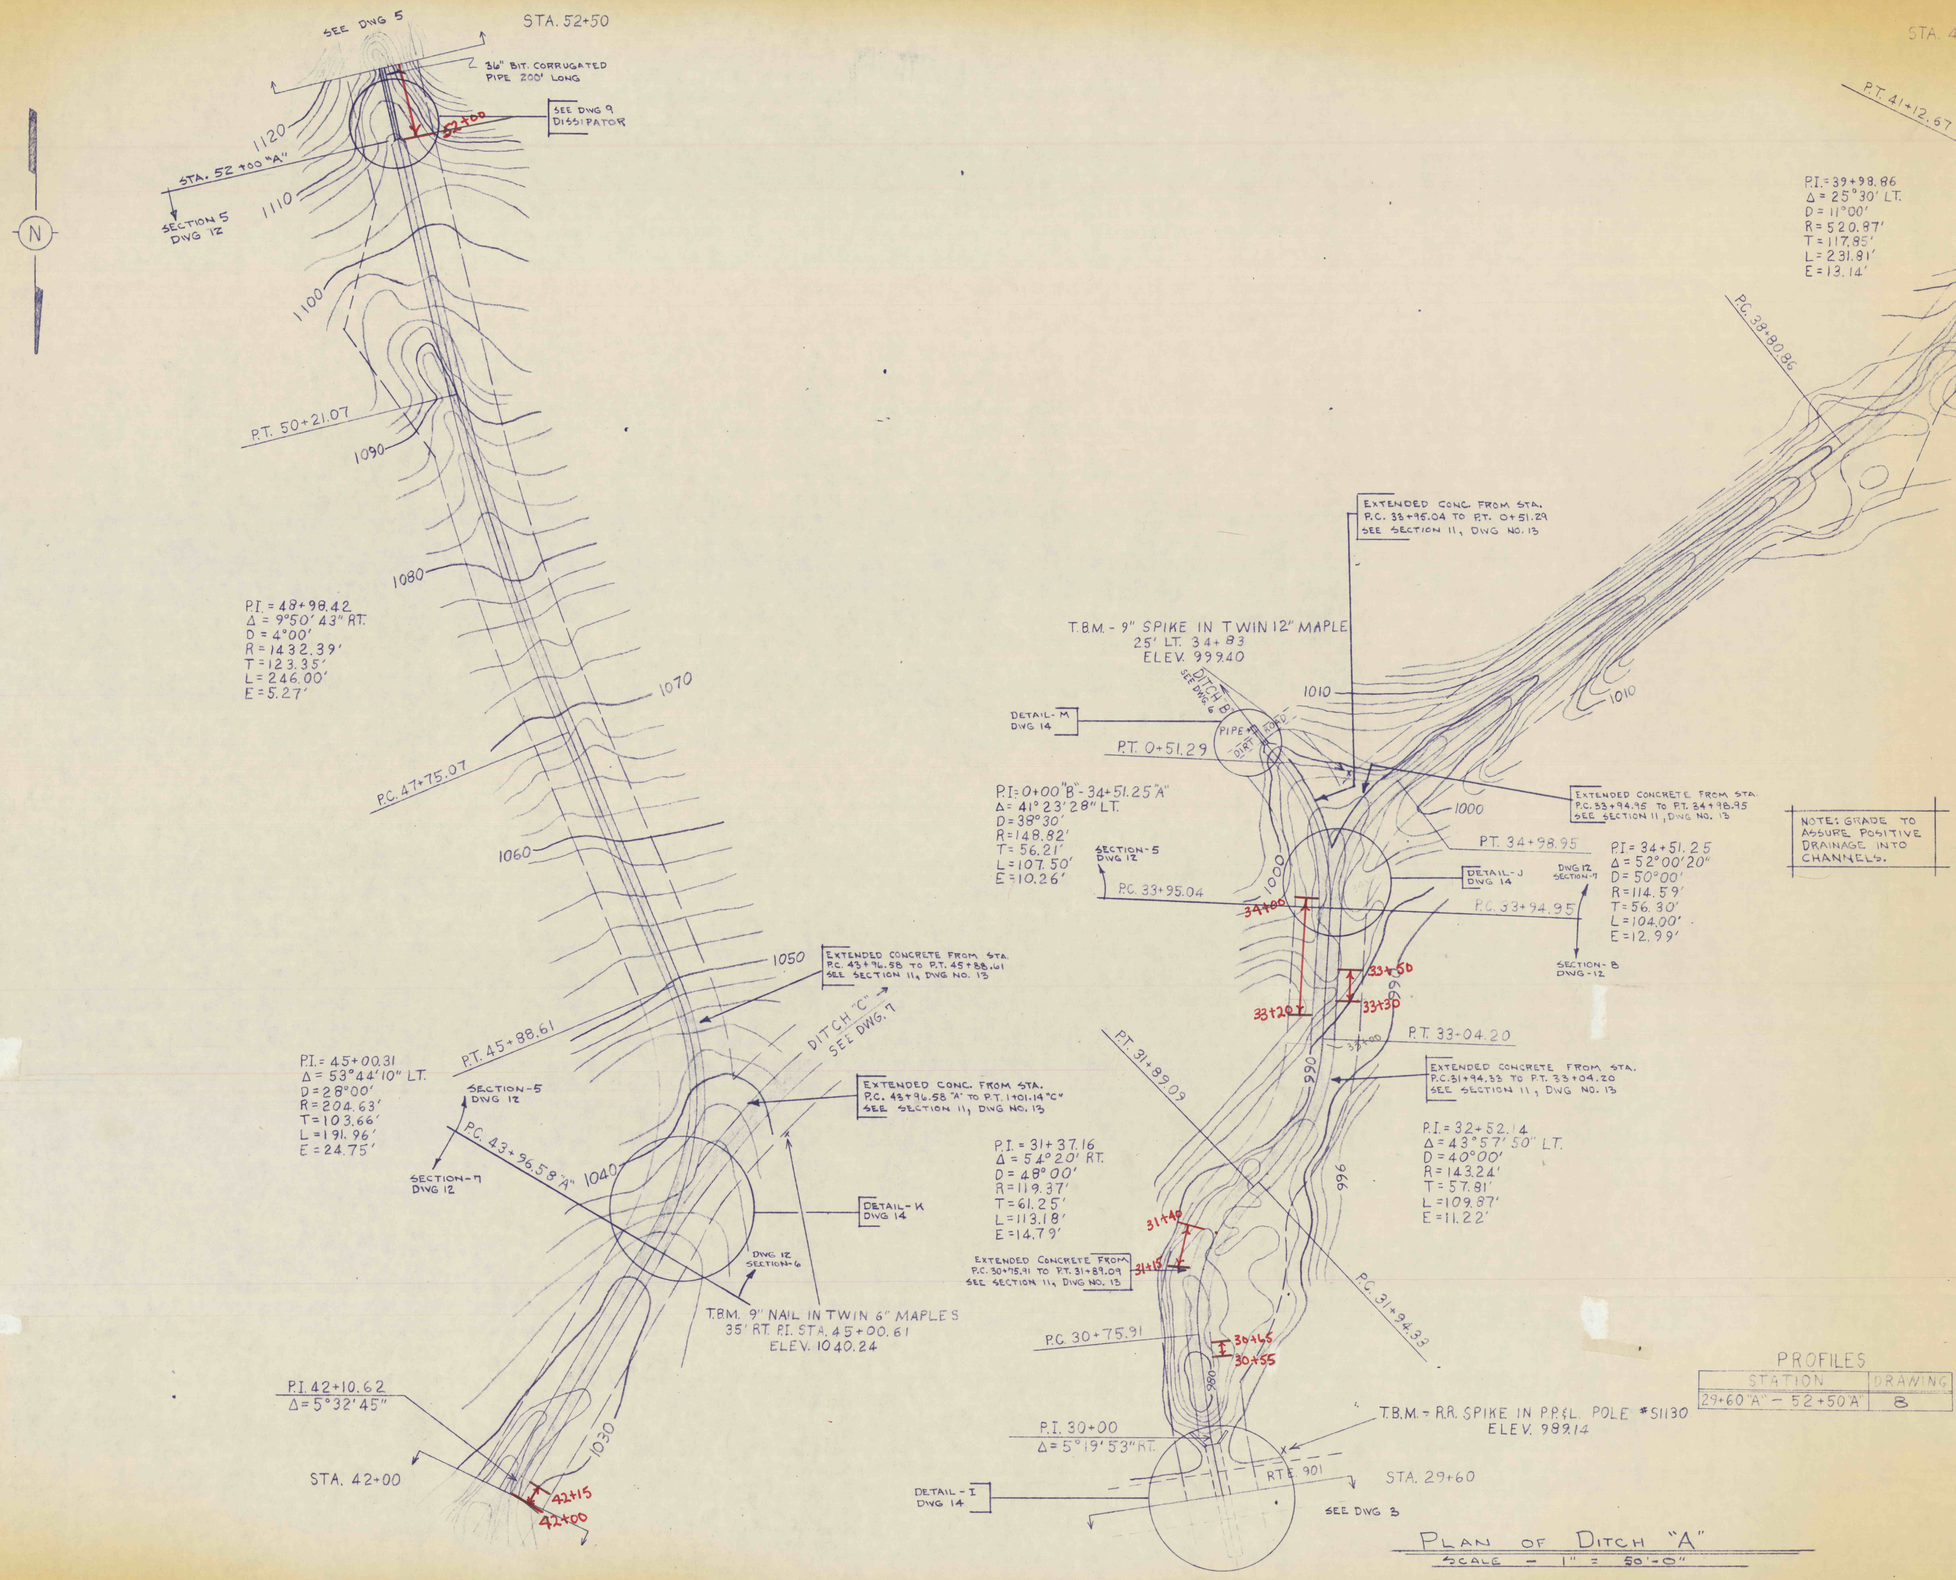

PLAN OF DITCH "A"
SCALE - 1" = 50'-0"

PROFILES

STATION	DRAWING
29+60 "A" - 52+50 "A"	8

NO.	DATE	REVISION	APPR.

SUBMITTED
PROFESSIONAL

APPROVED
Albert A. Ranieri
CHIEF - DIVISION OF MINE RECLAMATION

APPROVED
DuPerrego
DIRECTOR - BUREAU OF DESIGN

COMMONWEALTH OF PENNSYLVANIA
DEPARTMENT OF ENVIRONMENTAL RESOURCES
OFFICE OF RESOURCES MANAGEMENT

PROJECT NO. SL 113-2

MINE DRAINAGE POLLUTION ABATEMENT
QUICK STARTS E, F and G
SHAMOKIN CREEK WATERSHED

JOHN S. LUCKENS ASSOC.
P. O. Box 190 Shamokin, Penna.

PLANS OF DITCH A

DRAWN BY	DATE	DRAWING NO.
	January 2, 1974	4 of 14
CHECKED BY	SCALE 1" = 50'	