


DITCH "B"

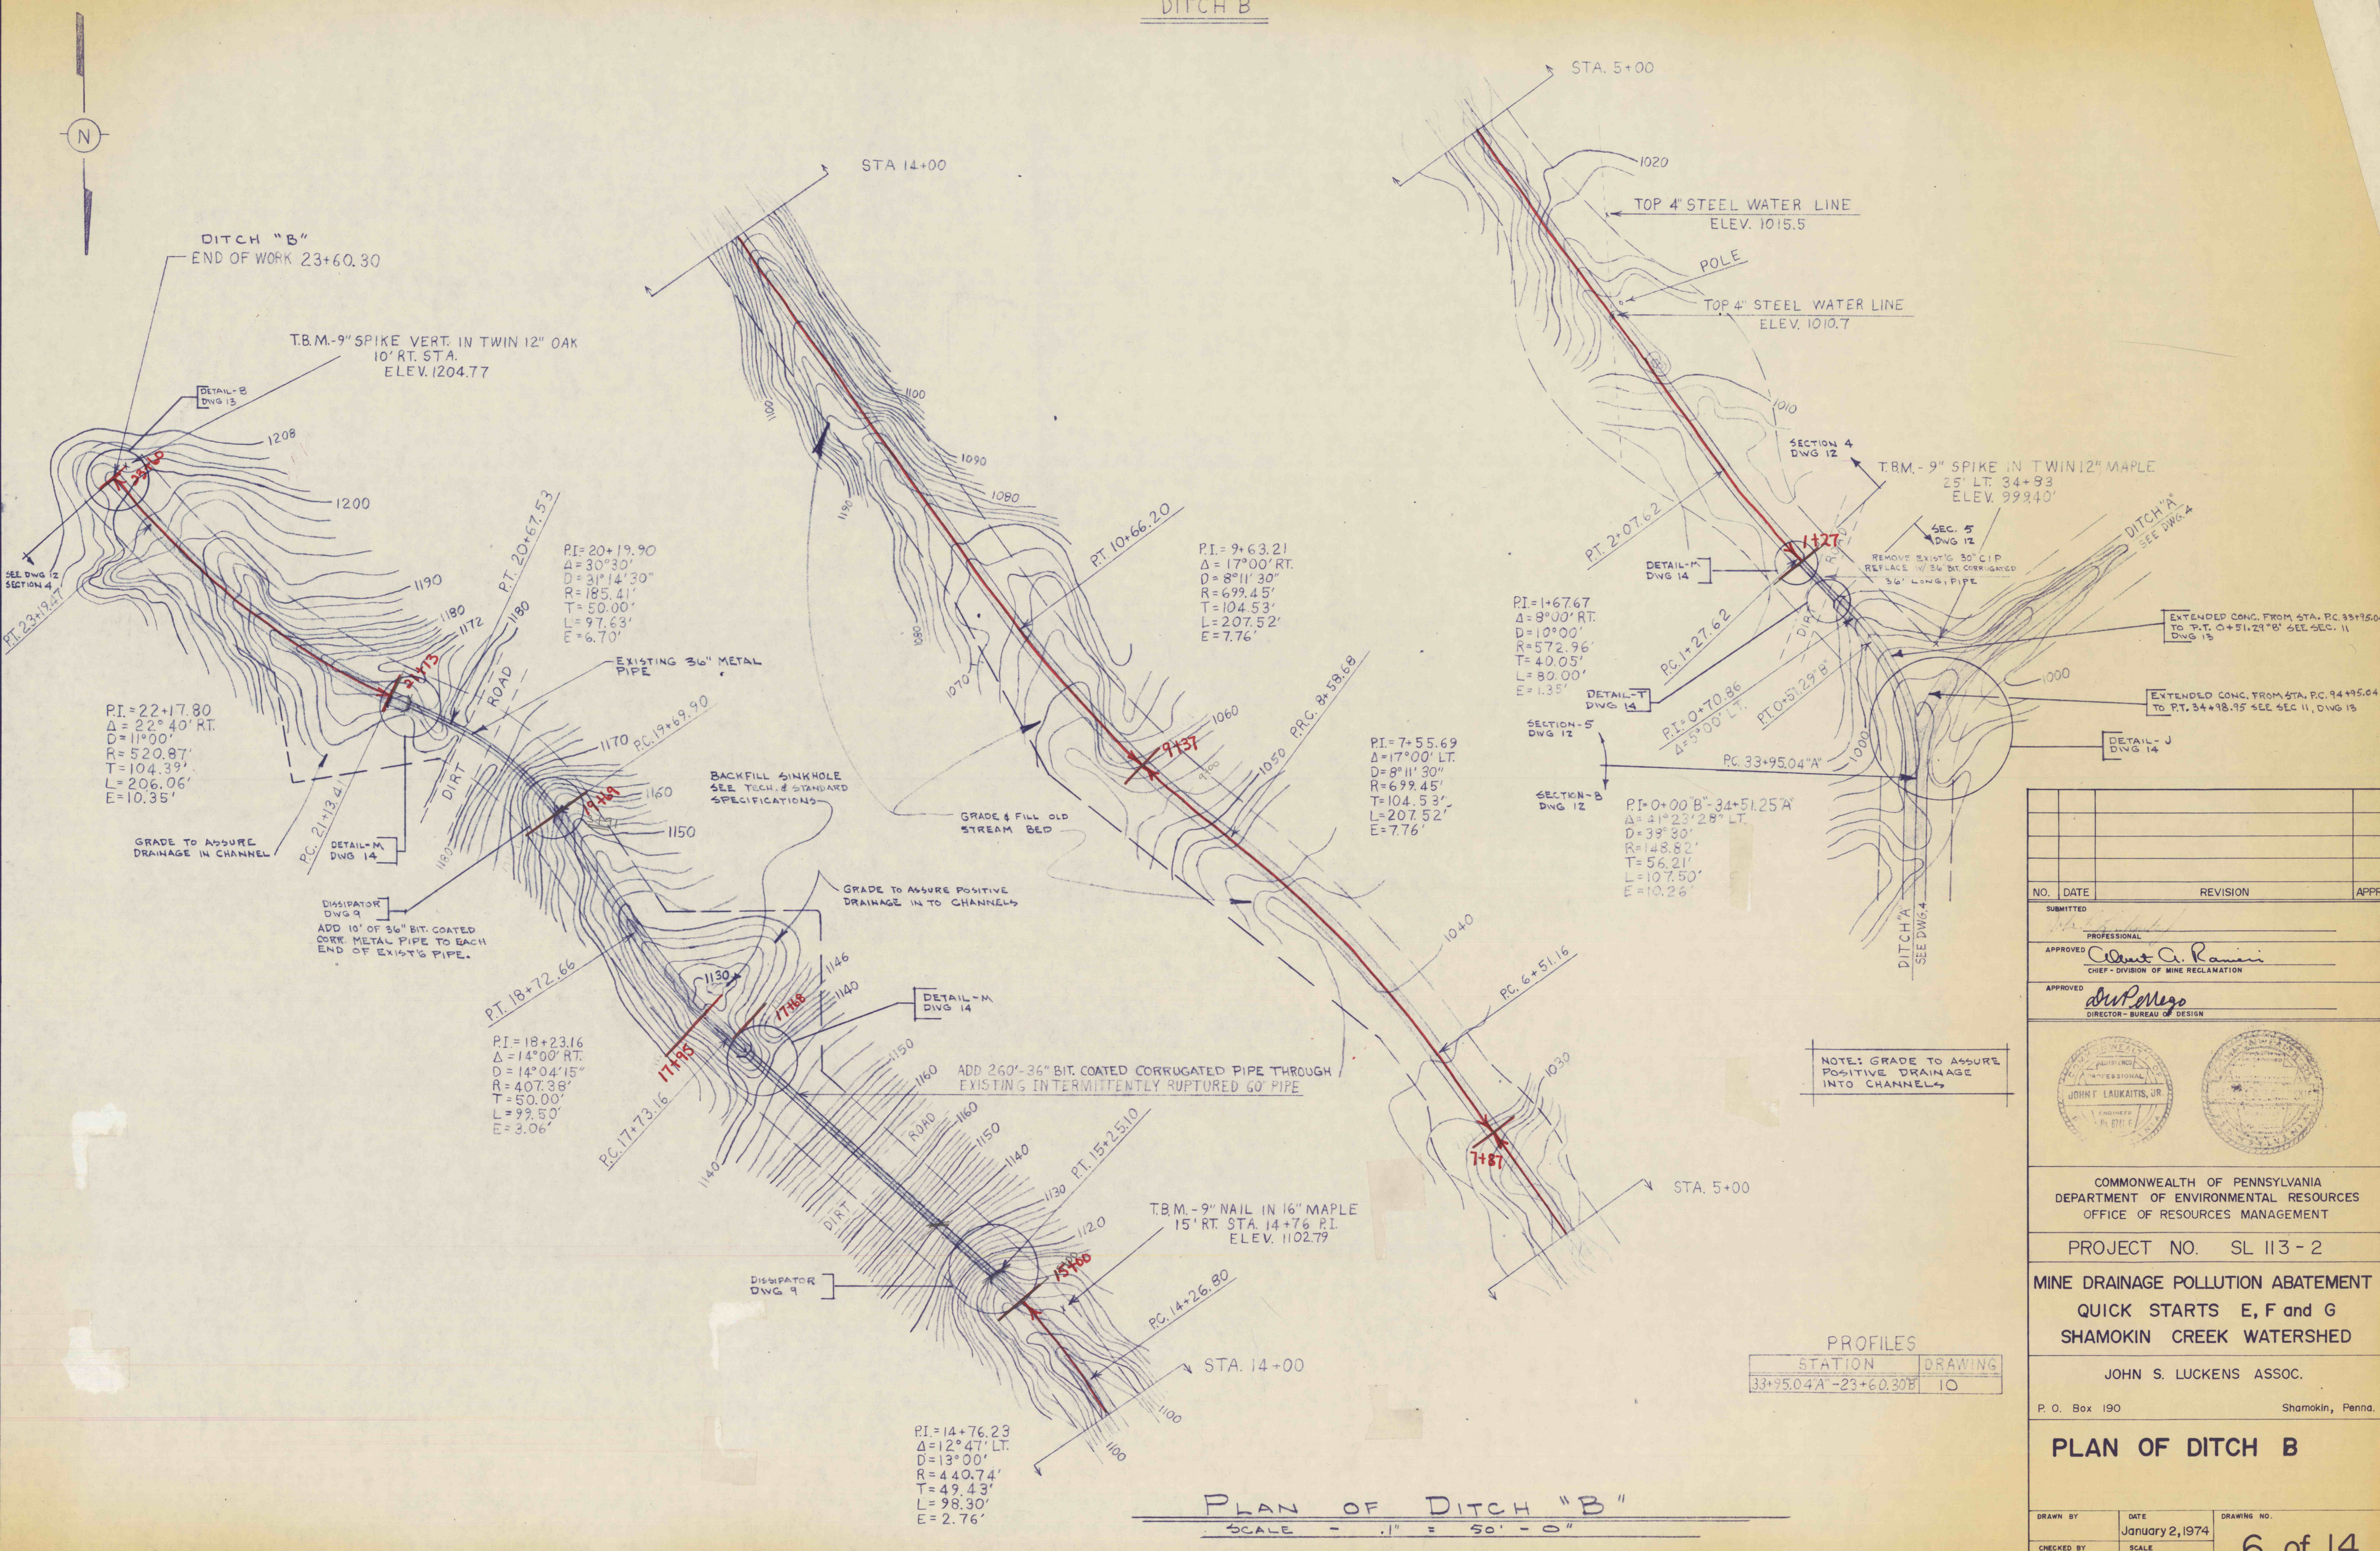


PLAN OF DITCH "B"
SCALE - .1" = 50' - 0"

PROFILES	STATION	DRAWING
	33+95.04 A - 23+60.30 B	10

NO.	DATE	REVISION	APPR.

SUBMITTED
 APPROVED *Robert A. Rainier*
 CHIEF - DIVISION OF MINE RECLAMATION
 APPROVED *Dr. Perigo*
 DIRECTOR - BUREAU OF DESIGN

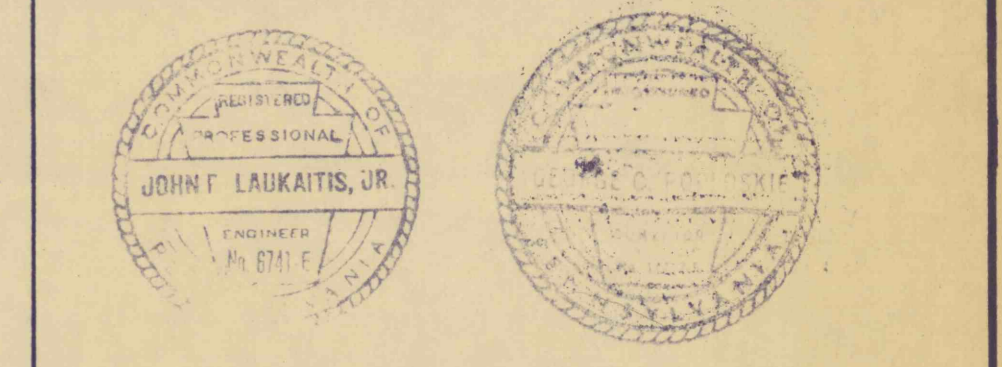

COMMONWEALTH OF PENNSYLVANIA
 DEPARTMENT OF ENVIRONMENTAL RESOURCES
 OFFICE OF RESOURCES MANAGEMENT

PROJECT NO. SL 113 - 2
 MINE DRAINAGE POLLUTION ABATEMENT
 QUICK STARTS E, F and G
 SHAMOKIN CREEK WATERSHED

JOHN S. LUCKENS ASSOC.
 P. O. Box 190 Shamokin, Penna.

PLAN OF DITCH B

DRAWN BY	DATE	DRAWING NO.
	January 2, 1974	
CHECKED BY	SCALE	DRAWING NO.
	1" = 50'	6 of 14