DITCH "C"

Sta. 8+63 - 9+63	Clean Debris from Concrete Channel	± 37 C.Y.
	Erosion - Right Side - Backfill	± 10 C.Y.
	Concrete Slurry	3 C.Y.
	Seeding	± 1,000 S.F.
Sta. 12+16 - 12+56	Erosion - Both Sides of Concrete Channel Compacted Backfill	± 5 C.Y.
	Concrete Slurry	1 C.Y.
	Recommended Riprap	± 5 S.Y.
	12+45 - Provide Rubble Masonry Swale Entrance Riprap	± 50 L.F. 72 S.F.
	Seeding	± 4,200 S.F.

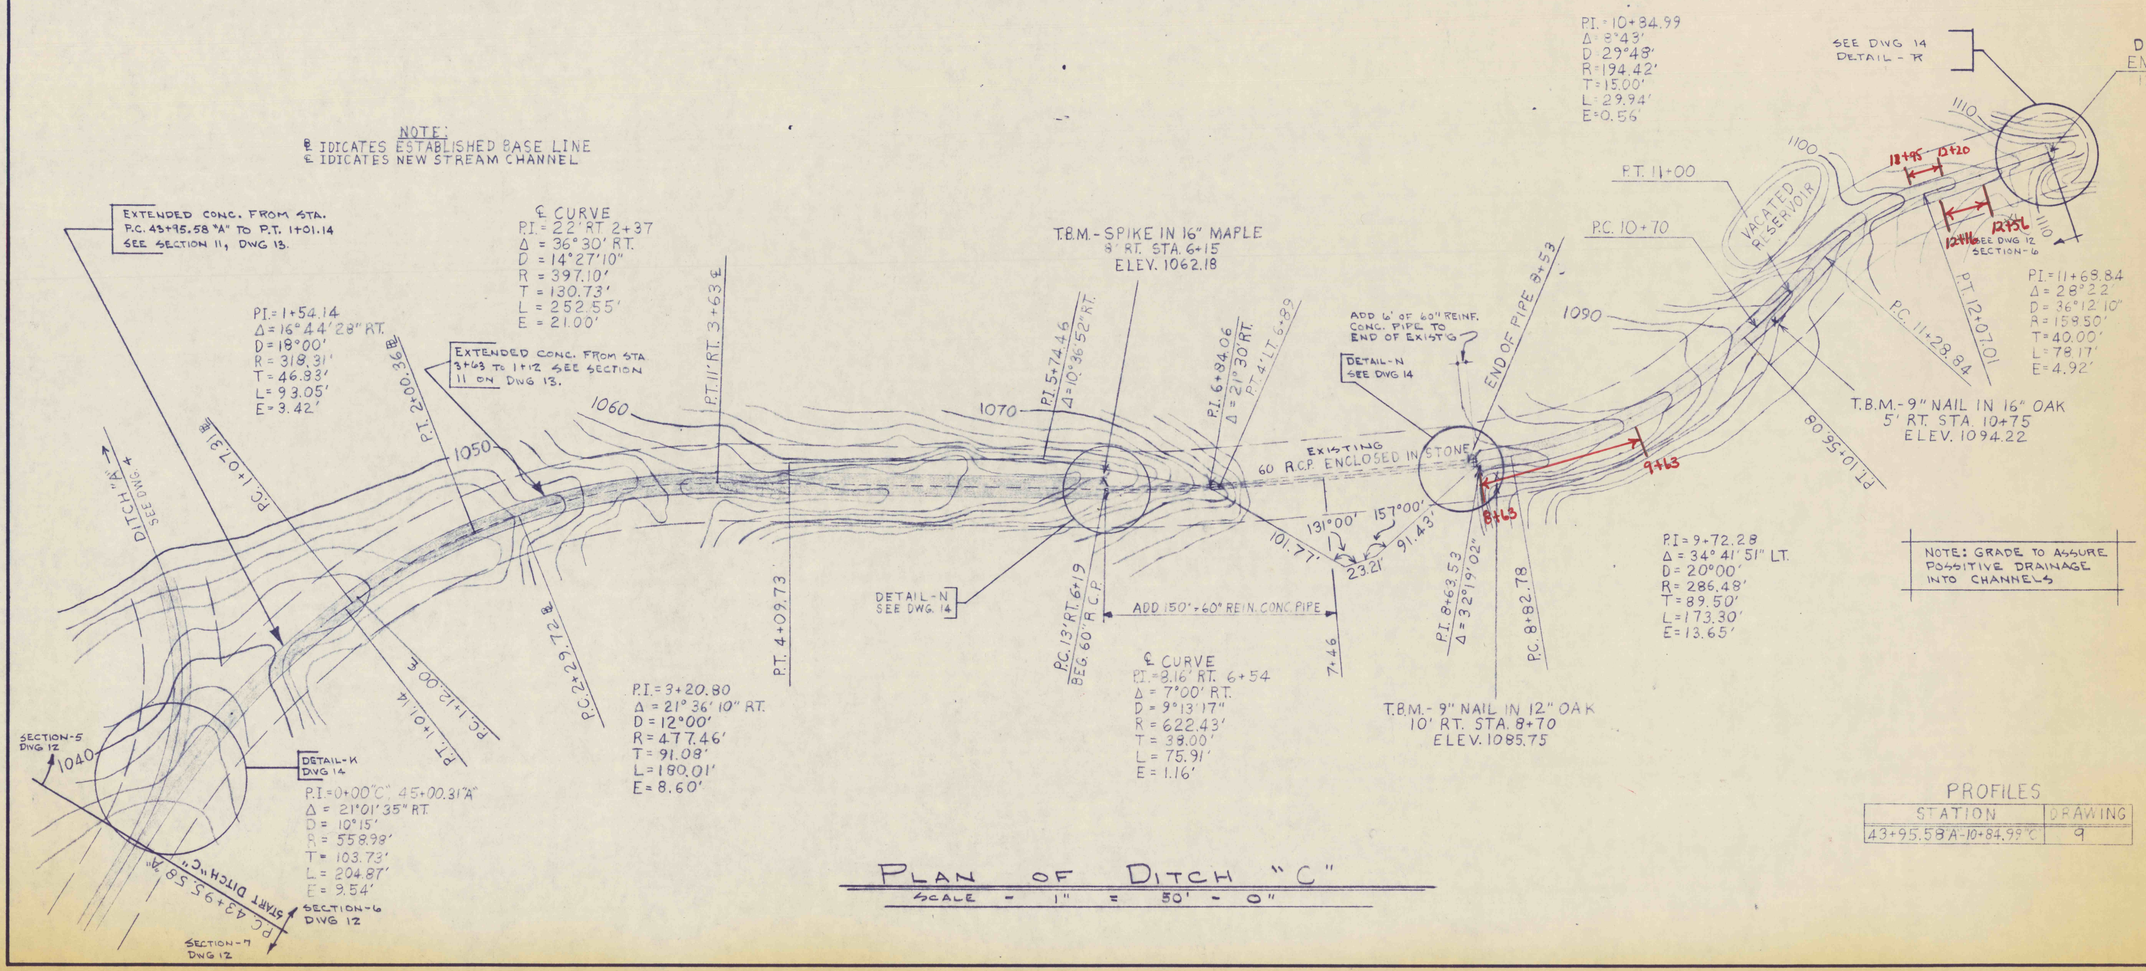

PLAN OF DITCH "C"
SCALE - 1" = 50' - 0"

PROFILES

STATION	DRAWING
43+95.58 "A" - 10+84.99 "C"	9

NO.	DATE	REVISION	APPR.

SUBMITTED
PROFESSIONAL
APPROVED Albert A. Rainieri
CHIEF - DIVISION OF MINE RECLAMATION
APPROVED DW Perrego
DIRECTOR - BUREAU OF DESIGN

COMMONWEALTH OF PENNSYLVANIA
DEPARTMENT OF ENVIRONMENTAL RESOURCES
OFFICE OF RESOURCES MANAGEMENT

PROJECT NO. SL 113 - 2

MINE DRAINAGE POLLUTION ABATEMENT
QUICK STARTS E, F and G
SHAMOKIN CREEK WATERSHED

JOHN S. LUCKENS ASSOC.
P. O. Box 190 Shamokin, Penna.

PLAN OF DITCH C

DRAWN BY	DATE	DRAWING NO.
	January 2, 1974	7 of 14
CHECKE BY	SCALE 1" = 50'	