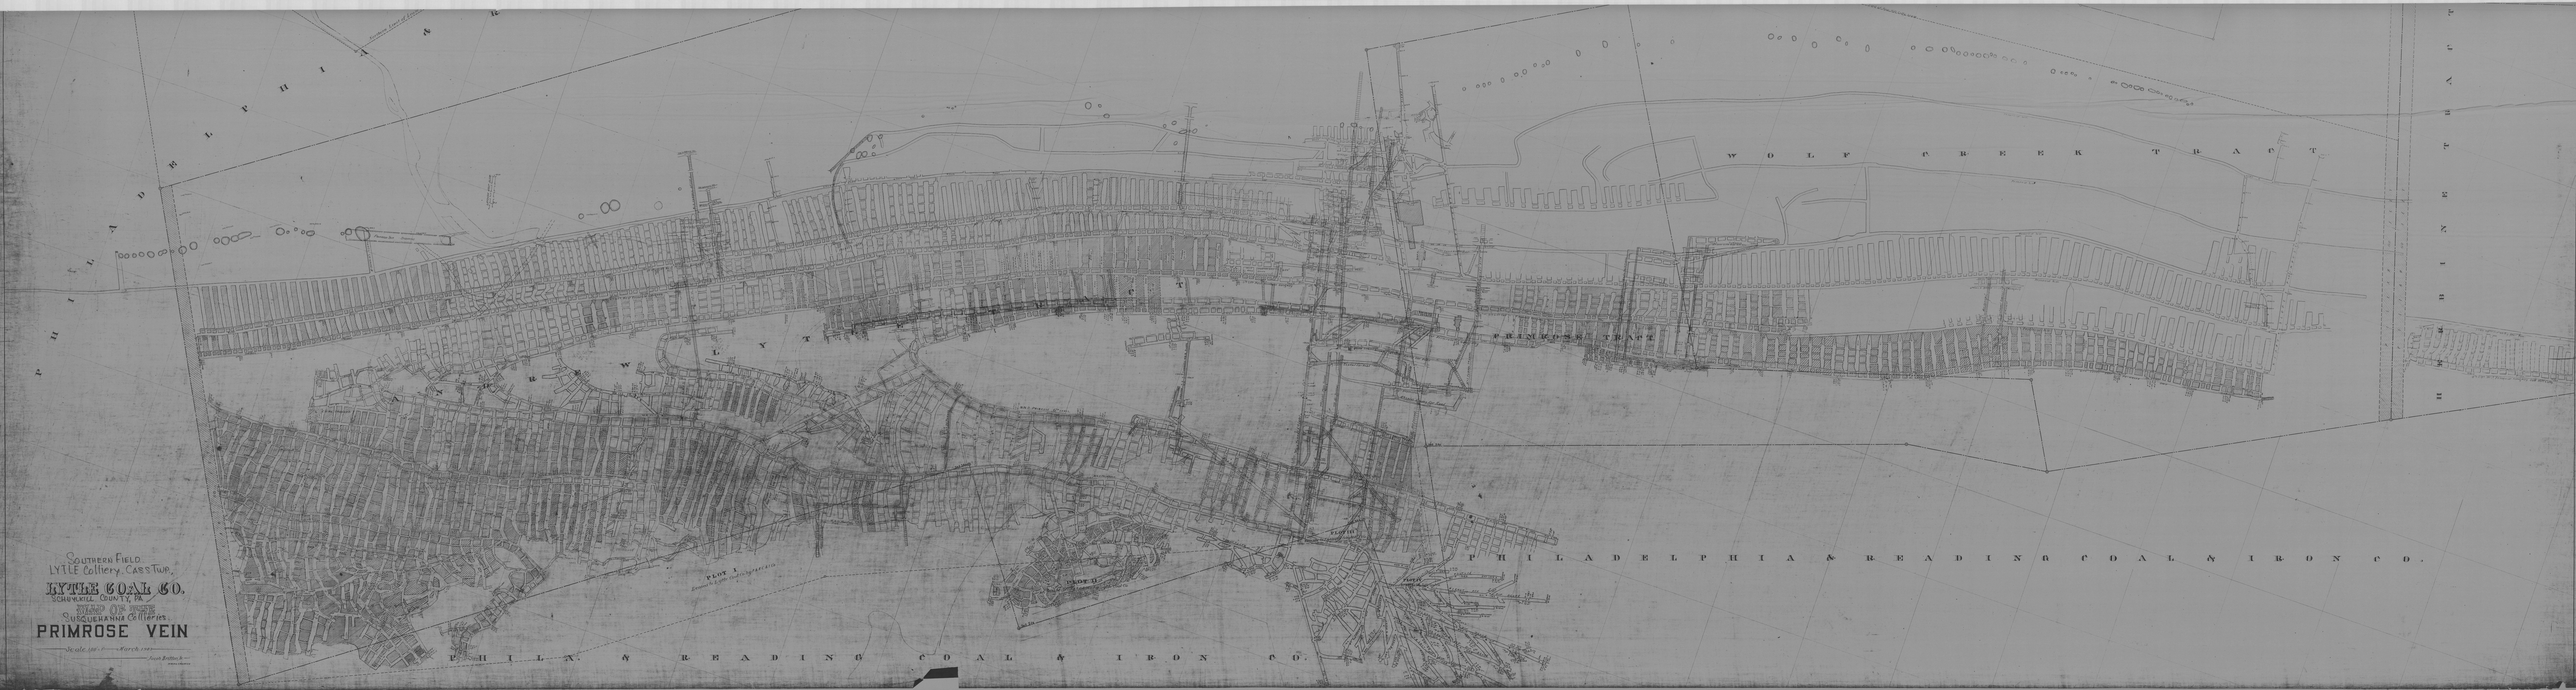
PHILADELPHIA
WOLF CREEK TRACT
PRIMROSE TRACT
THE BINNEY TRACT
PHILA. & READING COAL & IRON CO.
PHILADELPHIA & READING COAL & IRON CO.
Southern Field
LYTLE Colliery, Cass Twp.
LYTLE COAL CO.
Schuylkill County, Pa.
MAP OF THE
Susquehanna Collieries
PRIMROSE VEIN