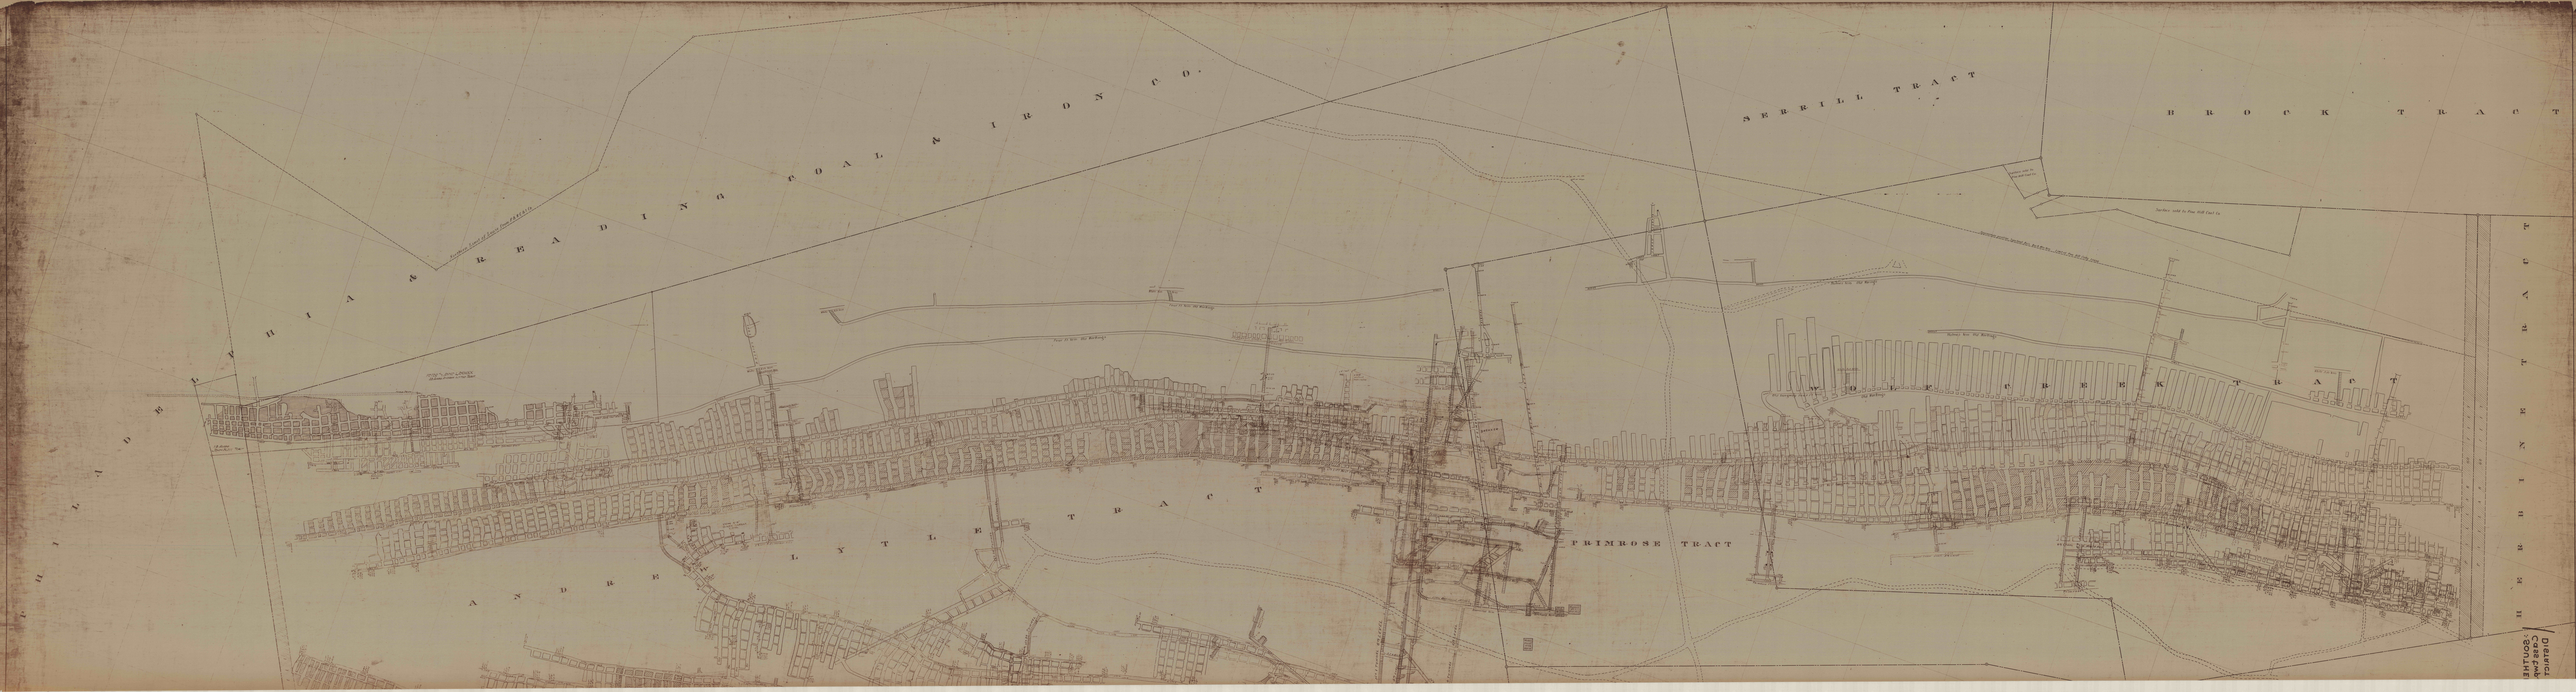
PHILADELPHIA & READING COAL & IRON CO.
SERRILL TRACT
BROCK TRACT
ANDREW LYTLE TRACT
PRIMROSE TRACT
MOLE CREEK TRACT
HERBINNETT TRACT
DISTRICT
CASSEWAY
SOUTHE