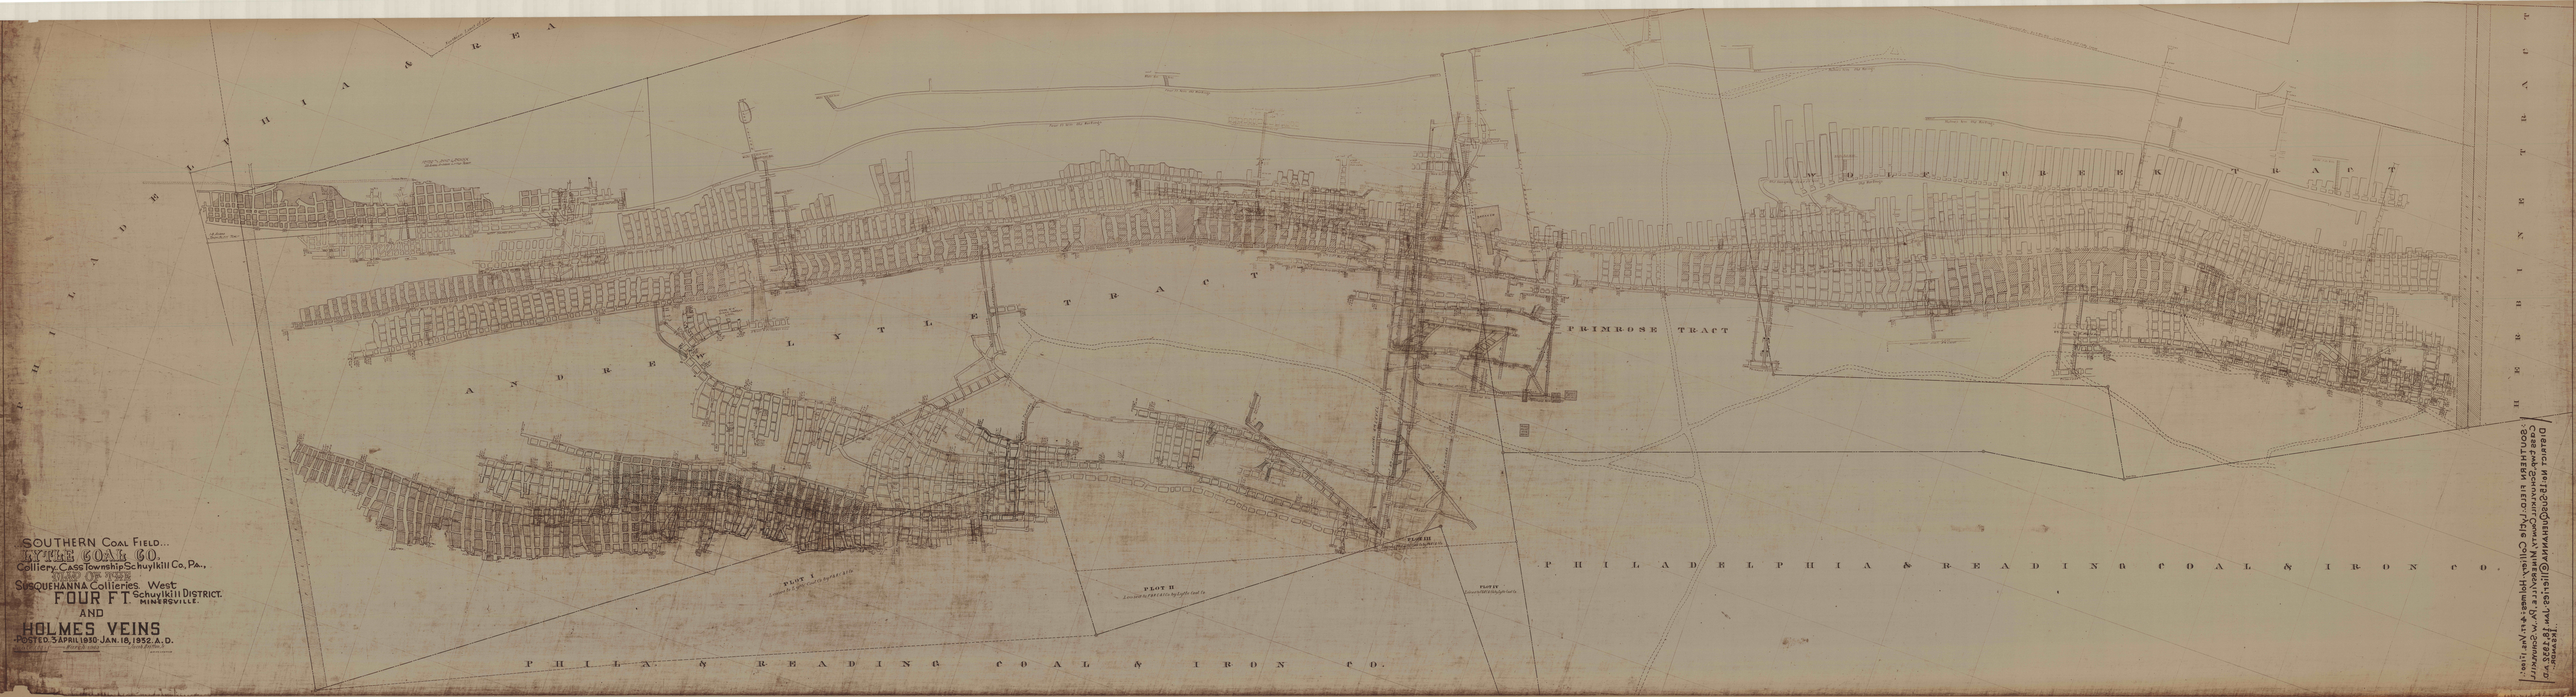
SOUTHERN COAL FIELD...
LYTLE COAL CO.
Colliery. Cass Township Schuylkill Co, Pa.,
SUSQUEHANNA Collieries West
FOUR FT. Schuylkill DISTRICT. MINERSVILLE.
AND
HOLMES VEINS
POSTED 3 APRIL 1930 JAN. 18, 1932. A. D.
PHILADELPHIA & READING COAL & IRON CO.
PHILA. & READING COAL & IRON CO.
PHILADELPHIA & READING COAL & IRON CO.
ANDREW LYTLE TRACT
PRIMROSE TRACT
WOLF CREEK TRACT
PLOT I
PLOT II
PLOT III
PLOT IV
PHILADELPHIA & READING COAL & IRON CO.
HERBINE TRACT
JAYLE TRACT