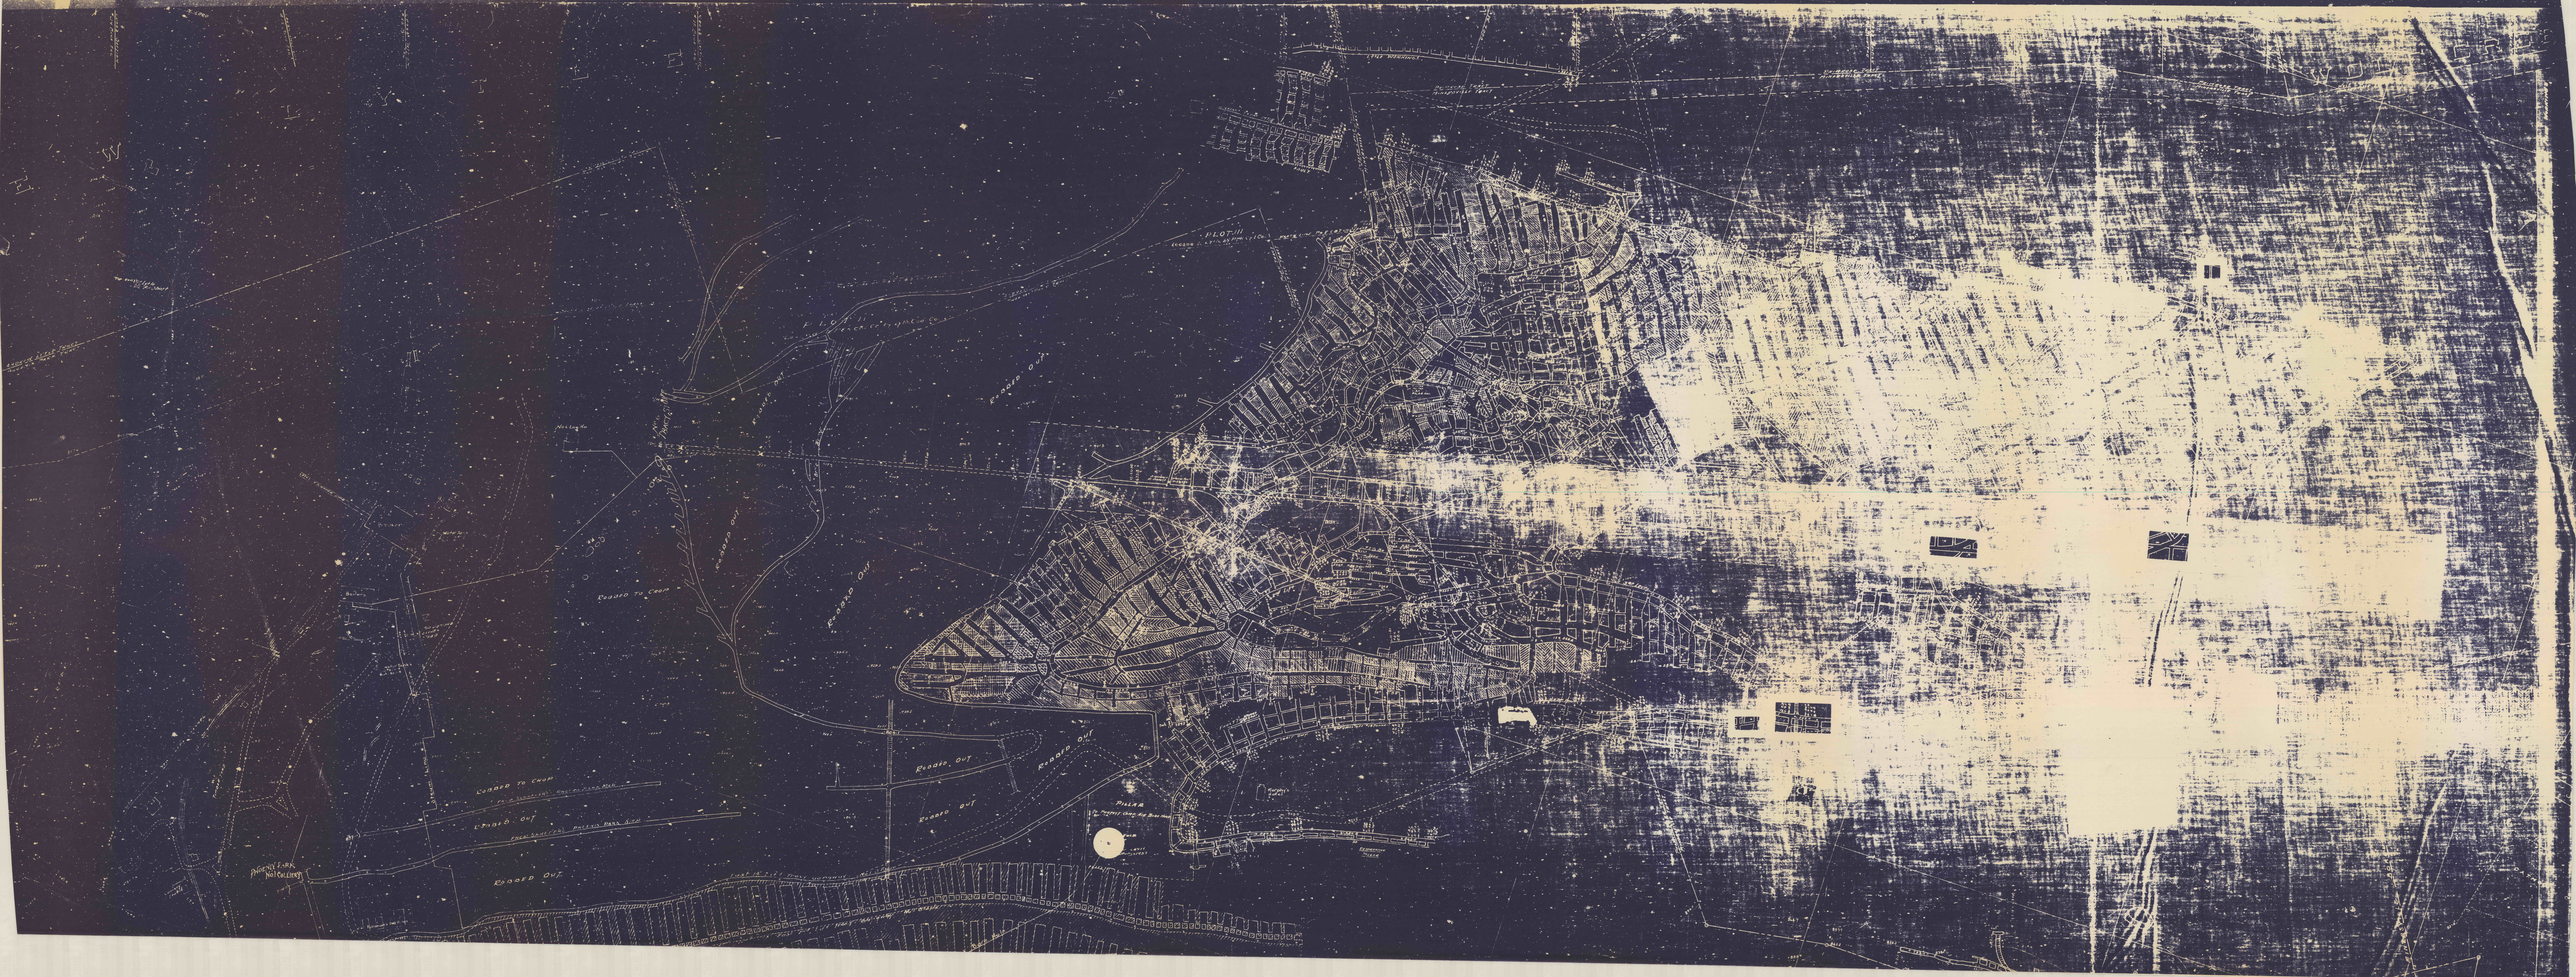

ANDREW LYTLE TRACT
PHOENIX PARK TRACT
Lytle Air Shaft
PLOT II
Leased to Phila & Read. C. & I. Co. by Lytle Coal Co.
ROBBED OUT
No 6 Eng Ho
No 6 TRACY SLOPE
Breaker
Water Tank
Boilers
Water Tanks
Steam Line
Timber Yard
Colliery Stables
ROBBED TO CROP
ROBBED OUT
ROBBED TO CROP
From Schaefer's Phoenix Park Map
ROBBED OUT
From Schaefer's Phoenix Park Map
ROBBED OUT
PHOENIX PARK No 1 COLLIERY
Foreman's Dwellings
East 1st Lift Tracy Gangway No 1 Slope
East 2nd Lift Tracy Gangway
LYTLE WORKINGS
PRIMROSE TRACT
MINERSVILLE TRACT
FAULT
PLOT III
Leased to Lytle by Ph. C & I Co.
ROBBED OUT
ROBBED OUT
ROBBED OUT
ROBBED OUT
PILLAR
To Protect Camp Air Bore Hole
Murphy's Hotel
FAULT
W. S. Dip Tracy Gwy
RESERVATION PILLAR
Bore Hole
803.1
PRIMROSE TRACT
MINERSVILLE TRACT