


C. 3.1

WALTER J. MANHART REG. SUR.
2048 EIK AVE.
POTTSVILLE, PENNA. 17901

MINE MAP
BLYTHE TWP. SCHUYLKILL CO. PA.
SHOWING MINE WORKINGS IN RELATION
TO LUCYANNA COLLIERY ON LANDS OF
THE SCHUYLKILL CO. COMM.

Jan 25, 1974 Scale 1" = 100'
Walter J. Manhart R.S. #14708E
RETURN POSTAGE GUARANTEED

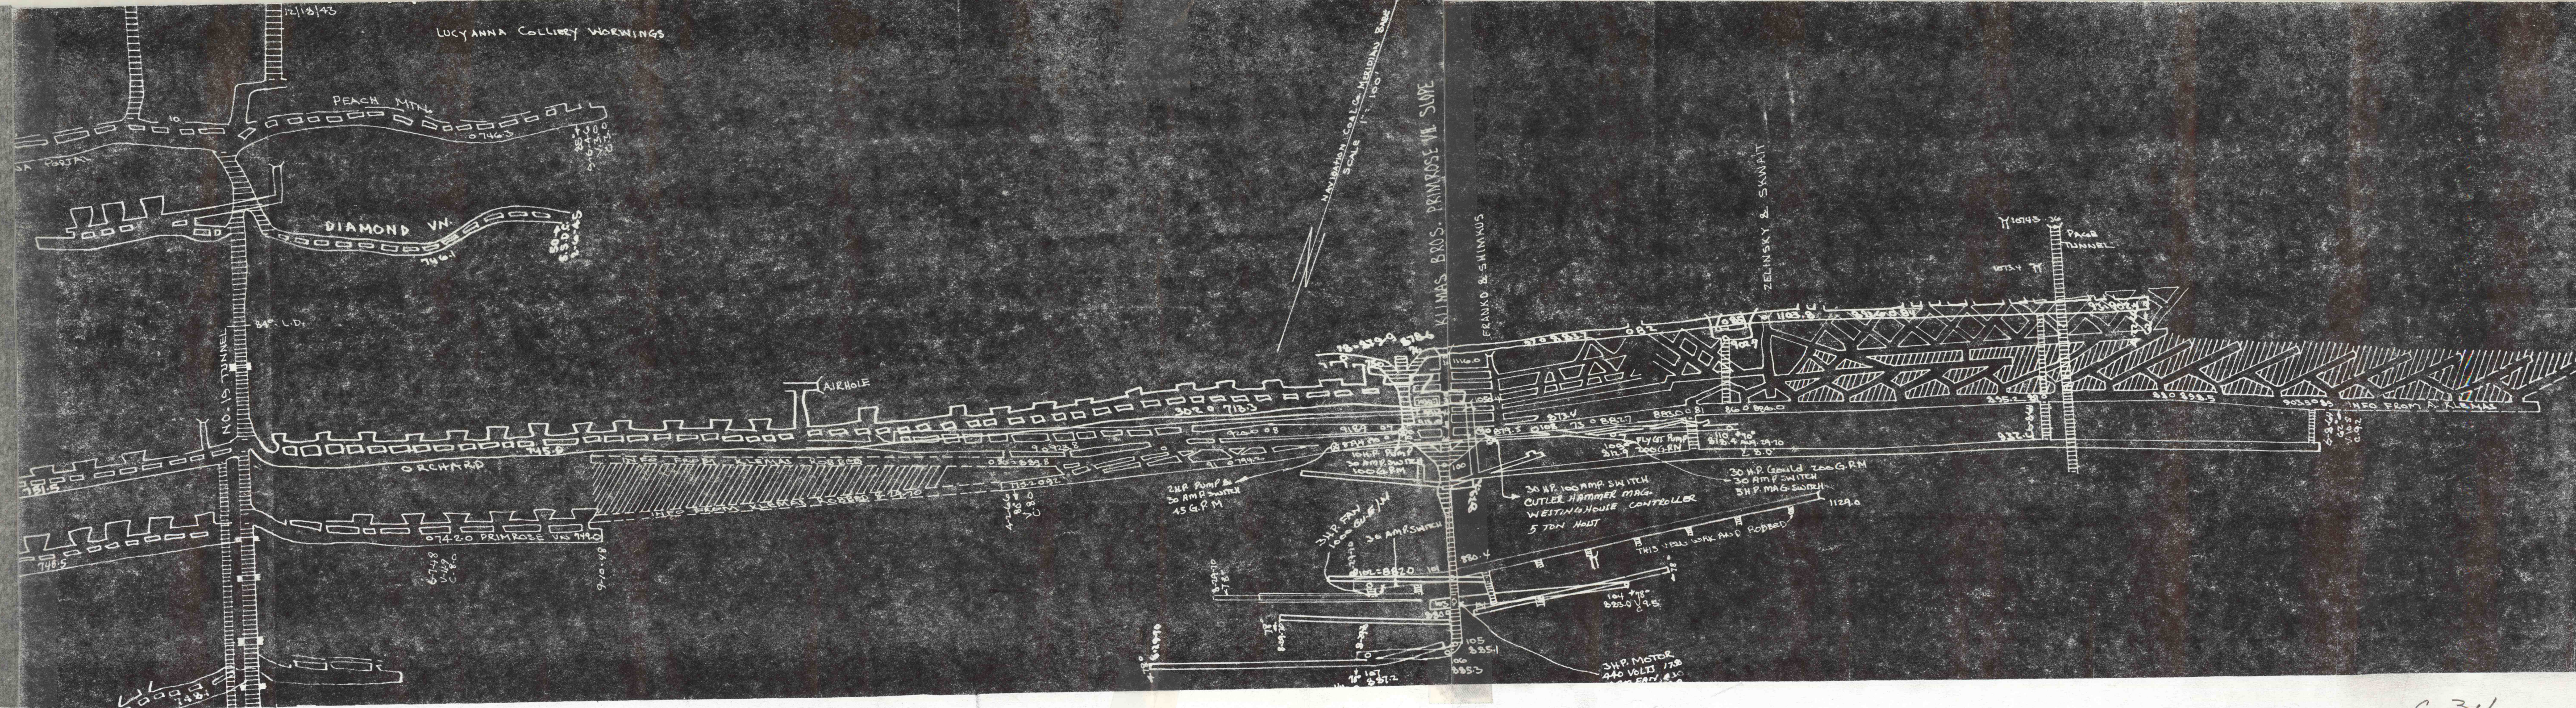

SOUTH OF NEW PHILADELPHIA

C. 3.1