


TRACT JEREMIAH JACKSON TRACT

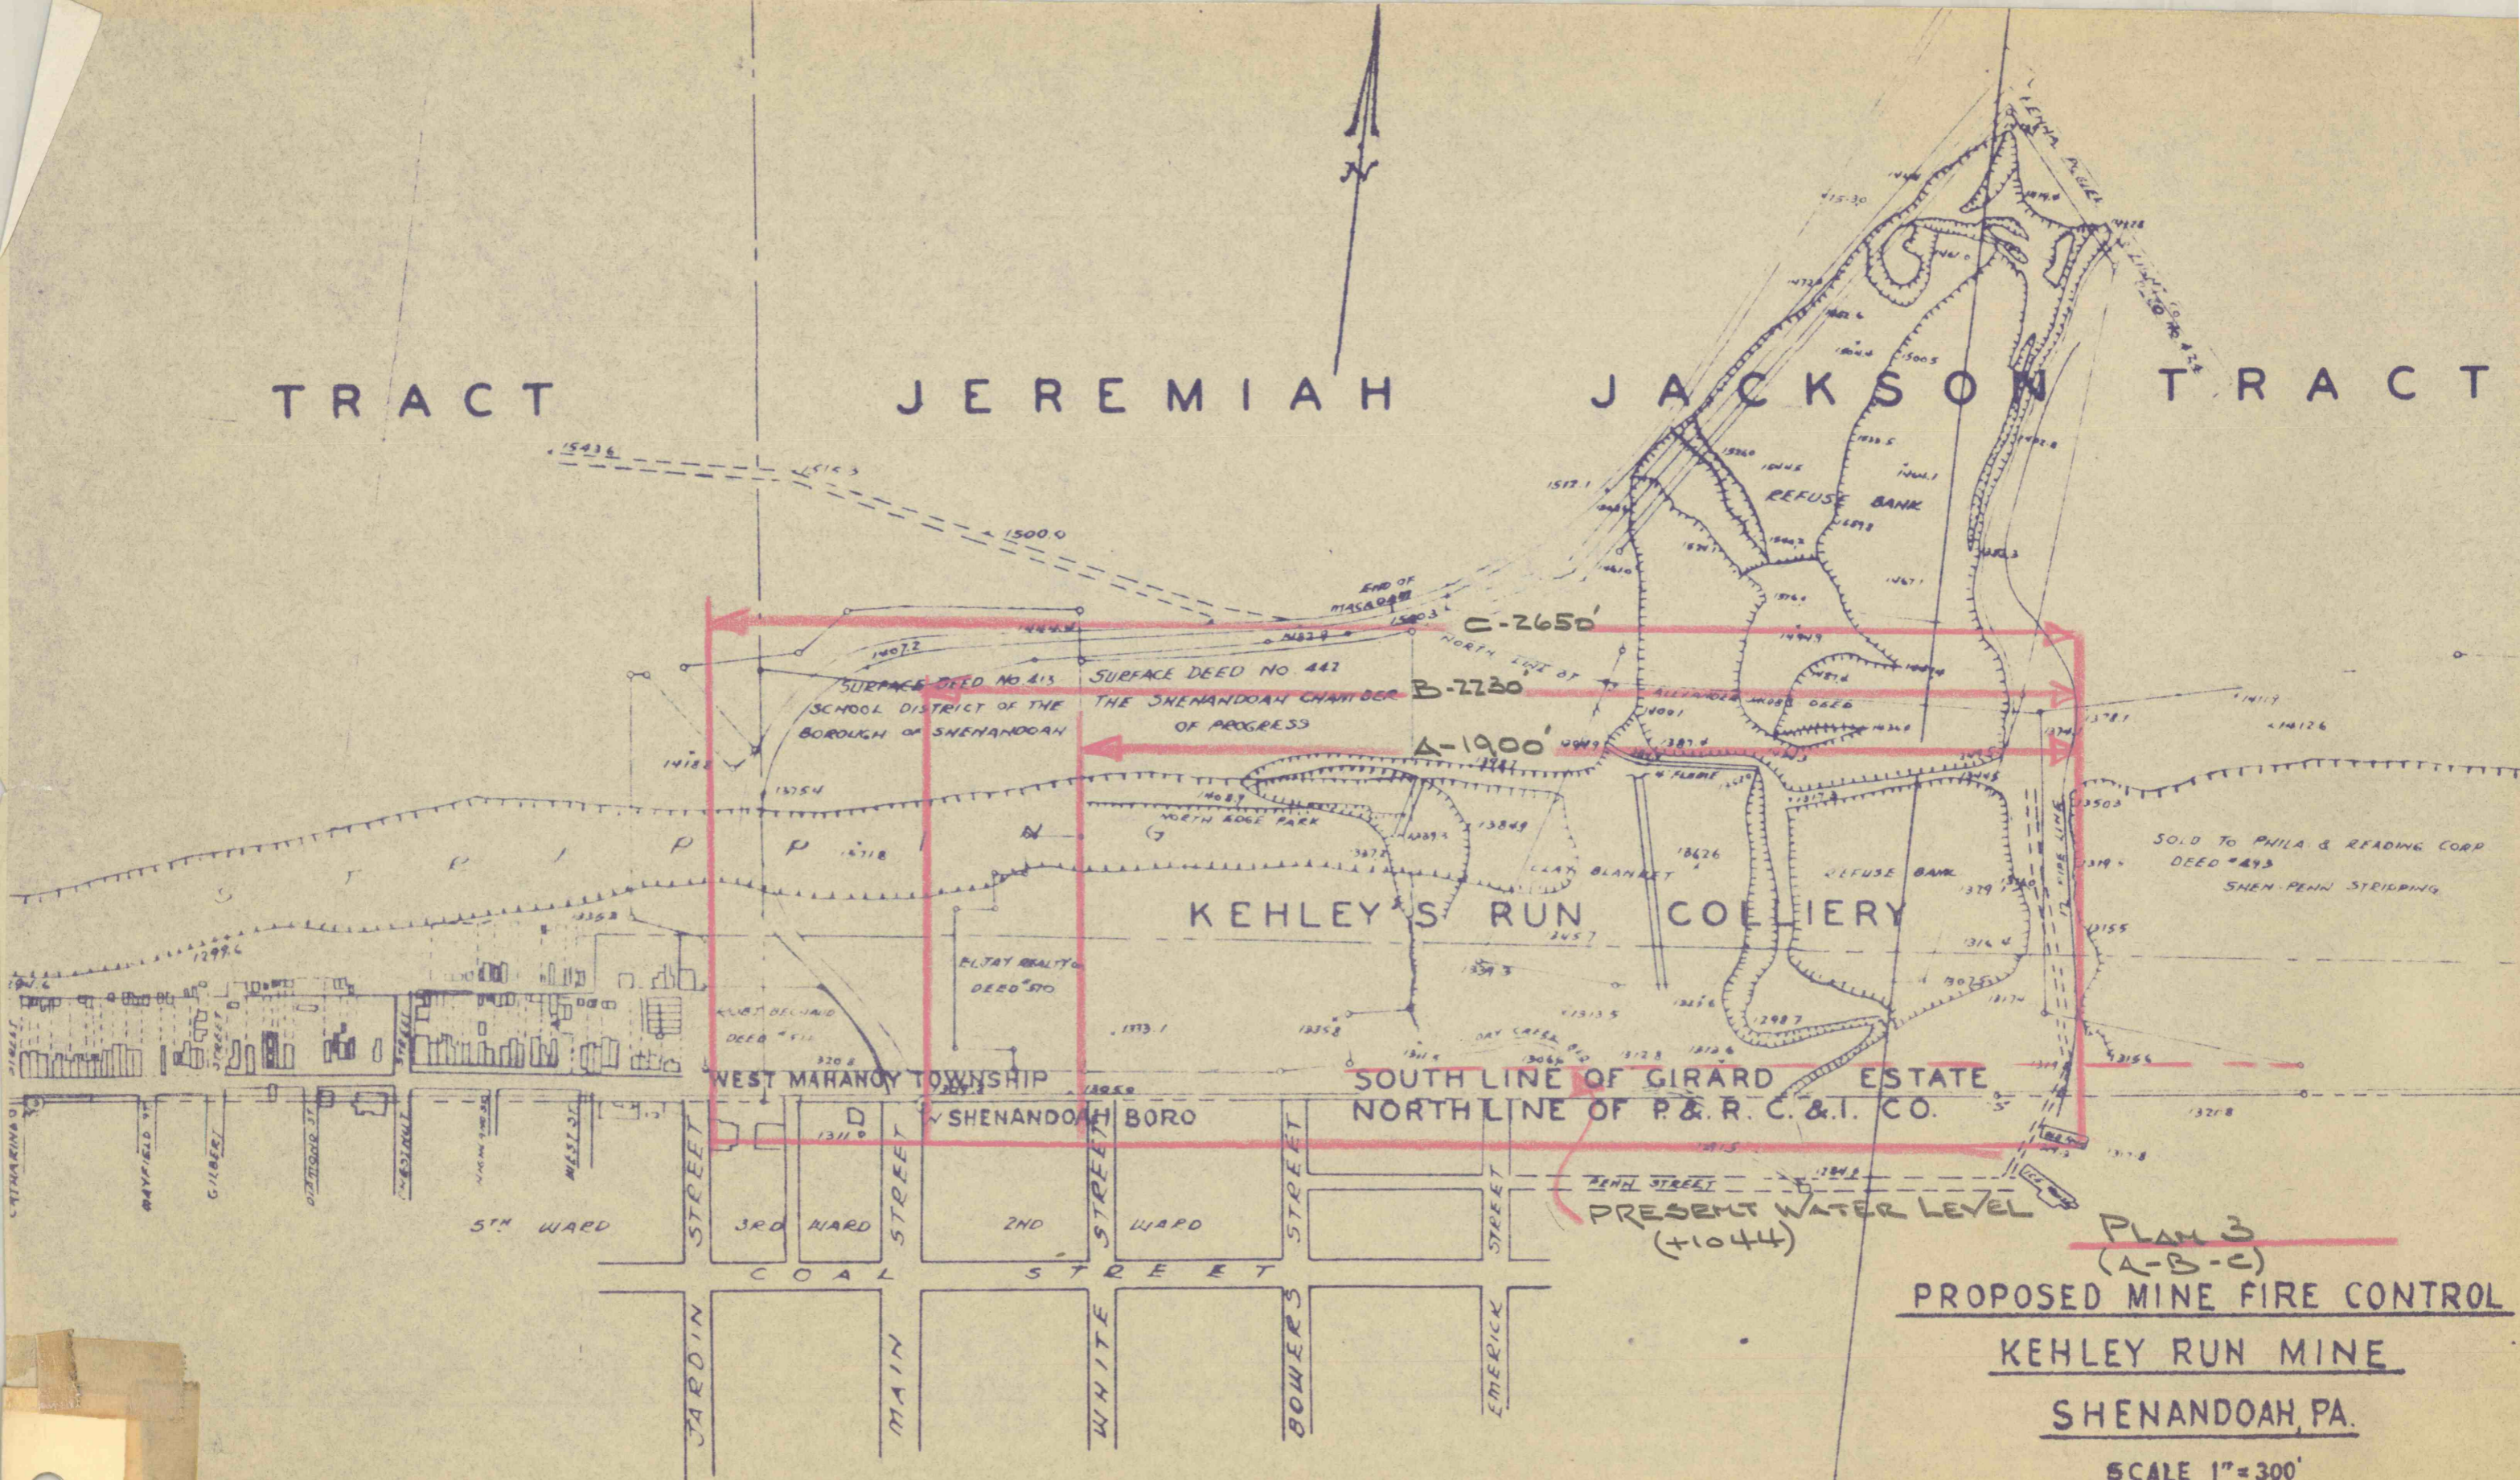

KEHLEY'S RUN COLLIERY

SOLD TO PHILA. & READING CORP DEED #493 SHEN-PENN STRIPPING

SOUTH LINE OF GIRARD ESTATE NORTH LINE OF P. & R. C. & I. CO.

PRESENT WATER LEVEL (+1044)

PLAN 3 (A-B-C) PROPOSED MINE FIRE CONTROL

KEHLEY RUN MINE SHENANDOAH, PA.

SCALE 1"=300' MARCH 19, 1964