


TRACT

JEREMIAH

JACKSON

TRACT

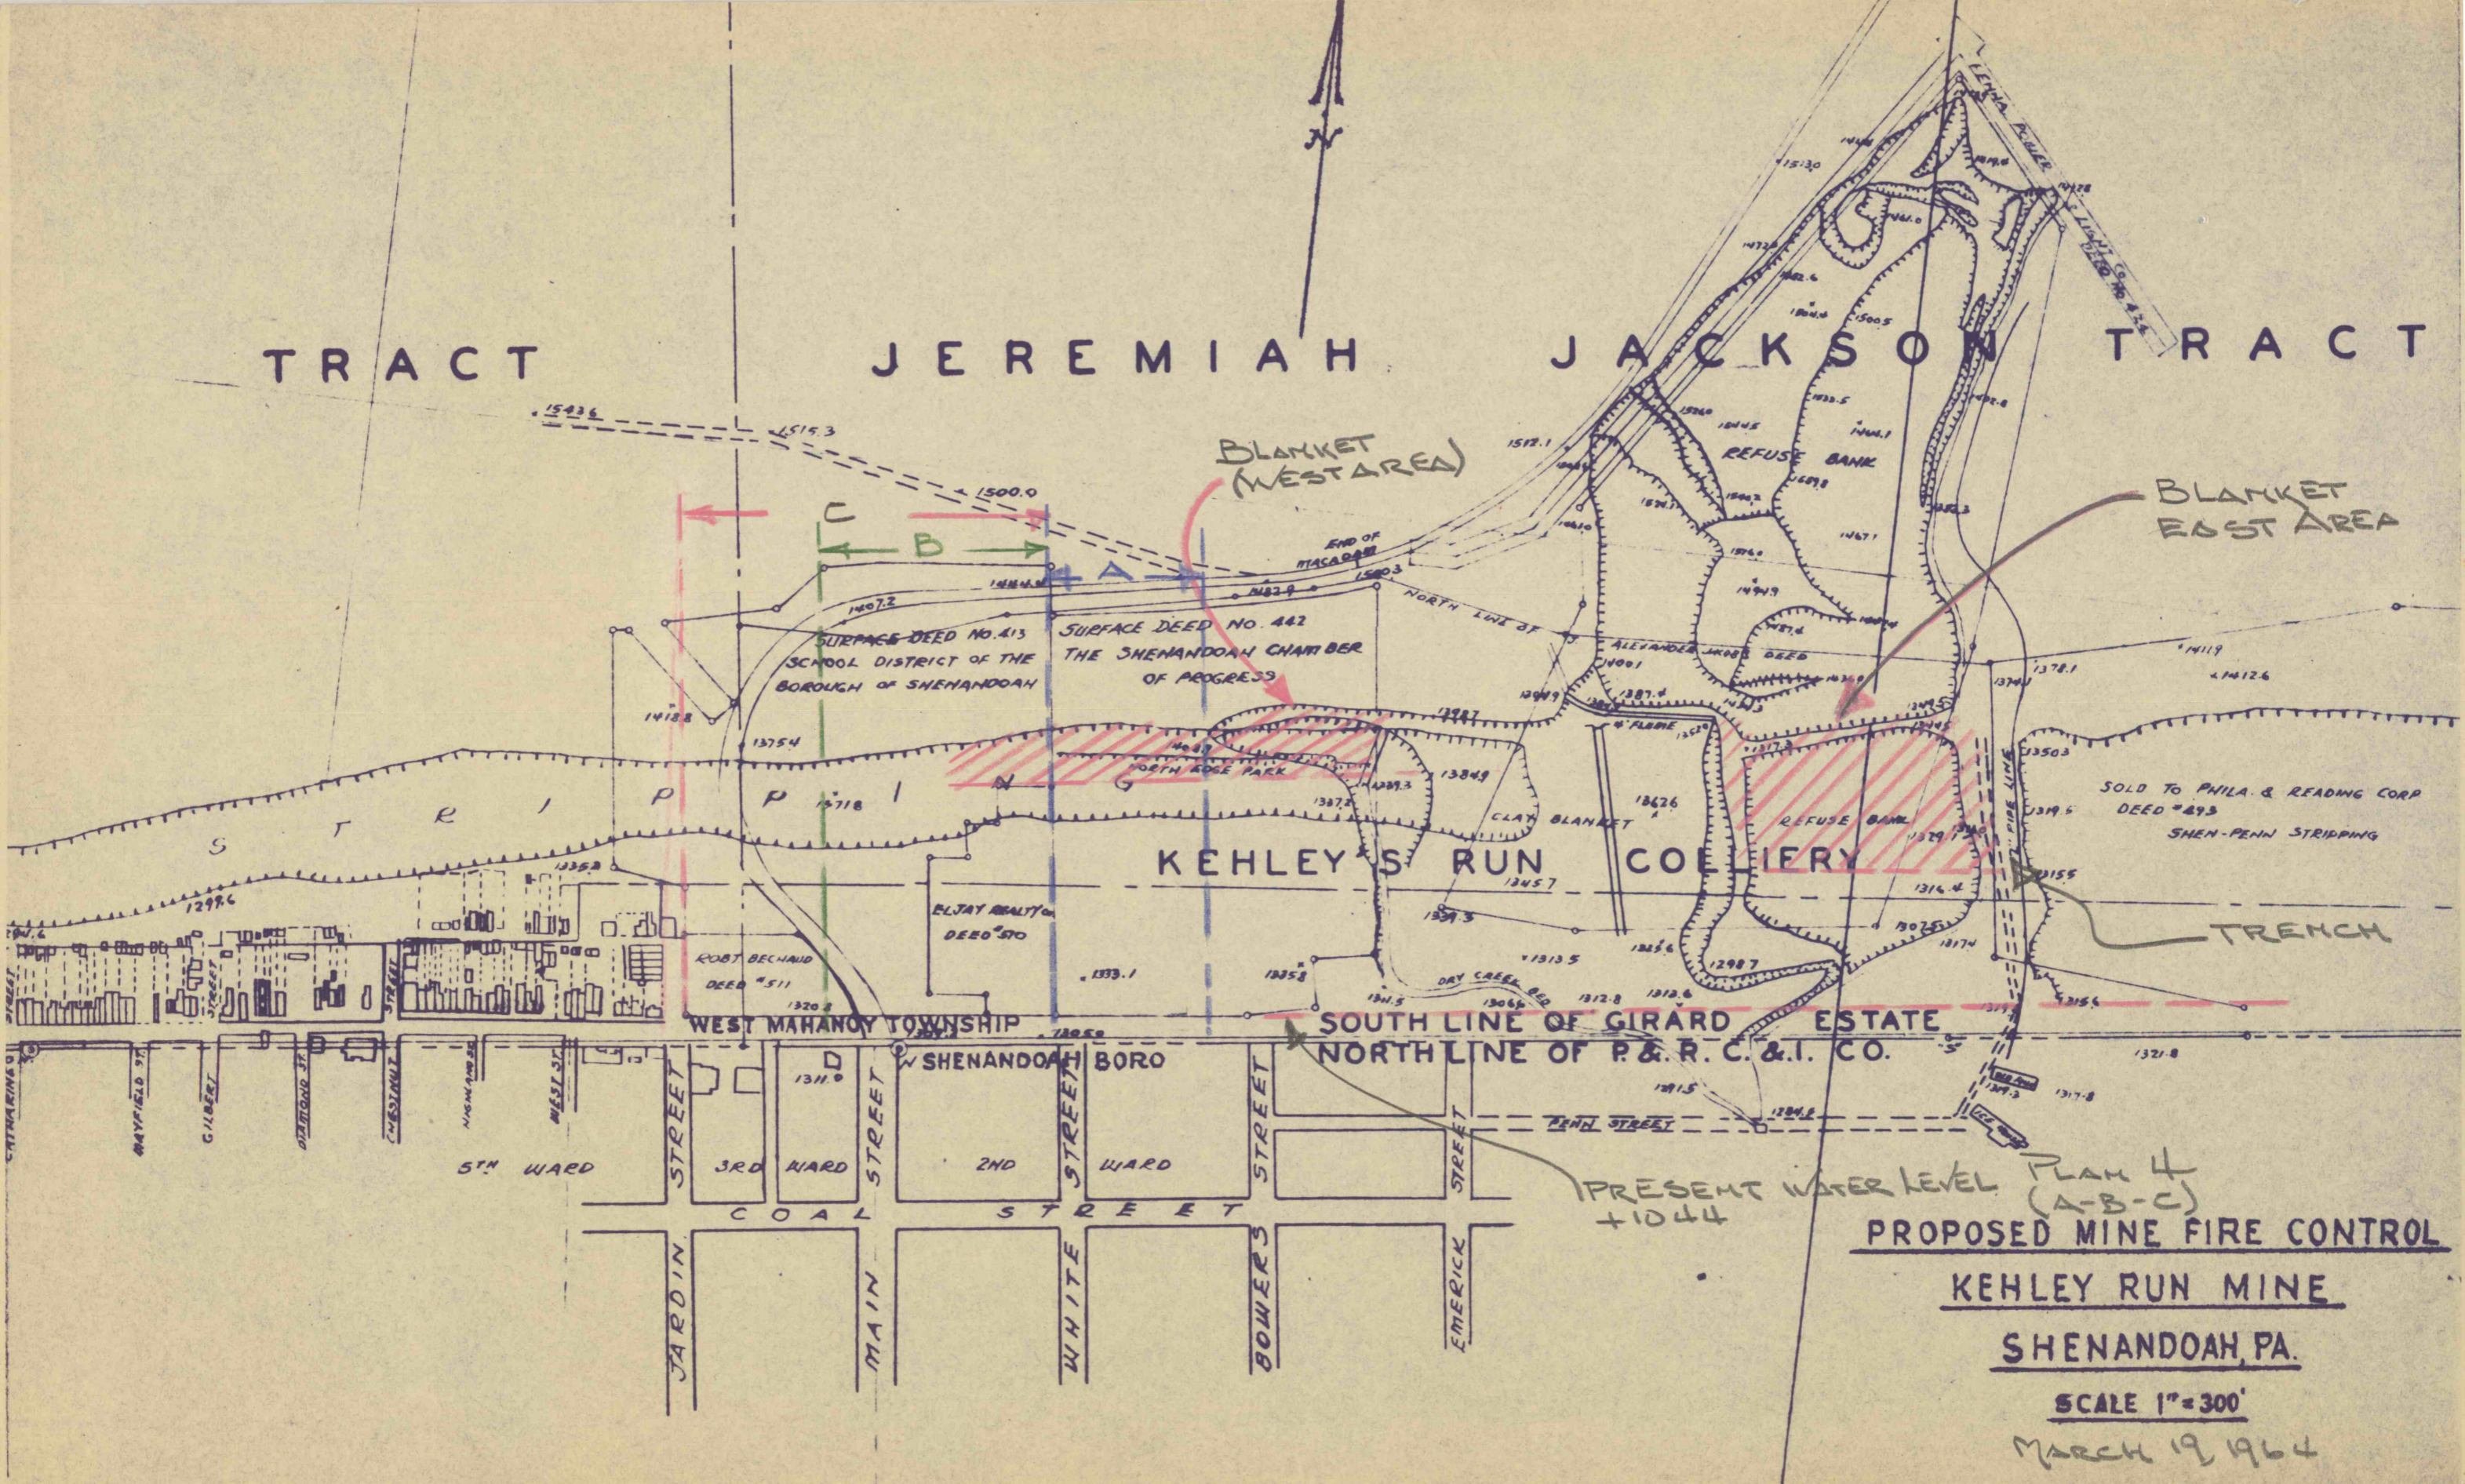

BLANKET (WEST AREA)

BLANKET EAST AREA

SURFACE DEED NO. 413
SCHOOL DISTRICT OF THE
BOROUGH OF SHENANDOAH

SURFACE DEED NO. 442
THE SHENANDOAH CHAMBER
OF PROGRESS

KEHLEY'S RUN COALERY

SOLD TO PHILA. & READING CORP
DEED # 893
SHEN-PENN STRIPPING

TRENCH

WEST MAHANOY TOWNSHIP

SOUTH LINE OF GIRARD ESTATE

NORTH LINE OF P. & R. C. & I. CO.

SHENANDOAH BORO

5TH WARD

3RD WARD

2ND WARD

WARD

PRESENT WATER LEVEL
+1044

PROPOSED MINE FIRE CONTROL

KEHLEY RUN MINE

SHENANDOAH, PA.

SCALE 1" = 300'

MARCH 19, 1964

PLAN 4
(A-B-C)