
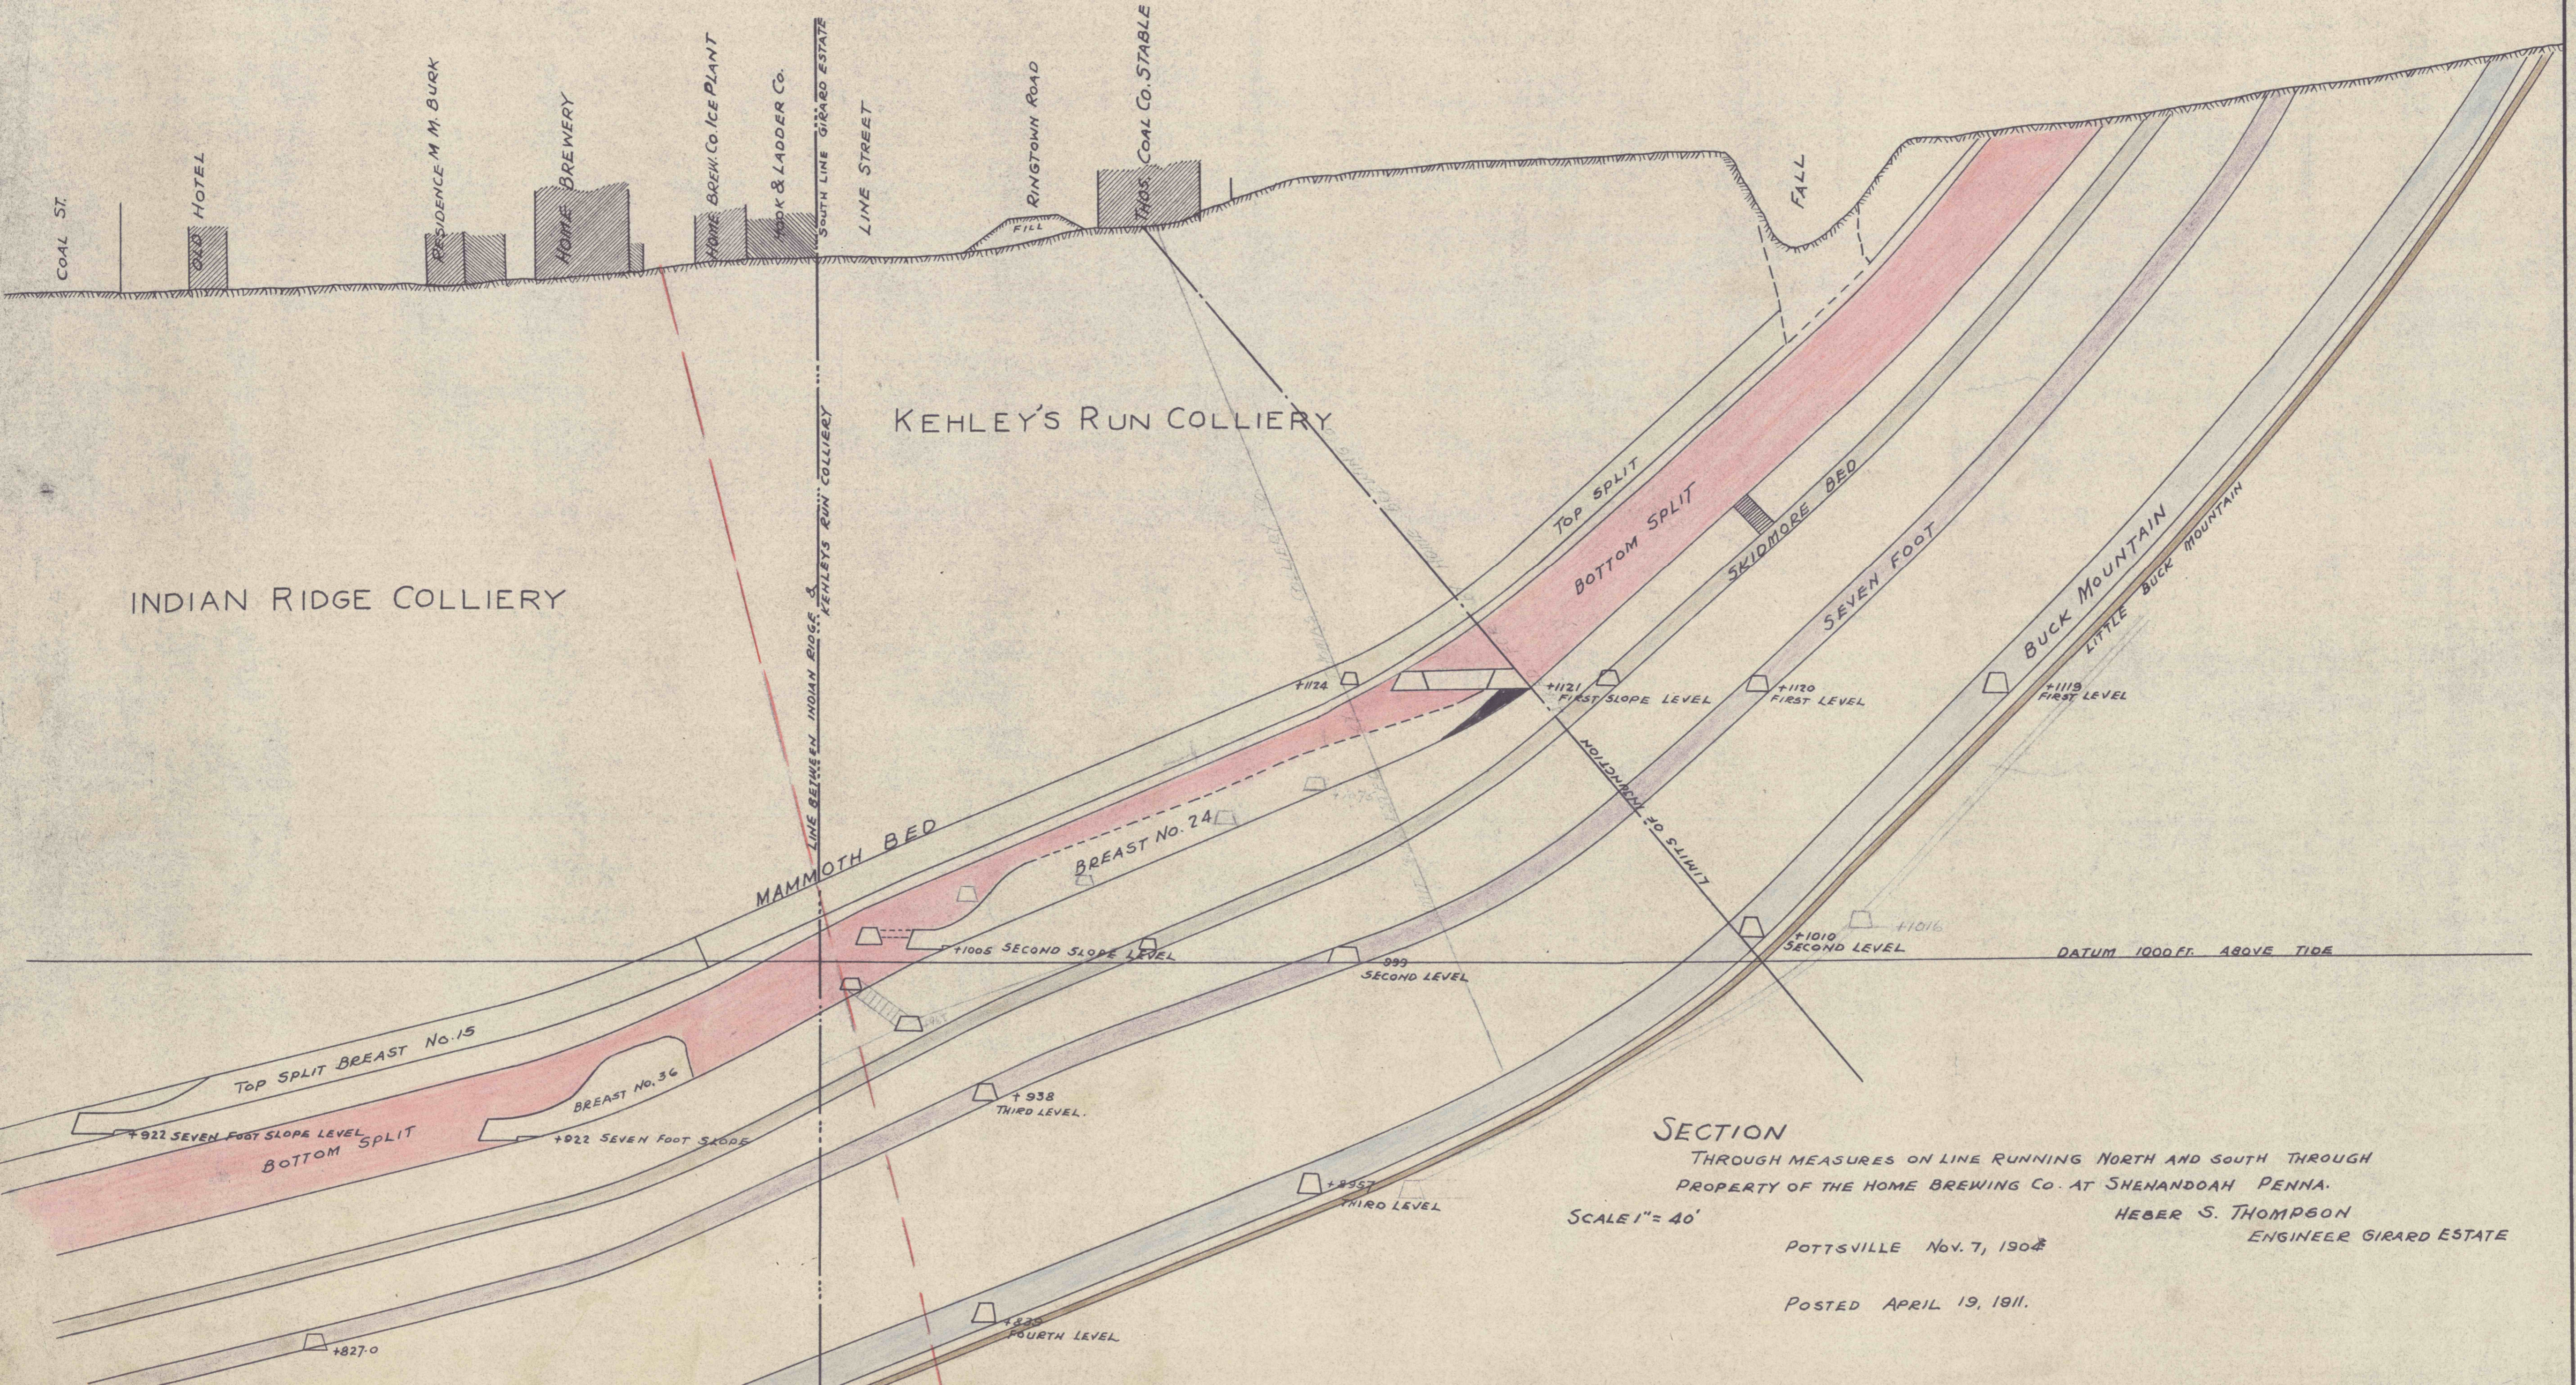


LOOKING WEST

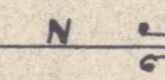

INDIAN RIDGE COLLIERY

KEHLEY'S RUN COLLIERY

SECTION

THROUGH MEASURES ON LINE RUNNING NORTH AND SOUTH THROUGH PROPERTY OF THE HOME BREWING CO. AT SHELANDOAH PENNA.

SCALE 1" = 40'

HEBER S. THOMPSON
ENGINEER GIRARD ESTATE

POTTSVILLE Nov. 7, 1904

POSTED APRIL 19, 1911.