


ROUTE 924

Owner - Surf. & Silt Dam No. 42-A  
Carbon Reserve Corp.  
Reading Anthracite Co.  
(Leased to B-D Mining Co.)

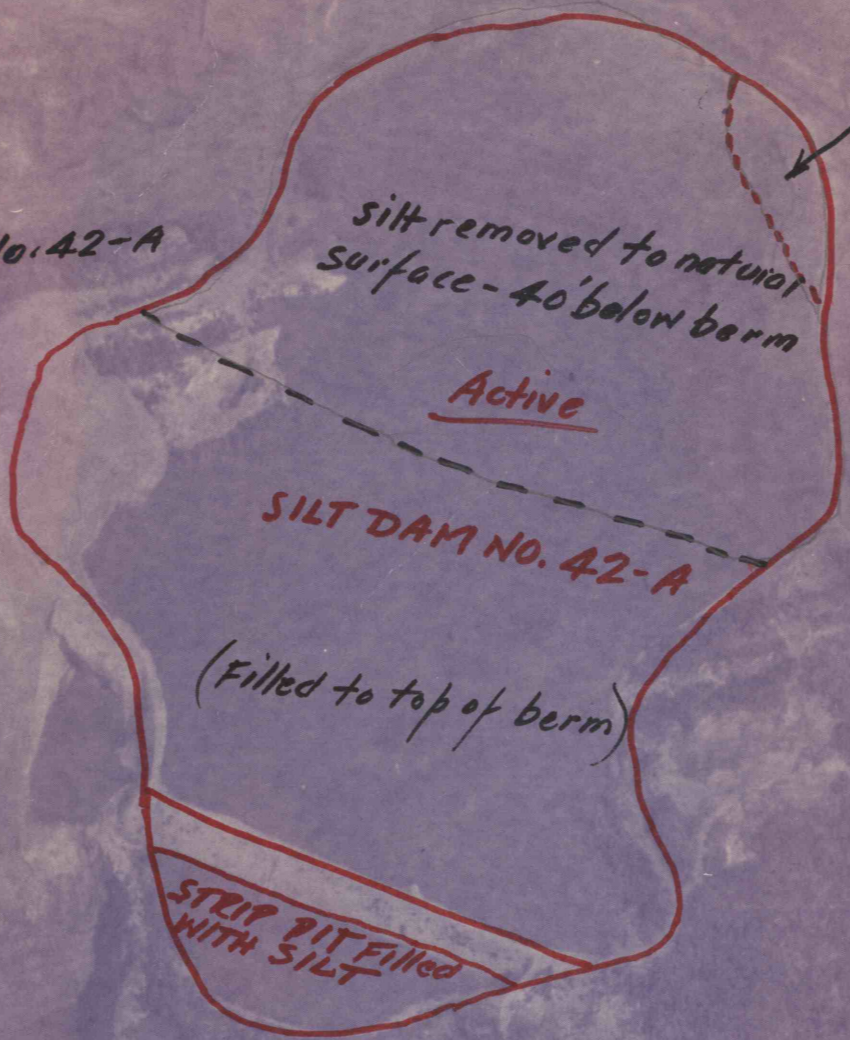

Silt piled & pushed 20' above berm - exposed to wind


St. Nicholas Elementary School

St. Nicholas Village


ROUTE 54 to Mahanoy City

B-D Fine Coal Plant

Silt has been piled 10' above the berm in this area - exposed to wind

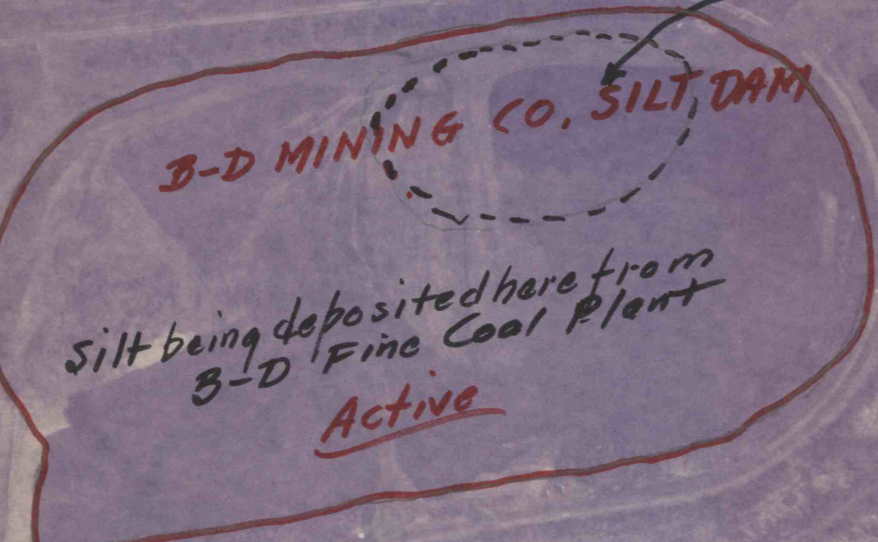

Surface & Dam Owned by B-D MINING CO.

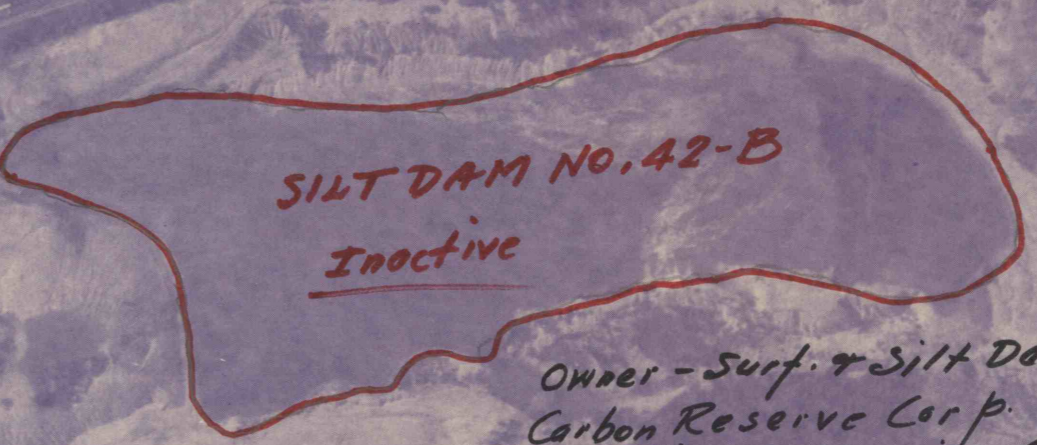

Owner - Surf. & Silt Dam  
Carbon Reserve Corp.  
Reading Anthracite Co.  
Scale - 1" = 420'

8-6-67

1602 11 818