


6-2-67

1220


ASCI:18,000

1602 10 714

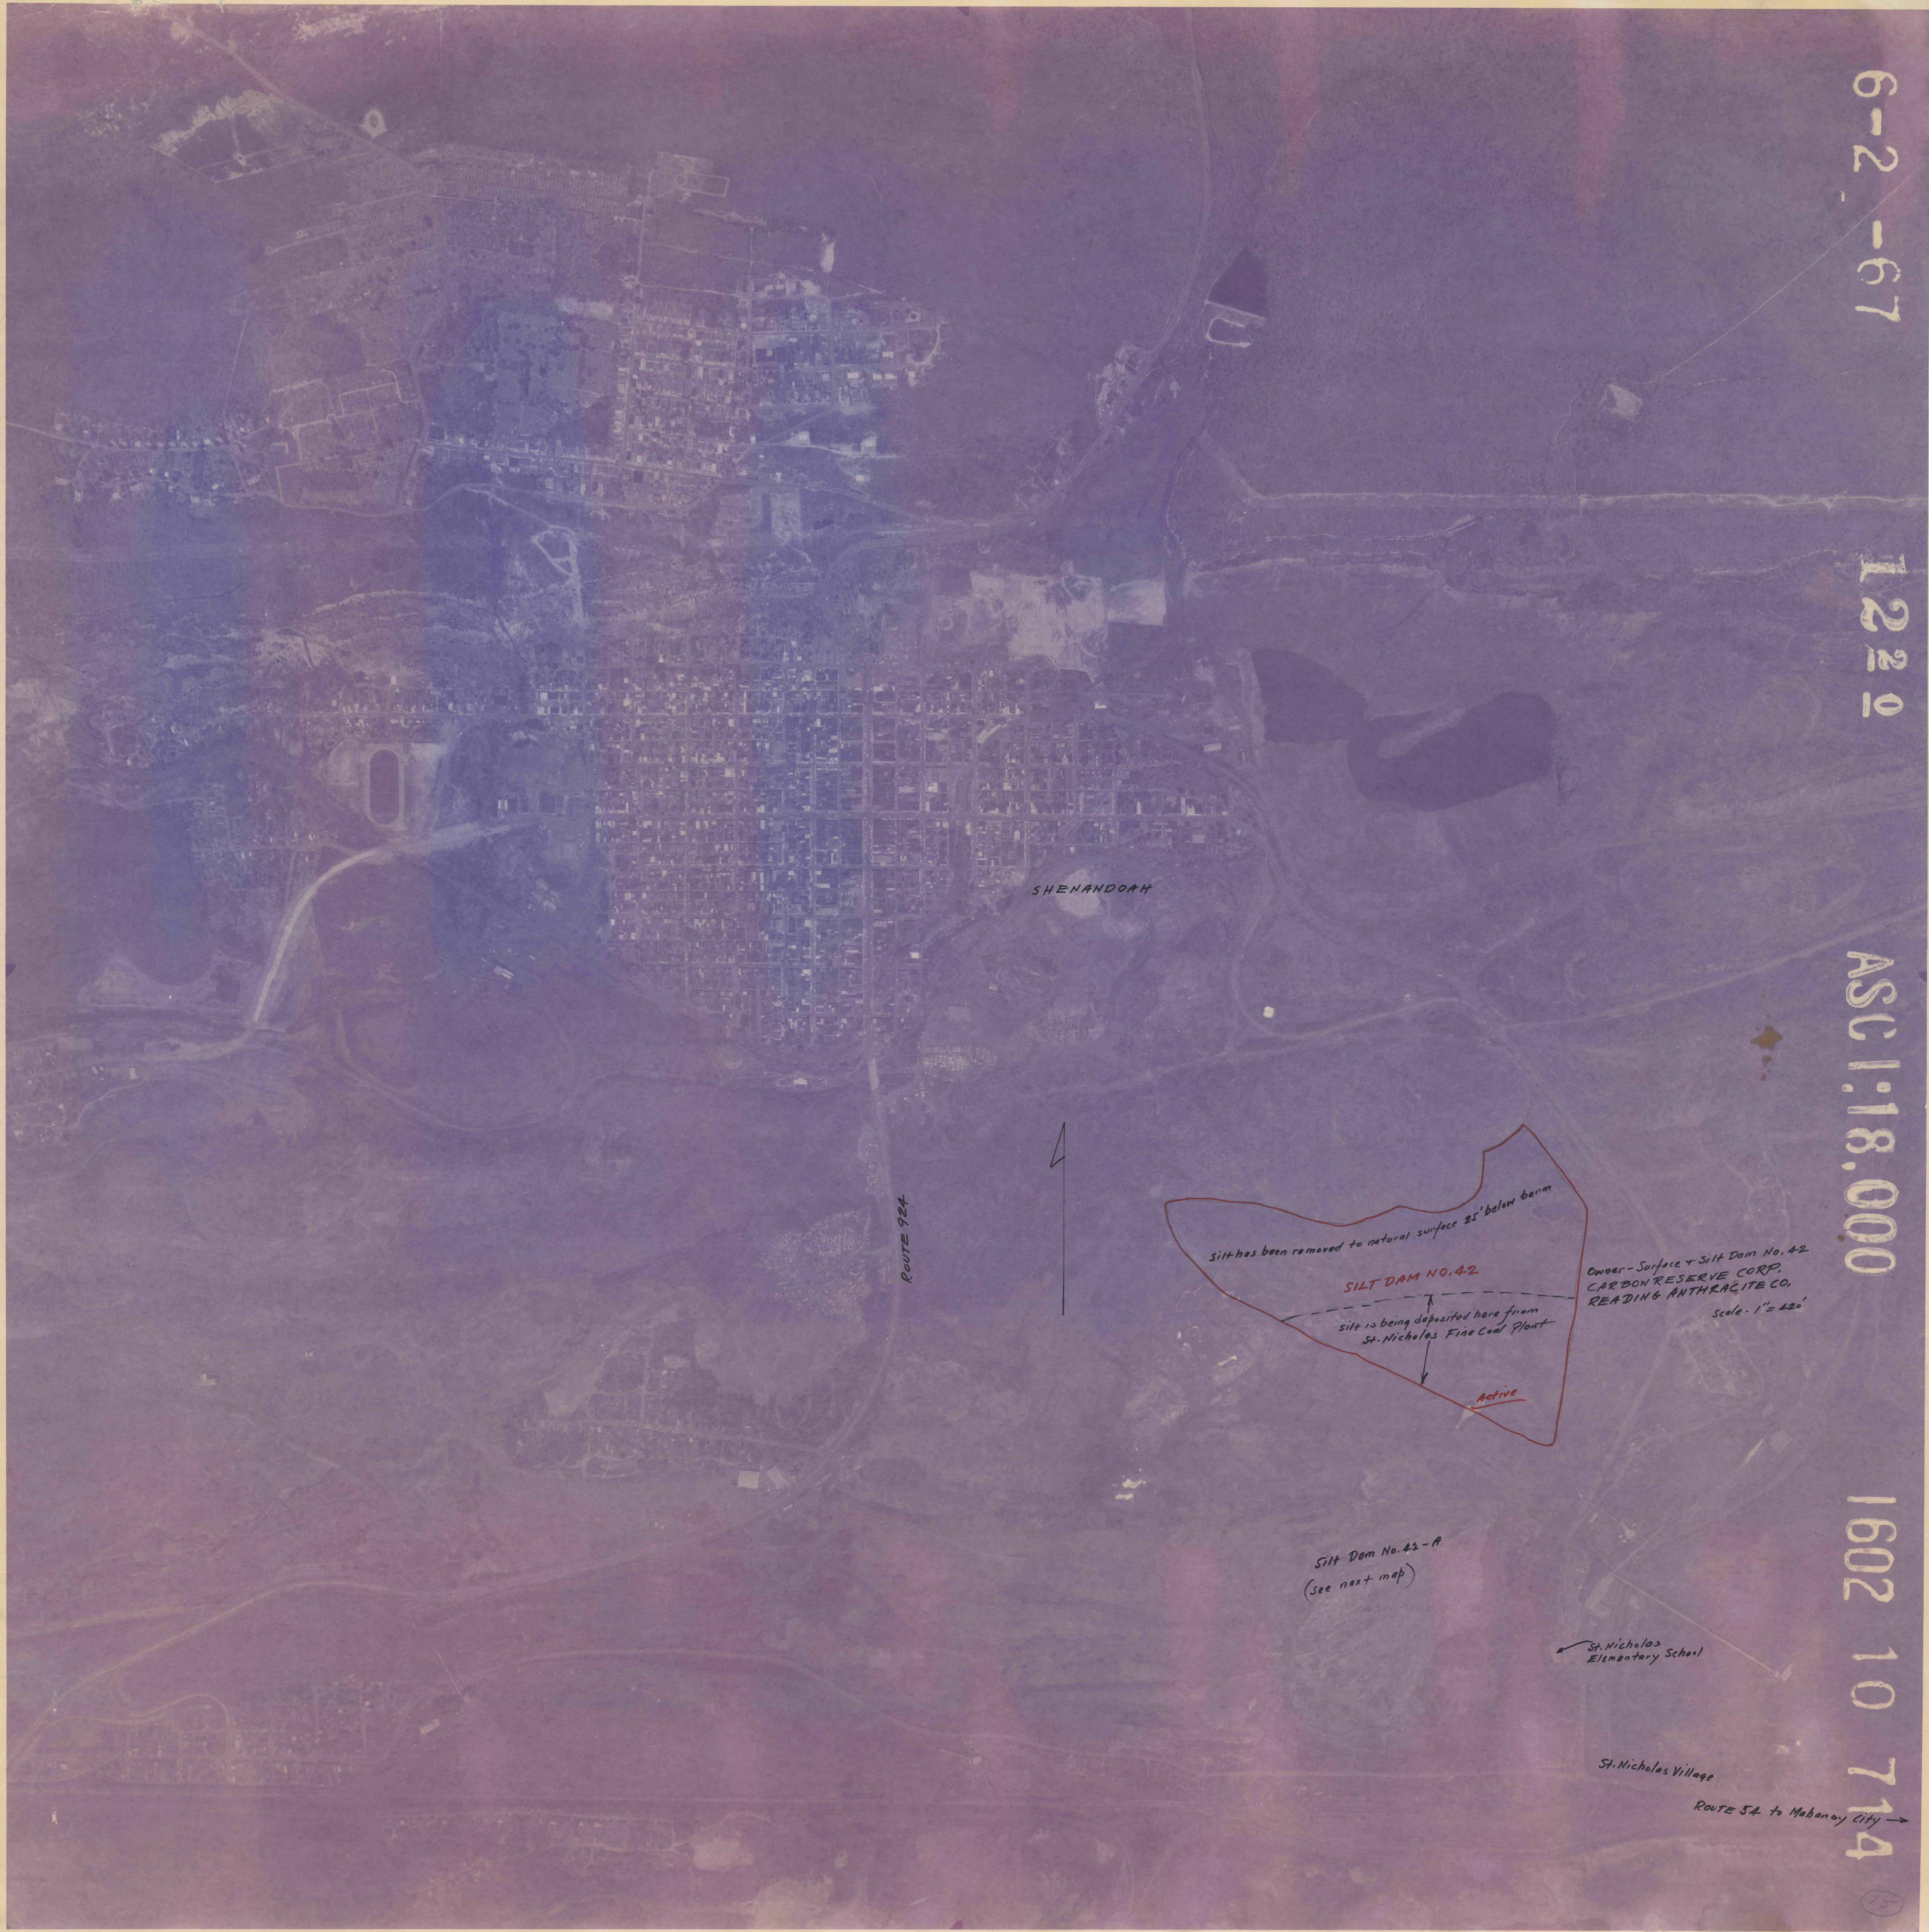

SHENANDOAH

ROUTE 924

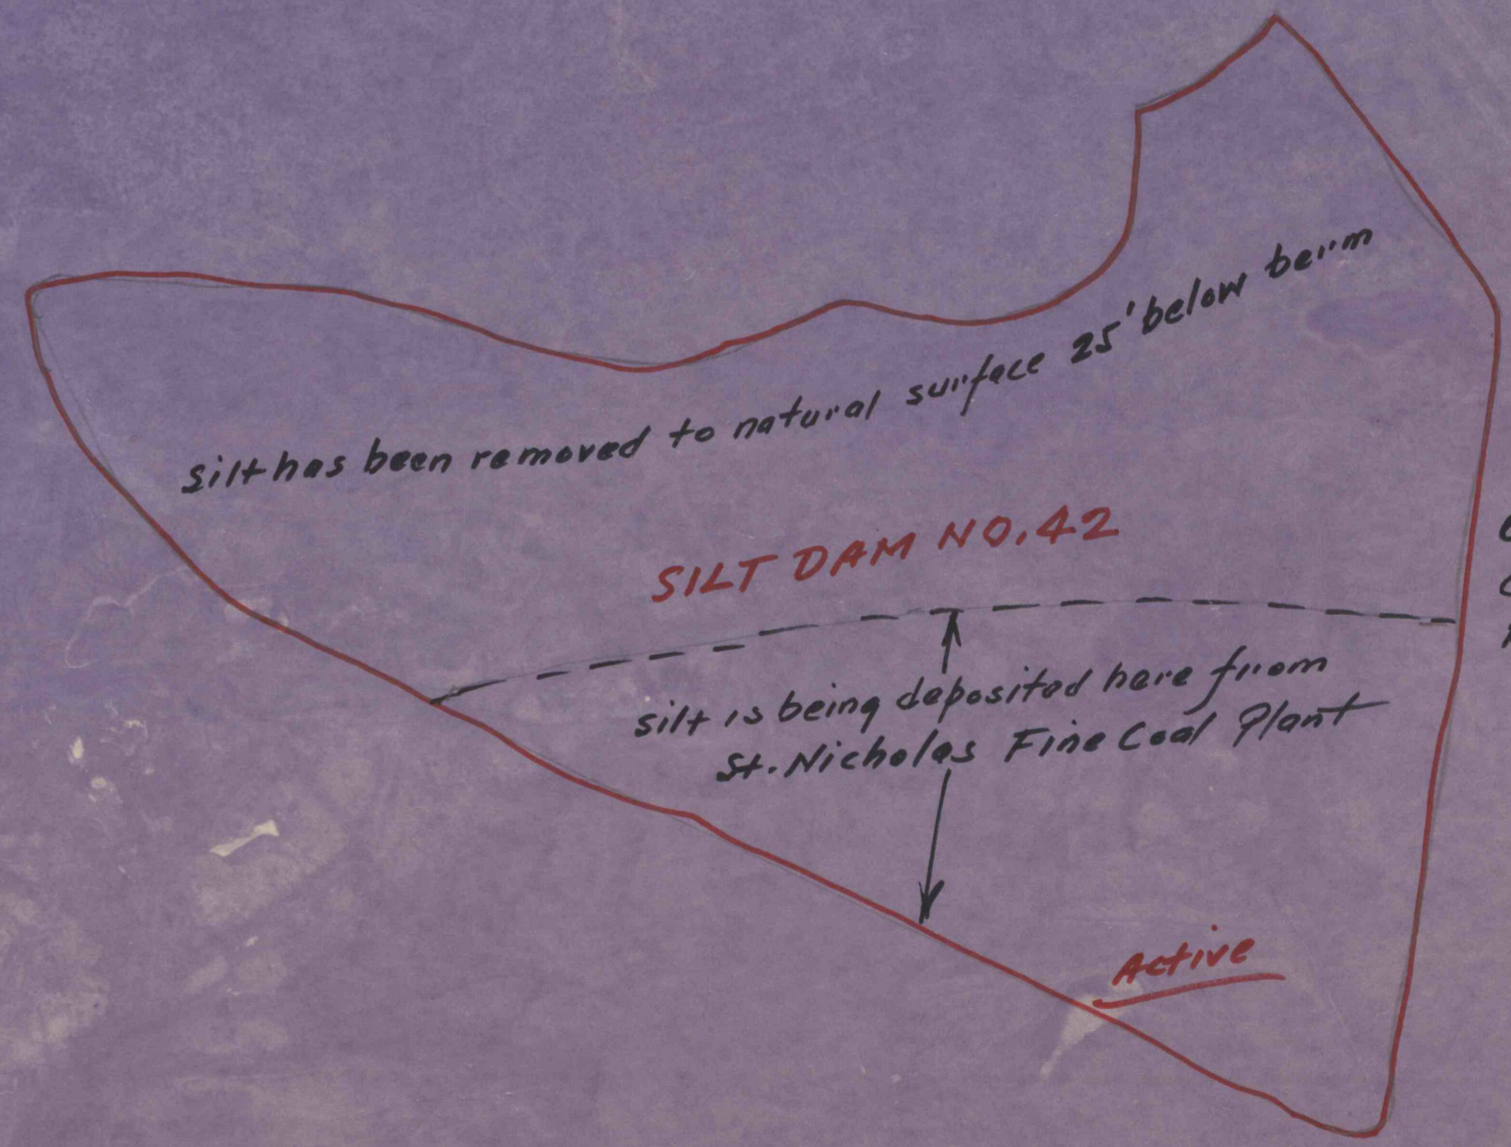

Owner - Surface + Silt Dam No. 42  
 CARBON RESERVE CORP.  
 READING ANTHRACITE CO.  
 Scale - 1" = 420'

Silt Dam No. 42-A  
 (See next map)

St. Nicholas Elementary School

St. Nicholas Village

ROUTE 54 to Mahanoy City