S-4

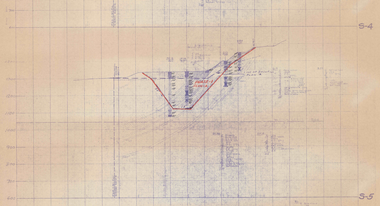

S-5

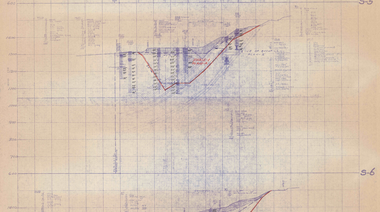

S-6

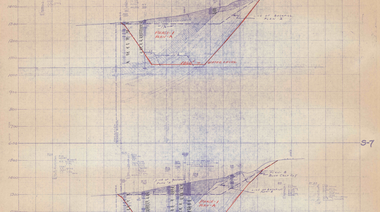

S-7

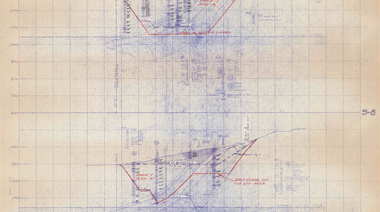

S-8

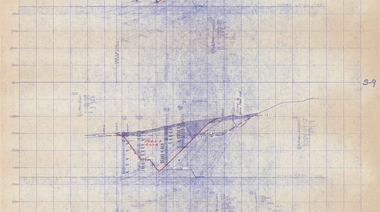

S-9

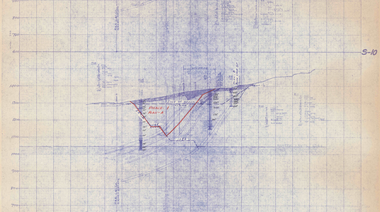

S-10

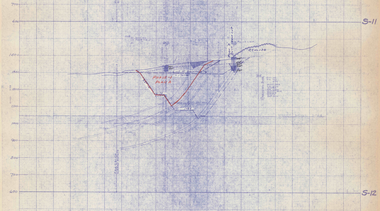

S-11

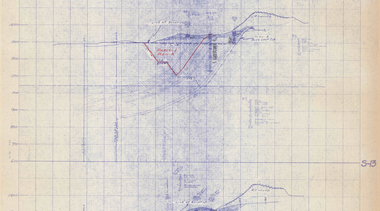

S-12

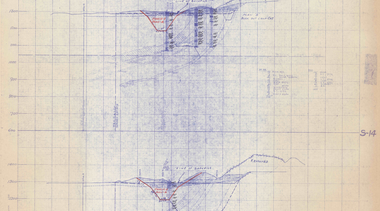

S-13

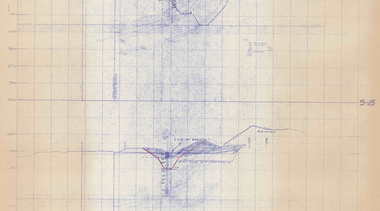

S-14

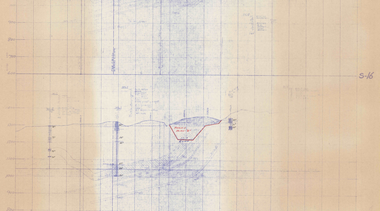

S-15

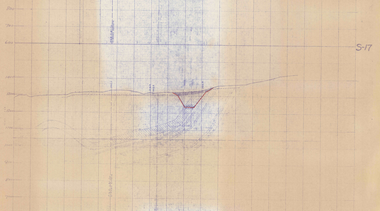

S-16

S-17

S-18