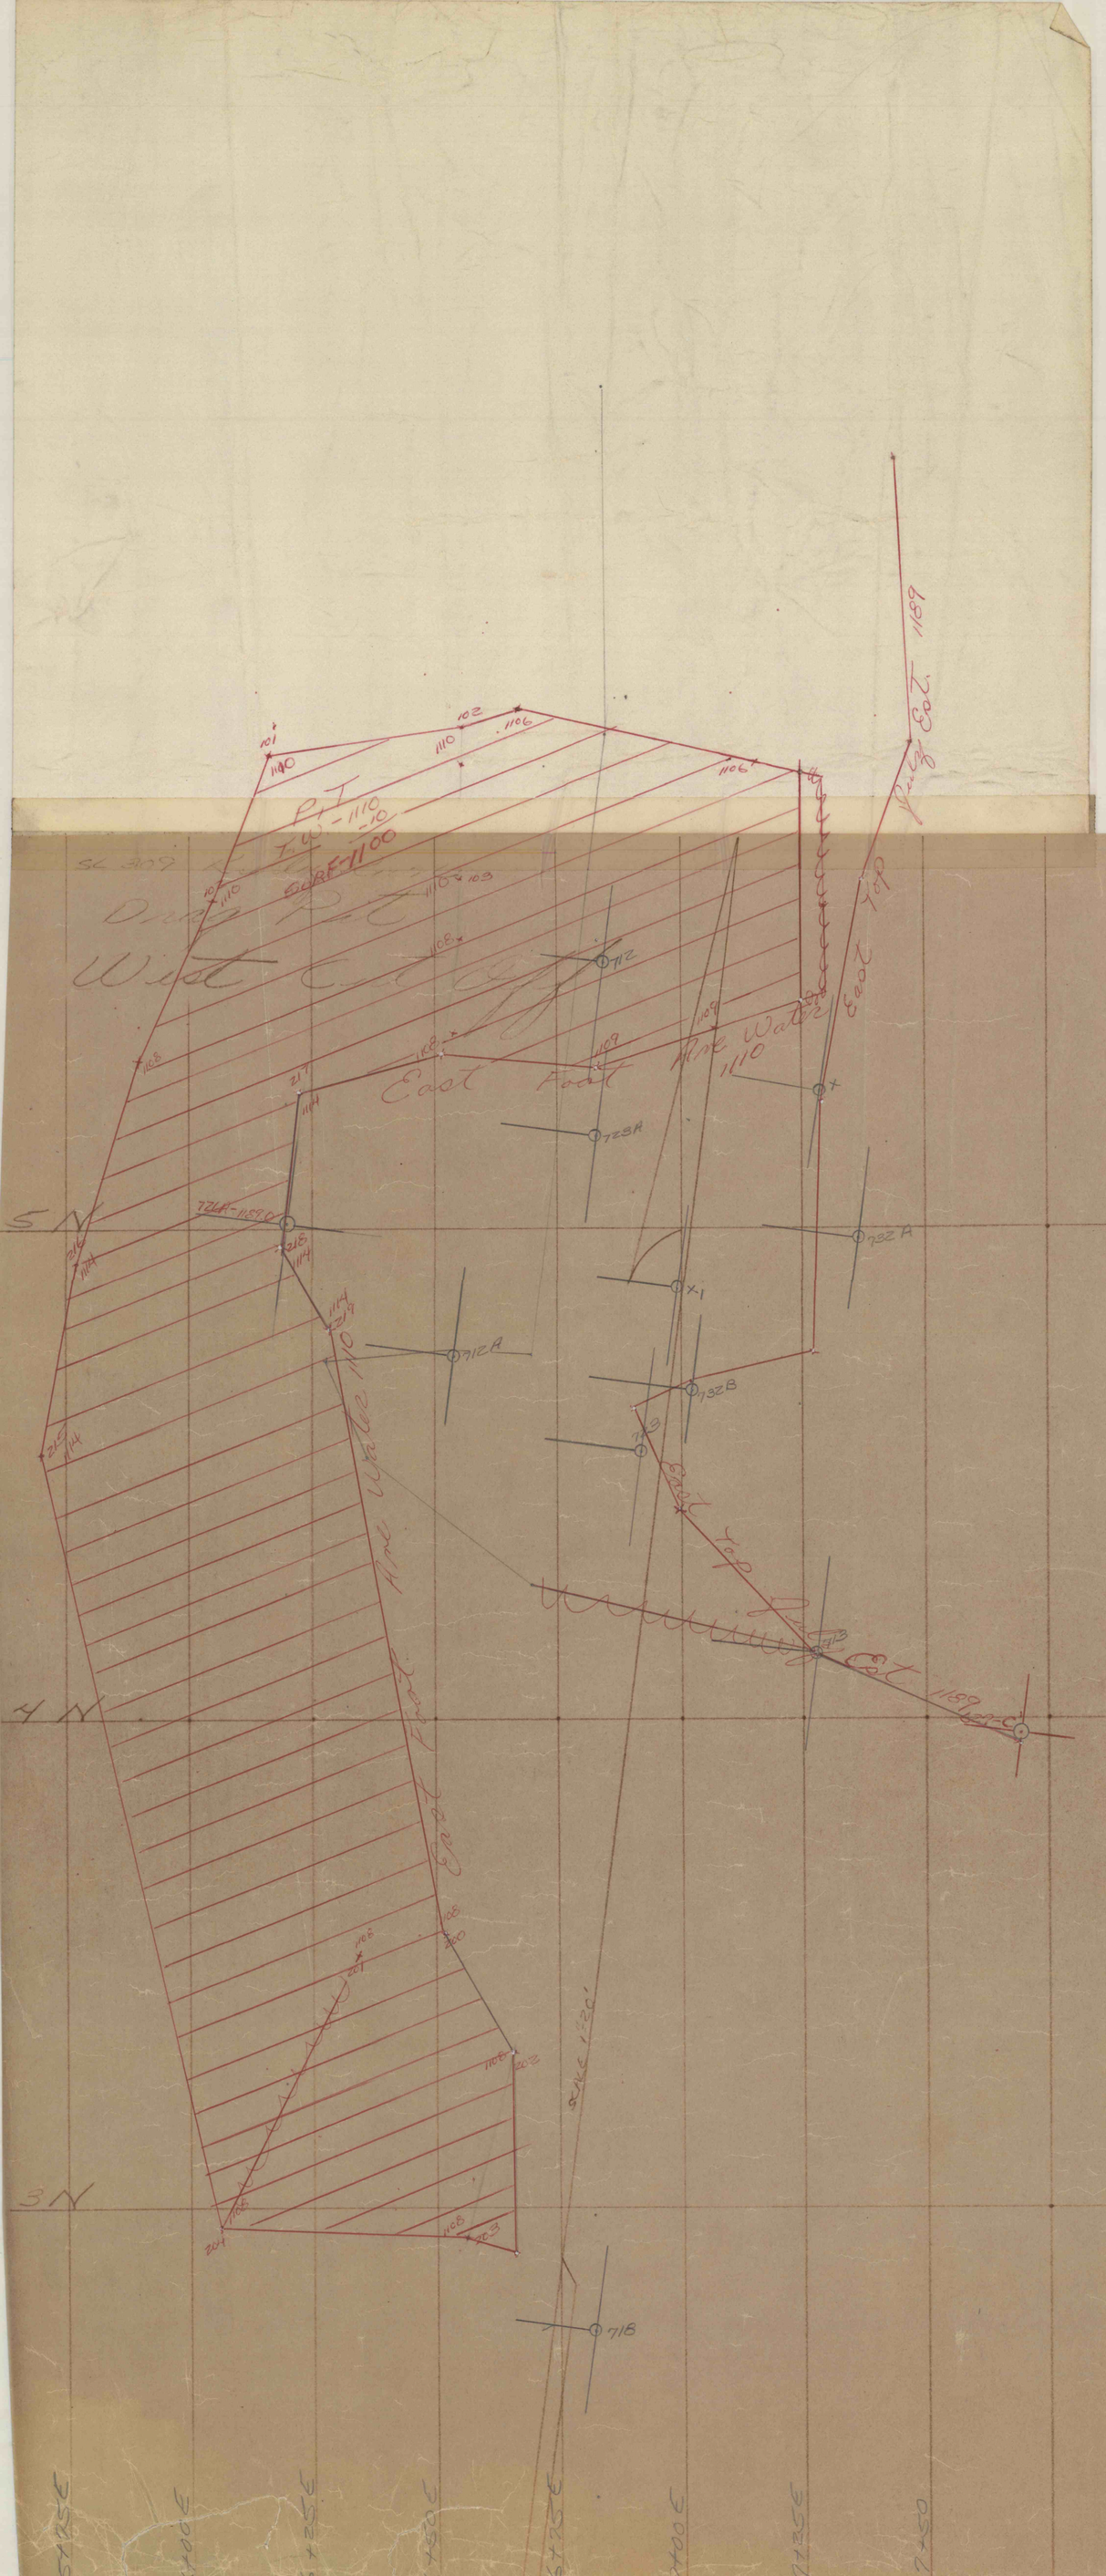
West Side Ditch
East Foot Mine Water
East Top Bank
East
SCALE 1:20'
SC 309
5 N
4 N
3 N
101
102
103
104
201
202
203
204
1100
1106
1110
1108
1114
1089
712
712A
712B
713
714
718
723A
732
732A
732B
X
X-1
F.W. 1110
-10
6+00E
6+25E
6+50E
6+75E
7+00E
7+25E
7+50