


Handwritten scribbles and marks on the left side of the page.

Handwritten notes: 7861, 871, 7451.

Handwritten note: 107-11

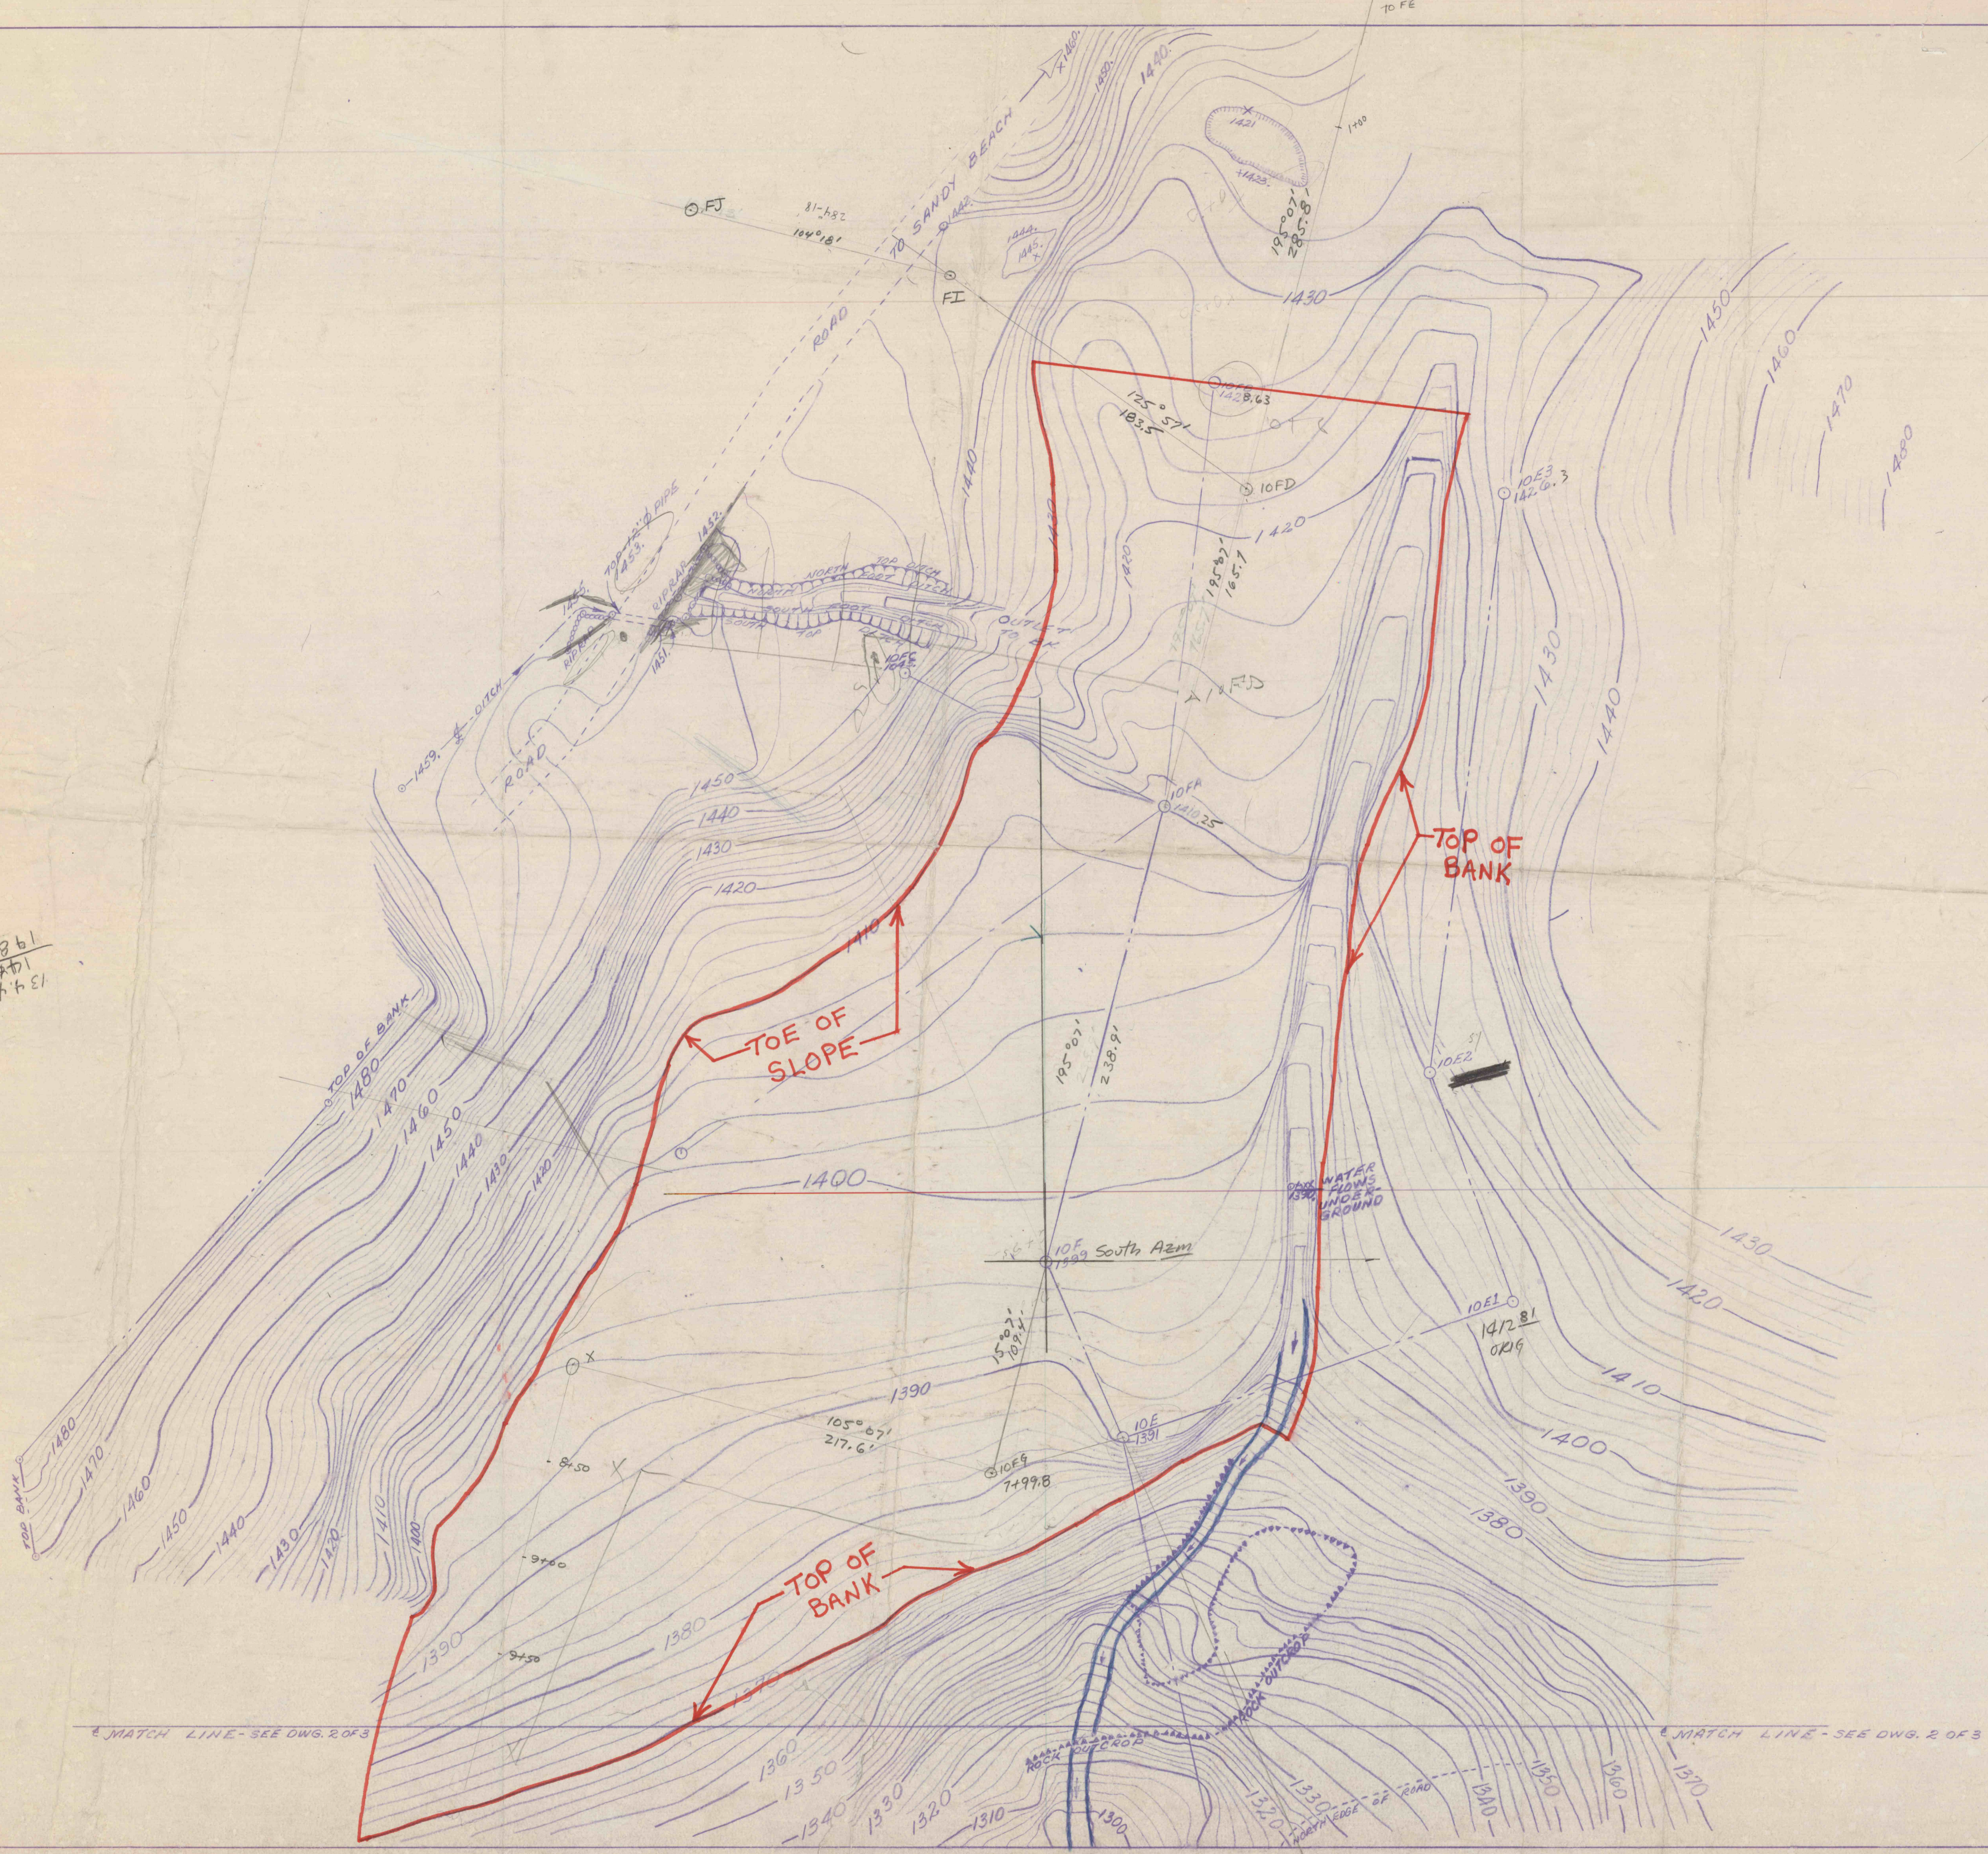

MATCH LINE - SEE DWG. 2 OF 3

MATCH LINE - SEE DWG. 2 OF 3

CONTRACT NO 5L309-2-101.2

SCALE 1" = 40'