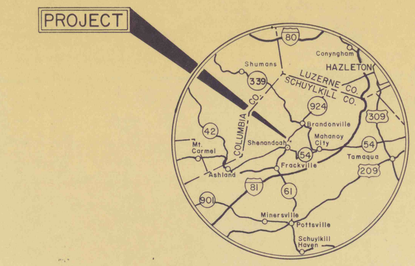

LOCATION MAP

Scale: 1 in. = 9 mi.

PROPERTY OWNERS

1. BORO. OF SHENANDOAH
2. CHAMBER OF PROGRESS OF SHENANDOAH BORO.
3. TRUSTEES OF THE ESTATE OF STEPHEN GIRARD, DECEASED, GIRARDVILLE, PA.
4. CONSOLIDATED RAIL CORPORATION

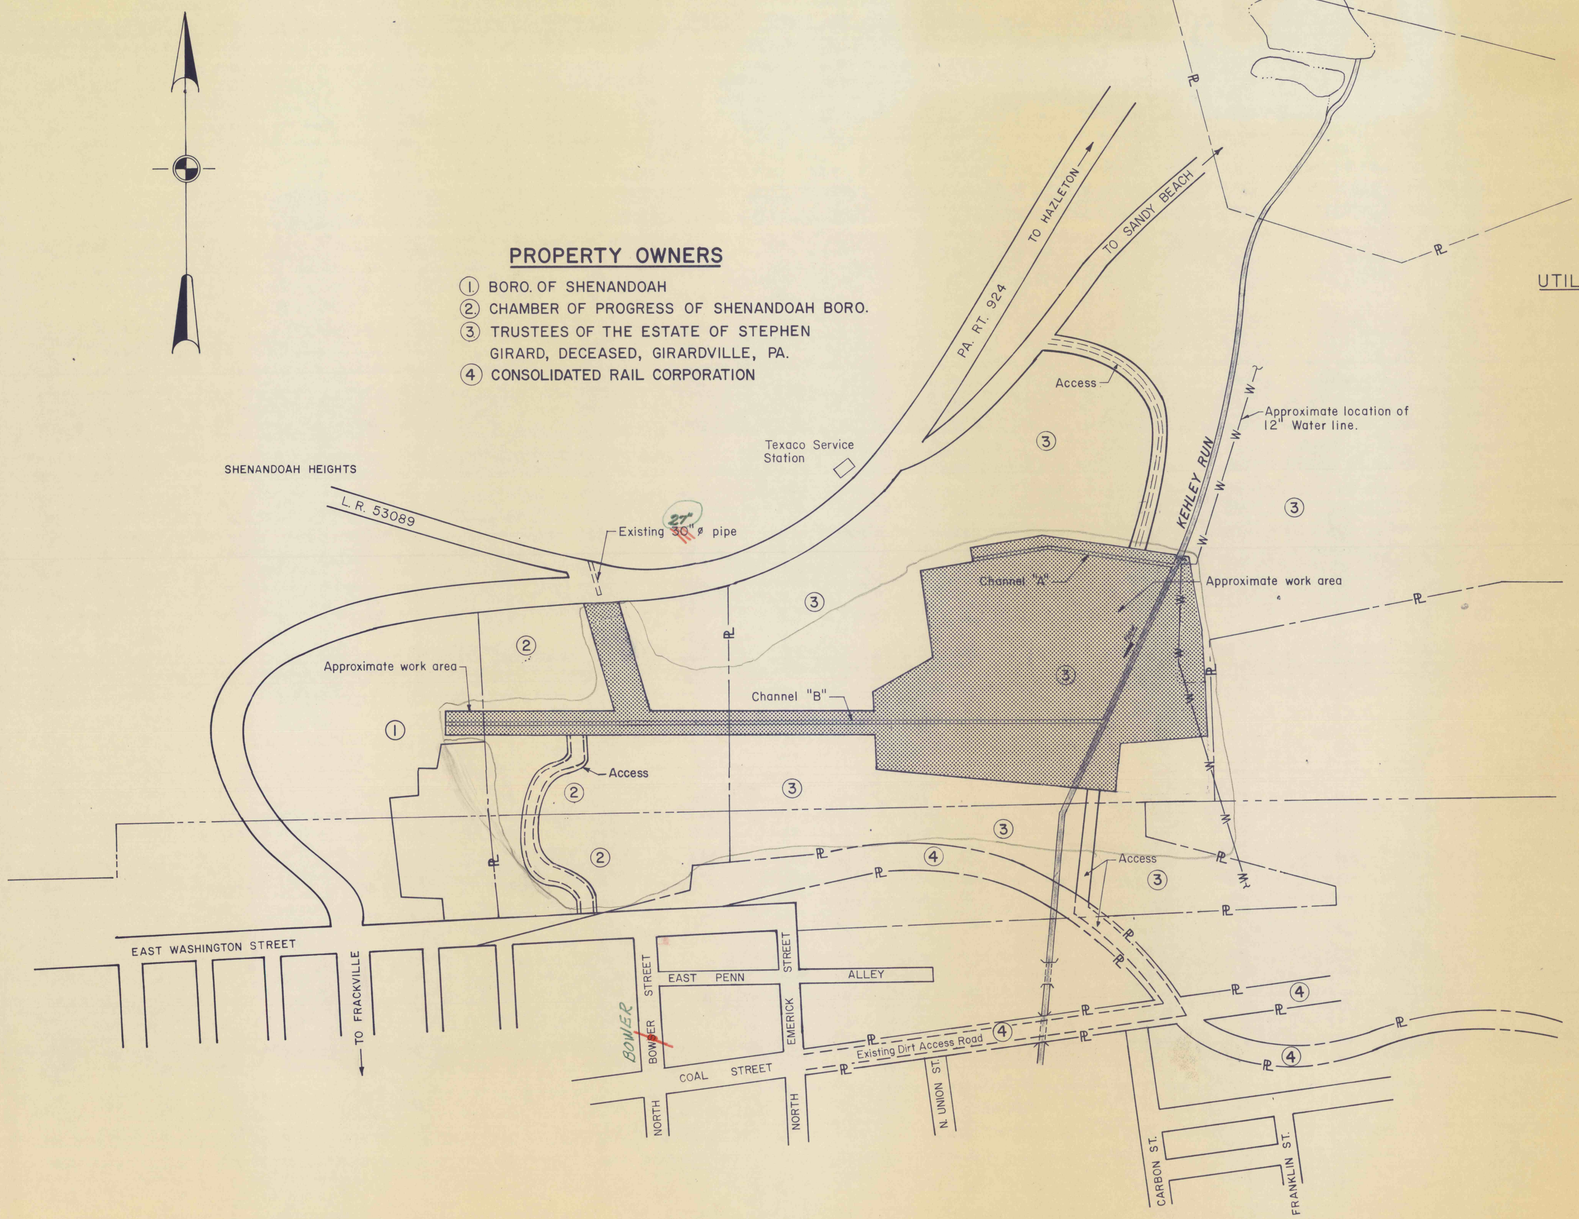

VICINITY MAP

Scale: 1 in. = 200 ft.

UTILITY INFORMATION:

The contractor shall comply with Act No. 287 of the General Assembly which defines the procedure for notification to Public Utilities prior to excavation, drilling or demolition work using powered equipment or explosives.

1. Municipal Authority of the Borough of Shenandoah.
   26-28 West Lloyd Street
   Shenandoah, Pa. 17976
   Telephone (717) 462-1904

GENERAL NOTES:

1. Topography was obtained by D.E.R.
2. Elevation of the features are to be taken from the bench marks shown on the drawings.
3. Minor adjustments in alignment and grade may be made by the Engineer to suit field conditions.
4. Limits of Grading and Revegetation as shown on the Plans and Cross Sections are approximate. Deviations may be permitted subject to the approval of the Engineer and provided that the full intent of the project is satisfied.
5. All areas disturbed by the Contractor within the Contractor's Working Area and access must be restored to at least the existing conditions.
6. Contour interval is 2 feet.
7. The contractor shall, where directed, fill and grade areas adjacent to the new construction so as to provide positive surface run-off.
8. (No.) Denotes Payment Item.

NO.	DATE	REVISION	APPR.

SUBMITTED B.K. Rao
PROJECT CO-ORDINATOR

APPROVED Edward A. Ramini
CHIEF-DIVISION OF MINE RECLAMATION

APPROVED Dan Evans
DIRECTOR-BUREAU OF DESIGN

COMMONWEALTH OF PENNSYLVANIA
DEPARTMENT OF ENVIRONMENTAL RESOURCES
OFFICE OF RESOURCES MANAGEMENT

CONTRACT NO. SL 309-2-101.1

KEHLEY RUN
MINE FIRE BANK STABILIZATION

WEST MAHANOY TWP. SCHUYLKILL CO., PA.

LOCATION AND VICINITY MAPS

DRAWN BY	DATE	DRAWING NO.
W. M. C.	1-6-80	2 of 6
CHECKED BY	SCALE	
S. R. M.	As shown	