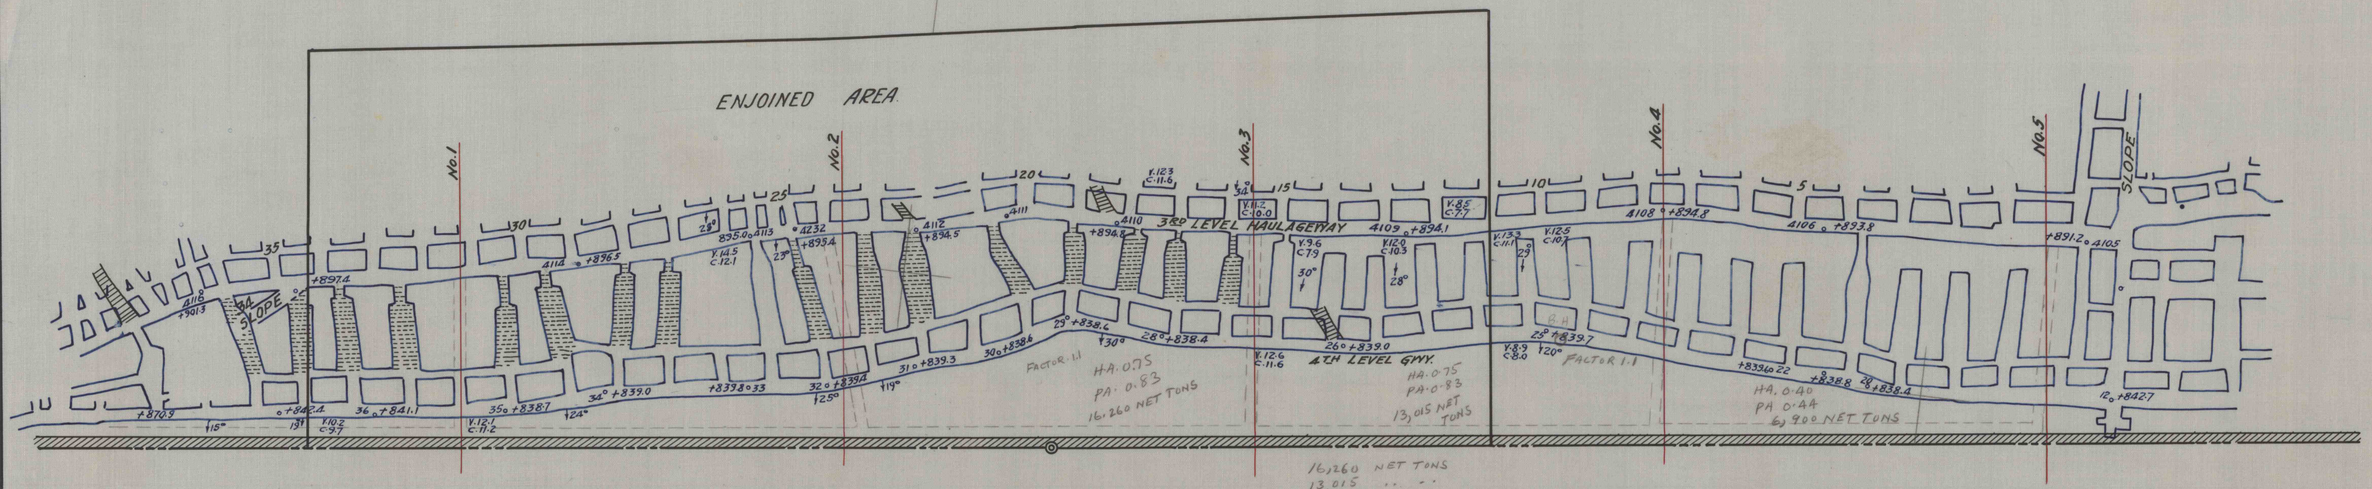
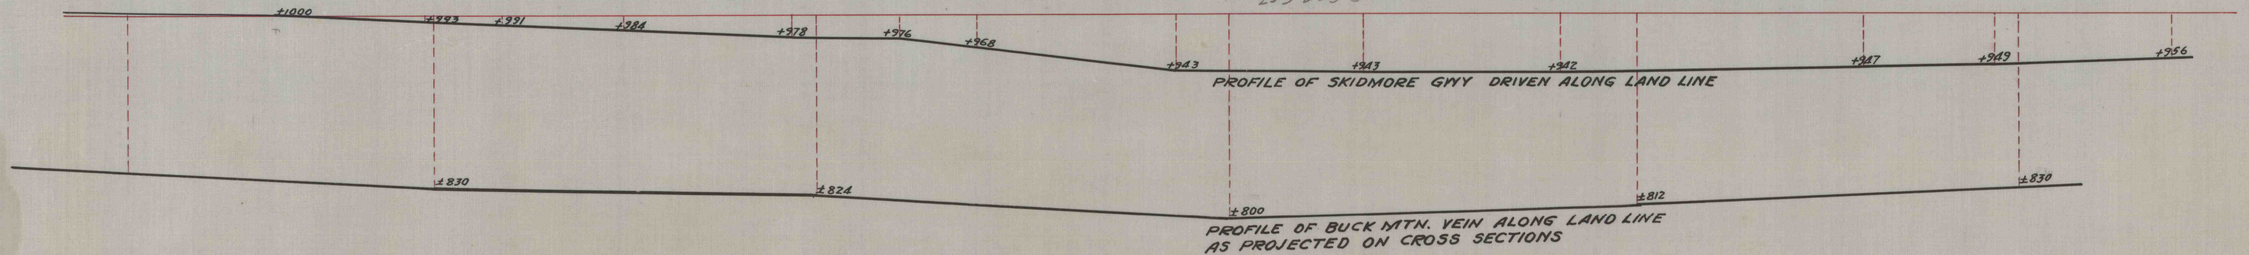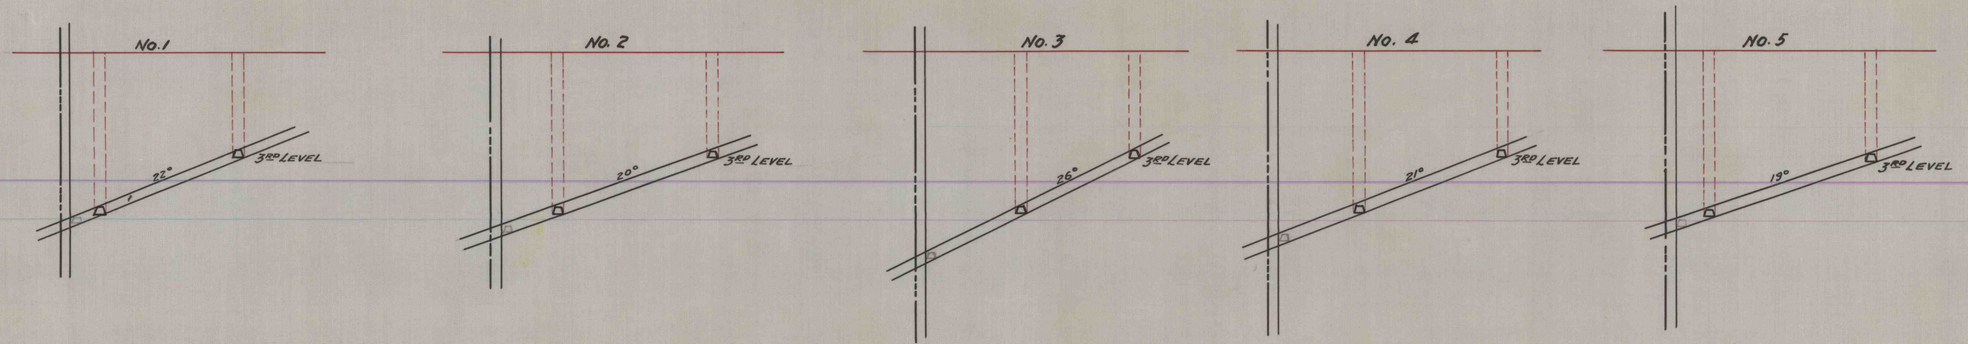
16,260 NET TONS
13,015 " "
6,900 " "
36,175 NET TONS
70 % RECOVERY
2532250