

NORTH LINE SHENANDOAH BOROUGH

NORTH LINE SHENANDOAH BOROUGH

WASHINGTON AVE.

WHITE STREET

BOWER STREET


E 19000

EMERICK STREET

PENN STREET

E 20000

PH No. 3 THROUGH MAIN HOISTING SLOPE

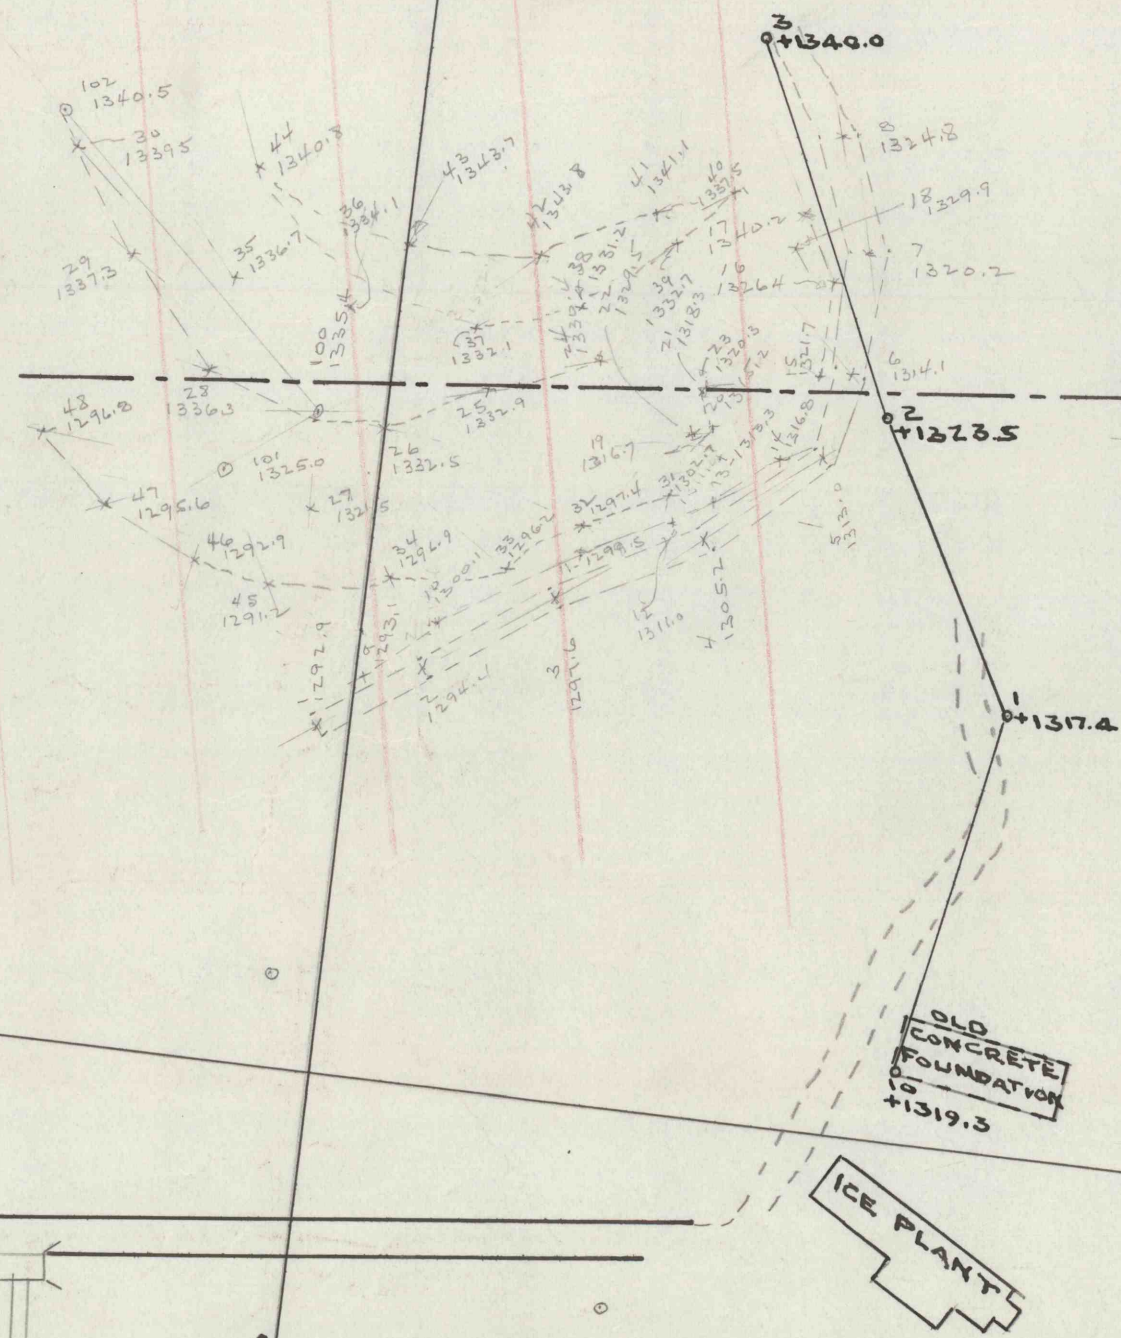

PH "D"